



TENDER ADDENDUM

Project:	UHN Interventional Fluoroscopy Replacement	Tender Addendum #:	01
	University Hospital of Northern British Columbia	DCTYA Project #:	2009
	1475 Edmonton Street,	NHA Project #:	N662050005
	Prince George, BC V2M 1S2	Issued By:	Douglas Cheung
To:	All Bidders	Issue Date:	Feb 23, 2021
Copies To:	Leah Joseph / Northern Health Authority		

The following information supplements and/or supersedes the "Issued for Tender" drawings issued for the above project dated **February 10, 2021**.

This Addendum forms part of the contract documents and is to be read, interpreted, and co-ordinated with all other parts. The cost of all contained herein is to be included in the contract sum. The following revisions supersede the information contained in the original drawings and specifications issued for the above-named project to the extent referenced and shall become part thereof.

ITEM:	DESCRIPTIONS	DWGS OR PAGES ATTACHED
1.	<p>Tender RFI-01 :</p> <p>Question –</p> <p>a. Re details on E4.01 - The Gas alarm and Master panels and those long 10c16 control cabling runs indicated, those all fall under mechanical scope of work, is that correct? Not being familiar with this type of stuff, it seems to me that this is Mechanical scope. There's also notes on the Mechanical drawings indicating they are to supply/install alarm panels. As well as Mech drawing M2-104 shows all the same work</p> <p>Response – The control wiring shown on drawing E4.01 is within the electrical scope of work. Mechanical contractor will supply and install the alarm panels.</p> <p>b. Do you happen to have a photo of SD 3A-1 and Panel E2E where we need to install new breakers? Just trying to confirm the Mfg for our supplier.</p> <p>Response – Panel SD3A-1 is an Eaton PowerLine C & Panel E2E is a Federal Pioneer NBLP.</p>	



2. Architectural :

- 2.1. A cash allowance for the following purchase is to be included in the contract:
 - a. Medical storage cabinets : \$30,000
- 2.2. For a list of bidders who attended the mandatory site visit, see attached scanned document
- 2.3. Lead Shielding Report – see attached
- 2.4. See attached Dwg A2.02 – Level 1 – Demo & Framing Plan, for revisions to wall tags, the inclusion of additional dimensions regarding the extent of existing shielding, and demolition key notes.
- 2.5. See attached Dwg A2.03 – Level 1 – Furniture, Equip. & Finishes Plan, for millwork revisions.
- 2.6. See attached Dwg A5.01 – Wall & Window Schedules, for revised wall schedule.
- 2.7. See attached Dwg A5.02 – Door hardware, Finishes & Room Schedule, for revised door hardware schedule.
- 2.8. See attached Dwg A6.01 & A6.02 – Millwork, for millwork revisions.

3. Structural :

- 3.1. See attached Structural Addendum 1 for details

4. Mechanical :

- 4.1. See attached Mechanical Addendum 1 for details

5. Electrical :

- 5.1. See attached Electrical Addendum 1 for details

Attachments :

- | | | |
|----|---|----------|
| a. | List of Bidders, dated February 18, 2021 | 1 page |
| b. | Lead Shielding Report, dated February 18, 2021 | 5 pages |
| c. | DWG A2.02 – Level 1 – Demo & Framing Plan | 1 page |
| d. | Dwg A2.03 – Level 1 – Furniture, Equip. & Finishes Plan | 1 page |
| e. | Dwg A5.02 – Door hardware, Finishes & Room Schedule | 1 page |
| f. | Structural Addendum 1 | 2 pages |
| g. | Mechanical Addendum 1 | 10 pages |
| h. | Electrical Addendum 1 | 2 pages |

END



Tender Walk-through – Bidders' List

Project: **Interventional Fluoroscopy Replacement**

Date:

Feb 18, 2021**University Hospital of Northern British
Columbia**

DCTYA Project #:

2009**1475 Edmonton Street,
Prince George, BC V2M 1S2**

NAME	COMPANY	EMAIL
MARK JOHNSON	IDC Projects	mjohnson@idcprojects.com
DALE SPEVIS	DATOFF Bros.	dale.spevis@datoff.com
Adam Meier	Vector Project group	estimating@vpq.ca
Shay Yates	Allrite Heating	shay@allriteheating.com
Mike Gallagher	All Pro Plumbing	mikeg@appph.ca
Tyler Funk	Northern Electric	tyler@northernelectrical.com
ANDRÉ DESGAGNÉ	HOULE	ANDRE.DESGAGNE@HOULE.CA
Ken Sasaki	IQ Builders Ltd	ksasaki@pqonline.com
CHAD KINSLEY	RH Sonns & Son	ckinsley@rhsonns.ca
PHIL BOWMAN	HOULE	Pbowman@HOULE.CA

TO: Leah Joseph, David Shields
UHNBC

18-Feb-2021

RE: UHNBC – New Interventional Fluoro

The shielding requirements for your New Interventional Fluoro are noted on the charts and drawings on the following pages. These requirements incorporate distances, occupancy levels of the adjacent rooms and spaces, maximum x-ray tube potential, exam workloads, and any other variables as provided and noted.

Where a barrier encompasses an entrance (designated E1, E2, etc. on the drawing), *the entrance will require a door with the same shielding capabilities as the surrounding barrier.*

Where a barrier encompasses a window (designated W1, W2, etc. on the drawing) which is typically used to separate the exposure control position from the exam room, then *the window will need to be constructed of Pb-glass or sufficient plate glass, with the same shielding capabilities as the surrounding barrier.*

For all barriers/walls, *the shielding needs to extend from the floor to a height of 2.17 meters (7 feet) above the floor* for each barrier (including the door).

A summary table describing the requirements for shielding using Pb and other materials is provided on the next page. Detailed shielding calculations for each barrier are also presented in the table and drawing on the following pages.

Should you have any questions regarding this report, please do not hesitate to contact our office, and we will be happy to assist you.

Sincerely,



Larry J Filipow, D.Phil.

Summary Table – MINIMUM Shielding

UHNBC - New Interventional Fluoro

Barrier / Wall	Required Shielding – Rolled Pb (weight in lbs)	OR: Required Shielding 5/8" Drywall Sheets	Door Shielding- Rolled Pb (weight in lbs)	Window Shielding - Equiv. Pb Thickness (mm)	Comments
Exp Con	1			0.38	See note below regarding 1 lb or odd lbs of Pb sheeting.
North	1		1		E2 in diagram. See note below regarding 1 lb or odd lbs of Pb sheeting.
East	2				
South	0		Standard steel door		E1 in diagram
West	1				See note below regarding 1 lb or odd lbs of Pb sheeting.

Contractor/Installer Information:

N.B.: Pb sheeting **MUST** be Rolled Pb, not forged or cast Pb.


Nominal Pb Weight - lbs*	1	1.5	2	2.5	3	3.5	3.75	4	5	6	8
Pb Thickness (mm)	0.40	0.60	0.79	1.00	1.19	1.39	1.50	1.58	1.98	2.38	3.17
Pb Thickness (inches)	1/64	3/128	1/32	5/128	3/64	7/128	15/256	1/16	5/64	3/32	1/8
Actual weight – lbs/square foot	0.92	1.38	1.85	2.31	2.76	3.22	3.48	3.69	4.6	5.53	7.38
Actual weight – kg/square meter	4.5	6.8	9.1	11.3	13.5	15.8	17	18.1	22.5	27.1	36.2

Typically, rolled Pb sheeting is sold in units of 1 pound (i.e.: 1, 2, 3, 4 lbs, etc.)

Most contractors find **1 lb Pb** thickness difficult to work with as the sheets are very flimsy and tear easily. **Odd lbs of Pb** are hard to source and are relatively expensive. Consequently, contractors often install 2 lb, 4 lb, or multiples of 2 lb Pb sheeting instead. This is perfectly acceptable - you can always shield more than what is called for.

Assumptions and references used in calculating shielding requirements:


1. All calculations and assumptions (except where noted below) based on protocols provided in **NCRP Report 147: Structural Shielding Design for Medical X-Ray Imaging Facilities**.
2. Only DI Staff are assumed to be Atomic Energy Workers; therefore design goals for all other occupied areas were deemed to be the same as for the general public, (i.e. P= 0.02 mGy/week maximum allowed exposure).
3. 0.3 meters added to all patient-barrier distances measured and calculated from layout drawings.
4. Pre-shielding (Grid, Image Receptor, Support) values for wall stand and cross table grid/cassette holders were utilized (where applicable).

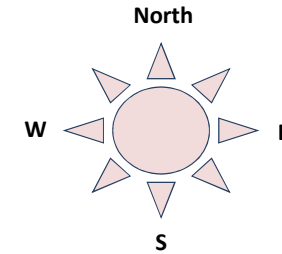

Staff Work (Fluoroscopy)

W1 is a window that will require **0.4 mm Pb** equivalent shielding.

N.B.: Diagram depicts **minimum** shielding requirements (you can always shield more).

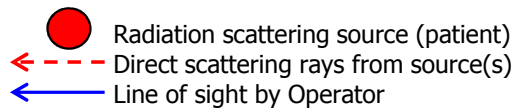

	1 lb rolled Pb	2 lb rolled Pb	3 lb rolled Pb	4 lb rolled Pb	5 lb rolled Pb	6 lb rolled Pb	8 lb rolled Pb
Barrier							
Door							
Window							

Detail - UHNBC - New Interventional Fluoro					Maximum Number of Patients per Week: 25
Exposure Control	Barrier				Maximum Workload: 376 mA-min/week
	North Barrier	East Barrier	South Barrier	West Barrier	Maximum kVp used: Fluoro tube RF Room
Controlled	Uncontrolled	Uncontrolled	Uncontrolled	Uncontrolled	Adjacent Space - Controlled areas: Radiation Workers; Uncontrolled areas: General Public
1.00	0.20	1.00	0.03	0.20	Adjacent Space - Occupancy Factor
N/A	N/A	N/A	N/A	N/A	Tube - Barrier distance in meters (only for Primary Beam configuration)
2.6	3.0	4.1	4.7	3.7	Patient - barrier distance in meters (for Scatter Radiation assessment)
0.00	0.00	0.00	0.00	0.00	Barrier Primary Beam Usage Factor
Total* Radiation Barrier Shielding required:					
0.38	0.32	0.59	0.00	0.24	mm Pb
1.0	1.0	2.0	0.0	1.0	Minimum nominal weight of Pb required (lbs)
33	28	48	0	23	or mm Concrete (standard density = 2.4 gm/cc)
104	88	154	0	69	or mm Drywall (1/2" sheet drywall = 11 mm; 5/8" sheet = 14 mm of shielding material)

* Includes Primary, Scattered, and Leakage Radiation contribution.

Recommendation / Requirement

Exposure Control	North Barrier	East Barrier	South Barrier	West Barrier	Shielding Material:
1 lbs rolled Pb	1 lbs rolled Pb	2 lbs rolled Pb	None required	1 lbs rolled Pb	Rolled Pb sheeting in weights shown
N/A	N/A	N/A	1	5	OR: Drywall (5/8" sheets) in quantities shown

Physics Values Used

Barrier	Input	Description	Symbol	Units
	25	Number of patients per week	N	per week
EC	1.00	Occupancy Factor	T	
N	0.20			
E	1.00			
S	0.03			
W	0.20			
EC	0.10	Design Goal	P	mGy/Week
N	0.02			
E	0.02			
S	0.02			
W	0.02			
EC	0.00	Primary beam Use factor (per barrier)	U	
N	0.00			
E	0.00			
S	0.00			
W	0.00			
EC		Air Kerma for Primary radiation @ 1 m	Kp	mGy/patient
N				
E				
S				
W				
EC		Distance from tube to barrier	dp	m
N				
E				
S				
W				
EC		Pre-shielding (IR's, grids, supports)	xpre	mm
N				
E				
S				
W				
EC	0.46000	Air Kerma for Secondary radiation @ 1 m	Ksec	mGy/patient
N	0.46000			
E	0.46000			
S	0.46000			
W	0.46000			
EC	2.6	Distance from patient to barrier	dsec	m
N	3.0			
E	4.1			
S	4.7			
W	3.7			



- | | |
|-----|---|
| D09 | EXISTING WALL MOUNTED WHITE BOARD OR CORKBOARD TO BE RELOCATED. DO NOT DAMAGE. |
| D10 | EXISTING WALL MOUNTED HAND SANITIZER & WD BACKING TO BE REMOVED. |
| D11 | EX WALL MOUNTED SINK, WD BACKING AND ACCESS PANEL TO BE REMOVED - SEE MECH DWGS. |
| D12 | EXISTING WALL MOUNTED SOAP DISPENSER & WD BACKING TO BE REMOVED. |
| D13 | EXISTING WALL MOUNTED PAPER TOWEL DISPENSER TO BE REMOVED. |
| D14 | EXISTING WALL MOUNTED ACQUITY GLOVE DISPENSER (2 TOTAL) TO BE REMOVED AND PASSED ONTO HOSPITAL FOR STORAGE. DO NOT DAMAGE. |
| D15 | EXISTING WALL MOUNTED SHARPS CONTAINER TO BE REMOVED AND PASSED ONTO HOSPITAL FOR STORAGE. DO NOT DAMAGE. |
| D16 | EXISTING WALL MOUNTED LIGHT FIXTURE & WD BACKING TO BE REMOVED AND PASSED ONTO HOSPITAL FOR STORAGE. DO NOT DAMAGE. |
| D17 | EXISTING PATIENT MONITOR, WALL MOUNTING FIXTURE & BASKET UTILITY TO BE REMOVED AND PASSED ONTO HOSPITAL FOR STORAGE. DO NOT DAMAGE. |
| D18 | EXISTING LEAD LINING TO REMAIN. EXTENT SHOWN IS ONLY APPROX. DO NOT DAMAGE. |
| D19 | CUT CONCrete FLOOR SLAB FOR JUNCTION BOX & CONDUIT INSTALLATION. PENETRATION TO BE FILL PATCHED BY SMCWMAILED AS REQ'D TO MAINTAIN NECESSARY FIRE RATING. |
| D20 | SEE EQUIPMENT, ELEC & STRUCT DWGS FOR EXACT LOCATION, SIZE & DETAILS |
| D20 | CONTRACTOR TO ALLOW (1) WEEK FOR ASBESTOS REMOVAL OF EXISTING SHEET PILING BY OTHER CONTRACTOR TO INSTALL FLOOR UNDERLAMENT AS REQUIRED FOR PREPARATION OF NEW FLOOR FINISH TO MEET FLOORING MANUFACTURER'S STRENGTH. |

- ALL ASBESTOS CONTAINING MATERIALS DISCOVERED DURING CONSTRUCTION SHALL BE HANDLED ACCORDING TO SPEC SECTION 011000 - TOWNERS GENERAL CONTRACTORS AND BE REMOVED ACCORDING TO WORKSAFE BC REQUIREMENTS
10. FIREPROOF AND PATCH EXISTING FIRE RATED WALL, FLOOR AND CEILING WITHIN PROJECT AREA TO MATCH EXISTING FIRE RATING.
11. UNUSUED EX OR NEW CONCRETE FLOOR PENETRATIONS MUST BE PATCHED WITH CONCRETE INFILL OF THE SAME THICKNESS AS EXISTING
- ## DEMOLITION KEY NOTES
- D01 FILL LT TAMP HARDING TO UNDERSIDE OF FIN CLING DURING CONSTRUCTION WITH:
- 92 MM STL STD STRU FRAMING @ 400 MM C/C
- 16 MM KT TAPED DRYWALL INSTALLED ON TOP OF PROJECT AREA
- 6 MIL POLY ON INSIDE OF PROJECT AREA
- D02 TEMP 3 X 7" DOOR WITH 12" X 12" VISION PANEL DURING CONSTRUCTION
- D03 EXISTING WALL BASE AND VINYL SHEET FLOOR FINISH & ADHESIVE TO BE REMOVED. INSTALL FLOOR UNDERLAYMENT AS REQUIRED FOR PREPARATION OF NEW FLOOR FINISH TO MEET FLOORING MANUFACTURERS STANDARDS.
- D04 EXISTING DRYWALL LAYER TO BE REMOVED.
- D05 REPAIR, PATCH AND MAKE SMOOTH ALL EXISTING DRYWALL TO RESEMBLE NEW PAINT FOR FULL LENGTH AND HEIGHT OF WALL
- D06 FOR M&E WORK EXTENDING BEYOND THE PROJECT AREA, CONTRACTOR TO REMOVE, REPAIR & REFINISH EXISTING CEILING AS REQ'D.
- D07 TEMP CONTINUOUS 6 MIL POLY ENCLOSURE SECURED & SEALED AGAIN ON ALL EDGES & W/ 864 X 2134 ZIPPER OPENING FOR ACCESS
- D08 EXISTING CORNER WALL TO REMAIN. DO NOT DAMAGE.

DEMOLITION KEY NOTES

- 001 FULL HLT TYPED HOARDING TO UNDERSIDE OF FIN CLING DURING CONSTRUCTION WITH:-
- 92 MM STILT STUD FRAMING @ 400 MM O/C
- 16 MM TYPED DRYWALL INSTALLED ON UNDERSIDE OF PROJECT AREA
- 6 MM POLY ON INSIDE OF PROJECT AREA
- 002 2MP 1/2 X 3/4 DOOR WITH 12" X 12" VISION PANEL FOR INSPECTION PURPOSES
- 003 EXISTING WALL BASE AND VINYL SHEET FLOOR FINISH & ADHESIVE TO BE REMOVED. INSTALL FLOOR UNDERLAYMENT AS REQUIRED FOR PREPARATION OF NEW FLOOR FINISH TO MEET LOCAL MANUFACTURER'S STANDARDS
- 004 EXISTING DRYWALL LAYER TO BE REMOVED.
- 005 REPAIR, PATCH AND MAKE SMOOTH ALL EXISTING DRYWALL TO RECEIVE NEW PAINT FOR FULL LENGTH AND HEIGHT OF WALL
- 006 FOR M&E WORK EXTENDING BEYOND THE PROJECT AREA, CONTRACTOR TO REMOVE, REPAIR & REFINISH EXISTING CEILING AS REQ'D
- 007 TYPED CONTINUOUS 6 MM POLY ENCLOSEMENT SEALS TO BE SEALED TO MEET AS PER 804 X 2134 ZIPPER OPENING FOR ACCESS
- 008 EXISTING CORNER JOINT TO REMAIN.
DO NOT DAMEN

DEMOLITION GENERAL NOTES

1. CONTRACTOR TO PROVIDE ALL DEMOLITION AS REQUIRED FOR NEW WORK.
2. OBTAIN APPROVAL FROM HOSPITAL FOR LAYOUT OF TEMP HOARDING AND CONSTRUCT HOARDING PER HOSPITAL'S REQUIREMENTS.
3. CONTRACTOR TO PROVIDE ADEQUATE PROTECTION TO ALL EXISTING PROPERTIES DURING DEMOLITION AND CONSTRUCTION.
4. ALL CONCRETE SLAB CUTTING OR DEMOLITION WORK WITH EXCESSIVE NOISE MUST BE PERFORMED AFTER REGULAR HOURS AS PERMITTED BY HOSPITAL. ANY EXTRA COST ASSOCIATED WITH AFTER-HOURS WORK WILL BE PART OF THIS CONTRACT.
5. DISPOSAL OF DEMOLISHED MATERIALS MUST BE CARRIED OUT AFTER REGULAR HOURS THROUGH SERVICE CORRIDORS AS PERMITTED BY THE HOSPITAL.
6. REMOVAL OF ANY FLOOR FINISHES MUST INCLUDE COMPLETE REMOVAL OF ANY UNDERLAYMENT AND BLUE ADHERED TO THE CONC SLAB.
7. ANY ASSOCIATED M&E SERVICES MUST BE DISCONNECTED BEFORE REMOVAL OF ANY WALL, FLOOR AND CEILING.
8. THE OWNER RESERVES THE RIGHT TO CLAIM ALL DEMOLITION ITEMS WHERE IT MAY BE POSSIBLE TO REUSE THEM IN THE FUTURE. CONFORM WITH THE OWNER'S POLICY PRIOR TO DISPOSING OF ITEMS.
9. BEFORE ANY CONCRETE SLAB CUTTING AND/OR CORING, CONTRACTOR MUST PERFORM SCANNING OF EX CONC SLAB & DIG OUT TRIAL PITS TO LOCATE AND RECORD ANY EXISTING IN-SLAB OR UNDER-SLAB SERVICES, PIPES, DUCTS, CONDUITS AND UTILITY SERVICES. DRILLING AND/OR DIGGING IS REQUIRED TO VERIFY EXACT LOCATION OF EX UNDERGROUND SERVICES. CONTRACTOR IS REQUIRED TO SEEK APPROVAL FROM HOSPITAL FOR ANY DISCONNECTMENT OF THE SLAB CUTTING AND/OR CORING WORK.
10. WHERE PENETRATIONS THROUGH CONCRETE SLABS ARE INACCESSIBLE BY SCAN EQUIPMENT, HAND CHIPPED CONC SLAB TO INVESTIGATE ANY IN-SLAB SERVICES.

PLUMBING FIXTURE LEGEND

- REFER TO PLUMB DWGS FOR DETAILS OF PLUMB
FIXTURES
- PF01 NEW WALL MOUNTED HAND WASHING SINK
WITH HANDS FREE FAUCET
- PF02 NEW WALL MOUNTED HAND WASHING SINK
C/W FOOT PEDAL


- A1.10 - NEW ELEC CONDUITS. SEE ELEC & STRUCT DWGS FOR EXACT ROUTING AND DETAILS.
- FOR FLOOR, CONTRACTOR TO SCAN EXISTING CONCRETE FLOOR SLAB BEFORE CORING (IF CORING IS REQ'D).
- FOR WALL, CONTRACTOR TO CUT WALL AS REQ'D.
- FOR CEILING, CONTRACTOR TO REMOVE CEILING BELOW AS REQ'D.
- REPAIR AND MAKE GOOD ALL FLOORS, WALLS, AND CEILINGS TO MATCH EXISTING INCLUDING FINISHING & SEPARATE FINISHMENTS AFTER COMPLETION OF ELECTRICAL WORK.
- A1.11 PROVIDE NEW BOLDBOARD WALL MOUNT WITH IN WALL FIRE RATED/TREATED PLYWOOD BACKING - SEE DWG 3C/A4.01 FOR EXACT WALL MOUNT HEIGHT AND LOCATION ON WALL
- A1.12 PROVIDE NEW WALL MOUNTED LEAD APRON HOOKS (TOTAL 8) WITH IN WALL FIRE RATED/TREATED PLYWOOD BACKING - SEE DWG 3C/A4.01 FOR EXACT HEIGHT AND LOCATION ON WALL
- A1.13 PROVIDE NEW MEDICAL STORAGE CABINET (IF EQ-11) WITH IN WALL FIRE RATED/TREATED PLYWOOD BACKING PER MANUFACTURER'S RECOMMENDATIONS & REQUIREMENTS - SEE EQUIPMENT SCHEDULE FOR DETAILS
- A1.14 PROVIDE NEW UPPER AND LOWER CASH RAILS WITH WALL FIRE RATED/TREATED PLYWOOD BACKING - SEE DWG 3A & 3B/A4.01 FOR EXACT HEIGHT AND EXTENT ON WALL
- A1.15 1" WIDE SHEET VINYL FLOOR RED WARNING STRIP
- A1.16 PROVIDE SIGNAGE AS RECOMMENDED BY MANUFACTURER FOR WALL CHANG (IF EQ-13) INSTALLATION (REMOVE EX WALL GIBB IF REQ'D)
- A1.17 NEW PIPING/CONDUIT - SEE ELEC & MECH DWGS FOR EXACT ROUTING AND DETAILS.
- FOR FLOOR, CONTRACTOR TO SCAN EXISTING CONCRETE FLOOR SLAB BEFORE CORING (IF CORING IS REQ'D).
- FOR WALL, CONTRACTOR TO CUT WALL AS REQ'D.
- FOR CEILING, CONTRACTOR TO REMOVE CEILING ABOVE AS REQ'D.
- REPAIR AND MAKE GOOD ALL FLOORS, WALLS, AND CEILINGS TO MATCH EXISTING INCLUDING FINISHING & SEPARATE FINISHMENTS AFTER COMPLETION OF ELECTRICAL WORK.

CONSTRUCTION KEY NOTES

- ALL WORKS BELOW ARE NEW INCLUDING SUPPLY & INSTALLATION OF MATERIALS U.N.O.
- A1.01 SEAL DOOR EDGES TO MEET INFECTION CONTROL REQUIREMENT DURING CONSTRUCTION
- A1.02 LEVEL FLOOR WITH SELF-LEVELING FLOOR FINISHMENT TO MEET INFECTION PREVENT VECTOR FLATNESS AND LEVELNESS REQUIREMENTS - SEE EQUIPMENT DWGS FOR EXTENT
- A1.03 PROVIDE NEW HAND RAIL & LOWER WALL BUFFER INLET TO MATCH EXISTING C/W IN ROOM FOR RETARDANT TREATED PLYWOOD BACKING - SEE DETAIL 682/45/03
- A1.04 RESERVED
- A1.05 55" H WALL PROTECTION COVERING (WPT) ABOVE WALL BASE - SEE DWG 3A8.38/A4.01
- A1.06 PROVIDE IN WALL FIRE RETARDANT TREATED PLYWOOD BACKING FOR UPPER CABINET (REMOVE EX GWP IF REQ'D)
- A1.07 PROVIDE IN WALL 350mm HIGH FIRE RETARDANT TREATED PLYWOOD BACKING FOR ANCHORING OF SIEMENS ELECTRONICS CABINETS. BACKING TO BE FLUSH MOUNTED/INSTALLED 2160mm AFF TO BOTTOM EDGE, AND MUST COVER THE ENTIRE WIDTH OF THE ELECTRONICS CABINET(S) PLUS 1mm, 50mm O/C EACH SIDE - SEE EQUIPMENT DWGS
- A1.08 PROVIDE IN WALL 350mm HIGH FIRE RETARDANT TREATED PLYWOOD BACKING FOR ANCHORING OF SIEMENS CONTROL ROOM DISTRIBUTOR. BACKING TO BE FLUSH MOUNTED, INSTALLED 500mm AFF TO BOTTOM EDGE, AND MUST COVER THE ENTIRE WIDTH OF THE DISTRIBUTOR PLUS 1mm, 50mm O/C EACH SIDE - SEE EQUIPMENT DWGS
- A1.09 PATIENT TABLE INSTALLATION PLATE TO BE ANCHORED TO CONCRETE FLOOR - SEE EQUIPMENT & STRUCT DWGS

CONSTRUCTION GENERAL NOTES

1. ALL EXISTING AND NEW PENETRATIONS THROUGH FIRE RATED WALLS & FLOORS SHALL BE FIRESTOPPED & SMOKE SEALED AS REQUIRED TO MAINTAIN NECESSARY FIRE RATING. FIRESTOPPING SHALL BE PERFORMED WITHOUT DELAY AS SOON AS THEY ARE OPENED, TO PREVENT SPREAD OF FIRE AND SMOKE DURING CONSTRUCTION.
2. REPAIR, PATCH AND SKIM COAT AND LEVEL EXISTING CONG. SLAB THROUGHOUT PROJECT AREA PER EQUIPMENT MANUFACT. SPECIFICATION BEFORE INSTALLATION OF NEW FLOOR FINISHES.
3. EXISTING GWB WALLS SHOWN TO REMAIN SHALL BE SKIM COATED AND SANDED SMOOTH BEFORE RECEIVING PAINT.
4. REMOVE, REPAIR & REFINISH EX DRYWALL AS REQ'D FOR INSTALLATION OF NEW MECH & ELEC PIPES, CONDUITS & EQUIPMENT.
5. STRUCTURAL DESIGN FOR NEW ST LINTEL AND CONG. SLAB TRENCING & REPLACEMENT, IF ANY, SHALL BE PERFORMED BY A LICENSED STRUCT ENG & PAID FOR BY CONTRACTOR.
6. PATCH AND REFINISH DRYWALL WHERE EX M&E WALL OUTLETS, PENETRATIONS & EQUIPMENT ARE REMOVED AND DISCARDED.
7. PROVIDE BACKING ON WALLS FOR MILLWORK, HANDRAILS, CHAIR RAILS, BATHROOM ACCESSORIES, M&E FIXTURES AND ANY EQUIP AS REQUIRED. SEE M&E AND EQUIP SPECIFICATIONS FOR BACKING LOCATIONS AND REQUIREMENTS.
8. FOR NEW LEAD LINED WALL, LEAD LINE ALL NEW AND EX TO REMAIN WALLS, OUTLETS, PENETRATIONS, PIPES, AND DUCT WORK TO MAINTAIN CONTINUITY OF SHIELDING - SEE SPEC SECTION 130900 RADIATION PROTECTION.
9. SKIM COAT ALL EXISTING CONG. FLOOR TO RECEIVE NEW FLOORING THROUGHOUT PROJECT AREA.
10. REPAIR EX SPRAY THERMAL INSULATION BELOW CONG. SLAB AND NEW PIPE AND CONDUIT PENETRATIONS TO BELOW, IF APPLICABLE.

7	ISSUED FOR ADDENDUM 1		FEB 22, 2021
6	ISSUED FOR TENDER		FEB 10, 2021
5	ISSUED FOR 80% CD		DEC 16, 2020
4	ISSUED FOR BP SUBMISSION		DEC 4, 2020
3	ISSUED FOR DD REVIEW		NOV 20, 2020
2	NOT ISSUED	-	-
1	NOT ISSUED	-	-
No.	REVISION	DATE	BY

THIS DRAWING IS THE PROPERTY OF DCY
ARCHITECTURE. REPRODUCTION OF THIS
DRAWING IN WHOLE OR IN PART IS
PROHIBITED UNLESS WITH WRITTEN
PERMISSION.



UHNBC FLUOROSCOPY REPLACEMENT

1475 EDMONTON STREET, PRINCE GEORGE
BC V2M 1S2

PHASE 1 - INTER FLUORO
LEVEL 1
DEMO & FRAMING PLAN

SCALE:

1:50

DATE: _____

OCTOBER 2020


DRAWN
DC

RC
CHECKED


DC

JOB No.:


PHASE 1
A2.02

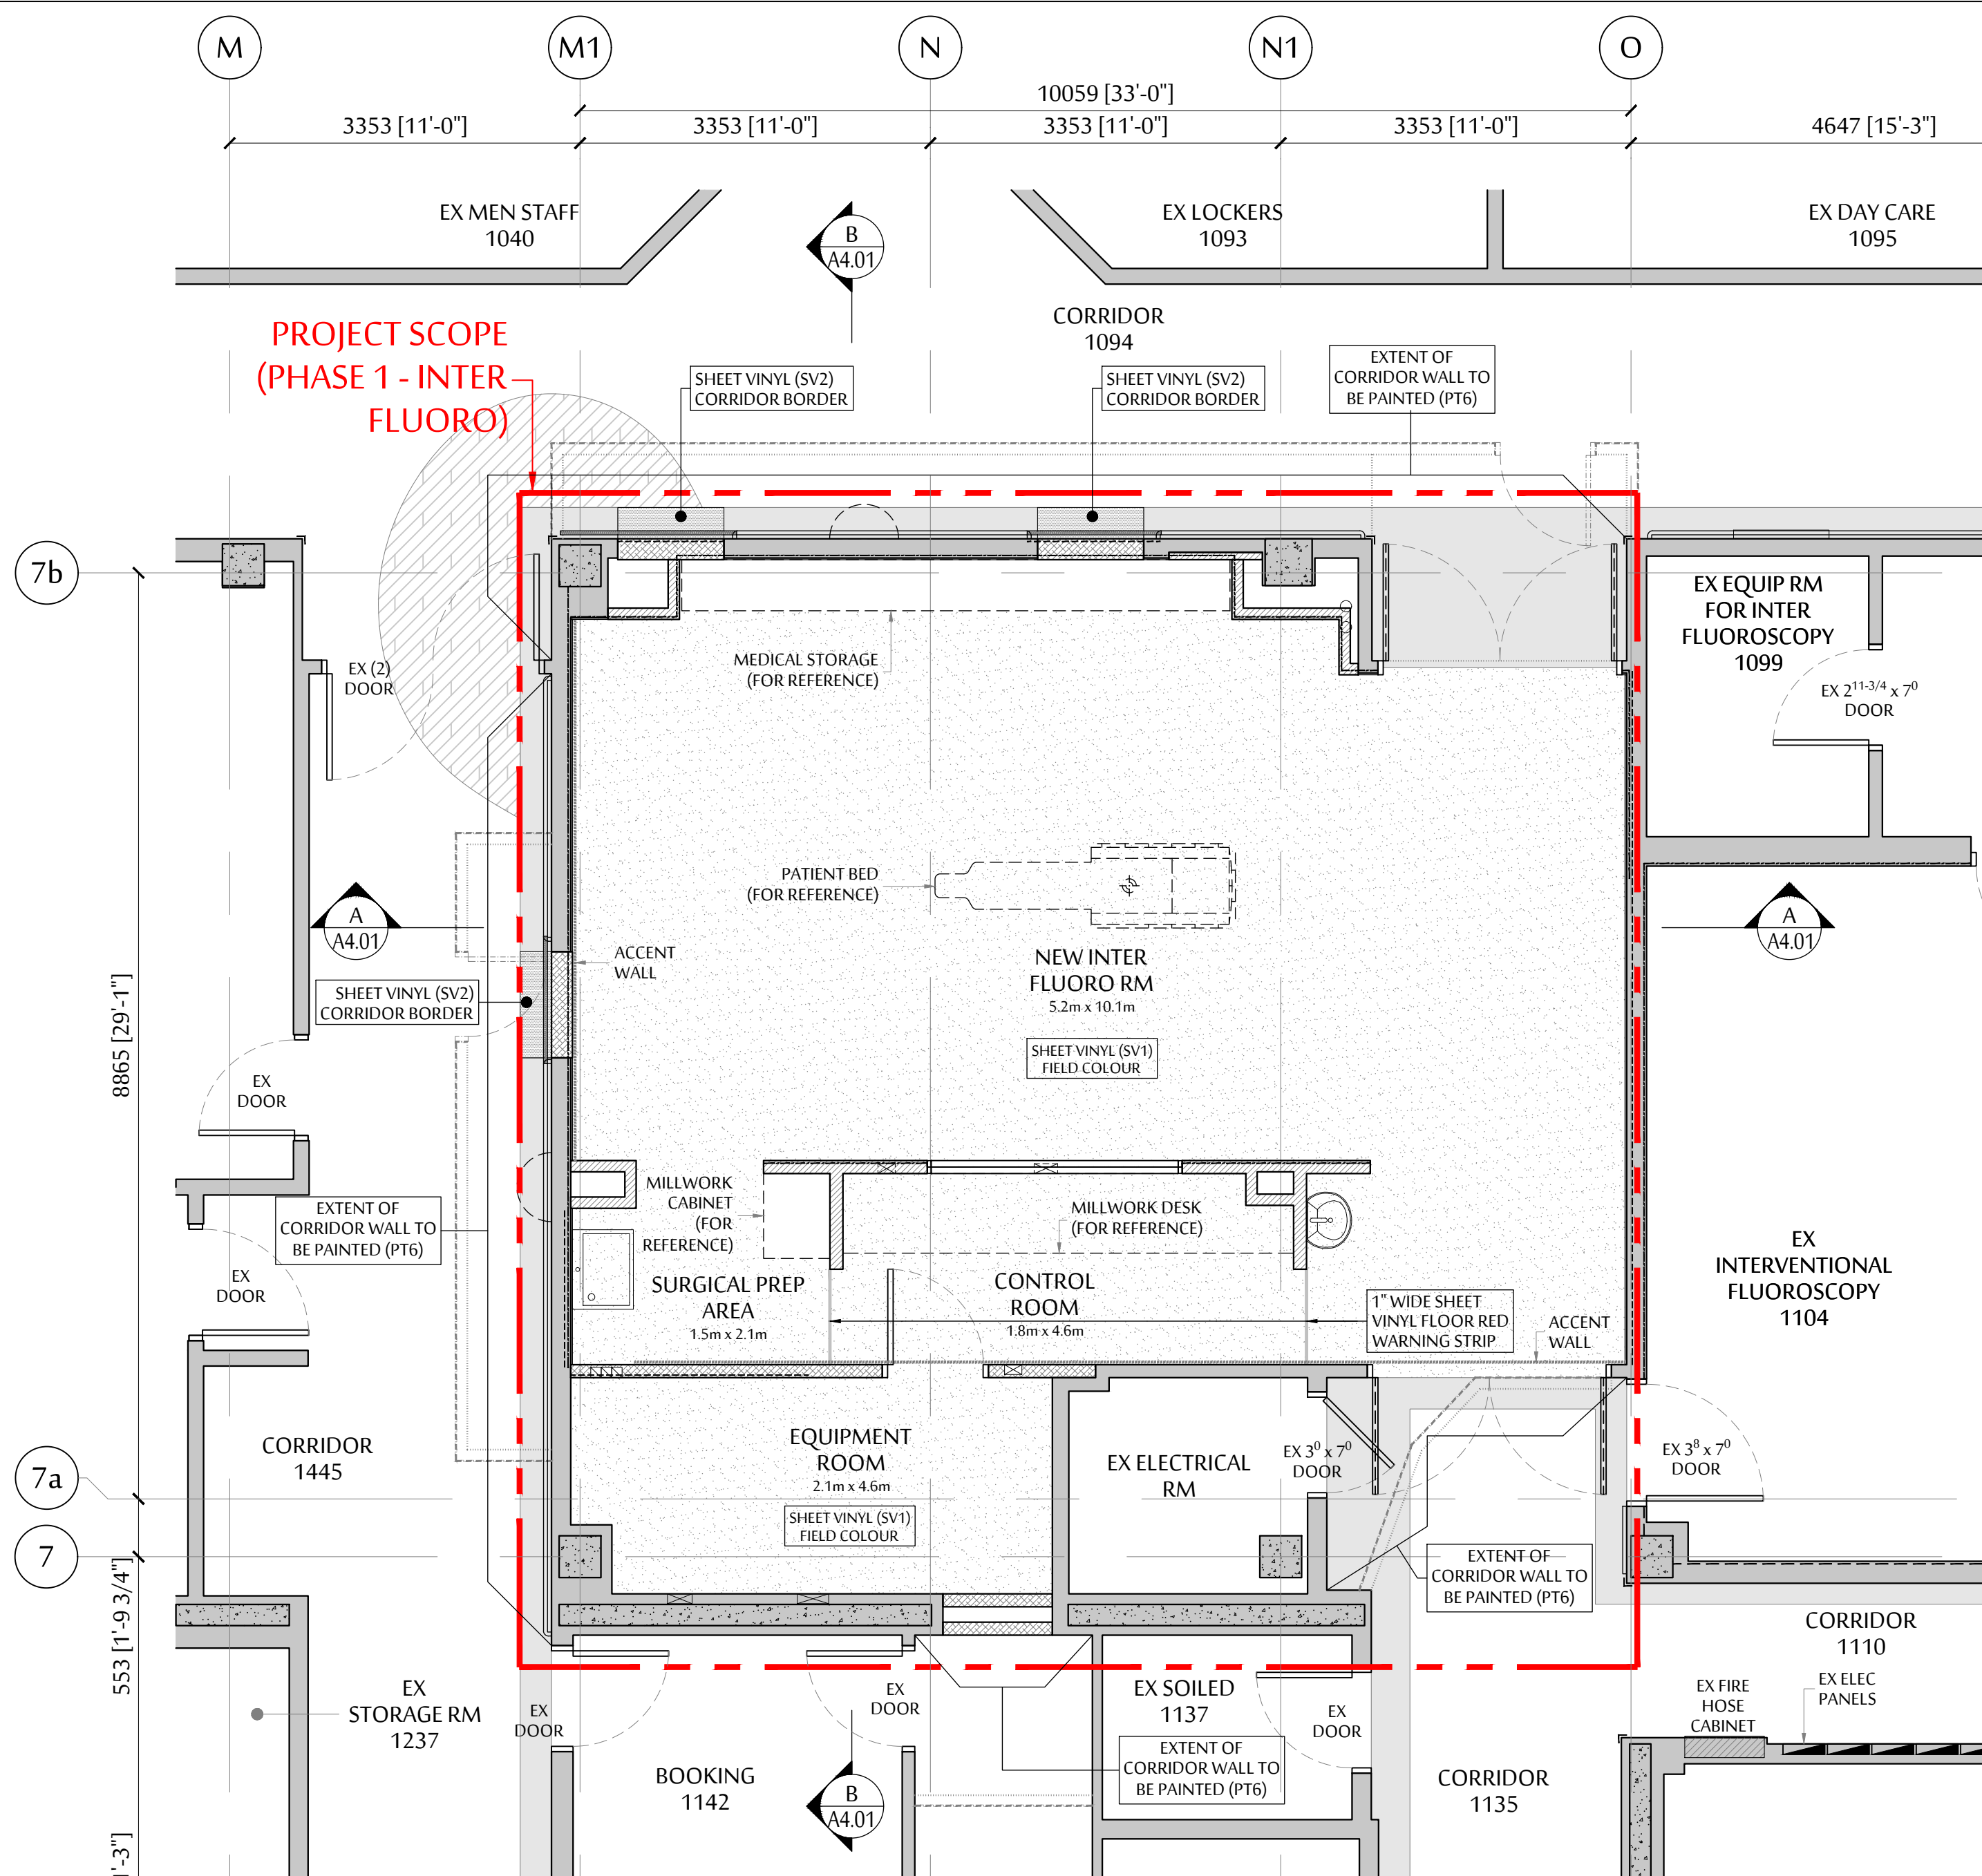


2 PHASE 1 - LEVEL 1 - FINISHES PLAN
SCALE: 1 = 50

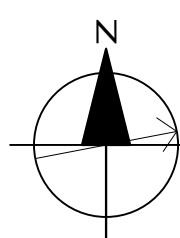

PHASE 1 - INTER FLUORO : APPROX.
GROSS FLOOR AREA = 95.7 m² (1,030 ft²)

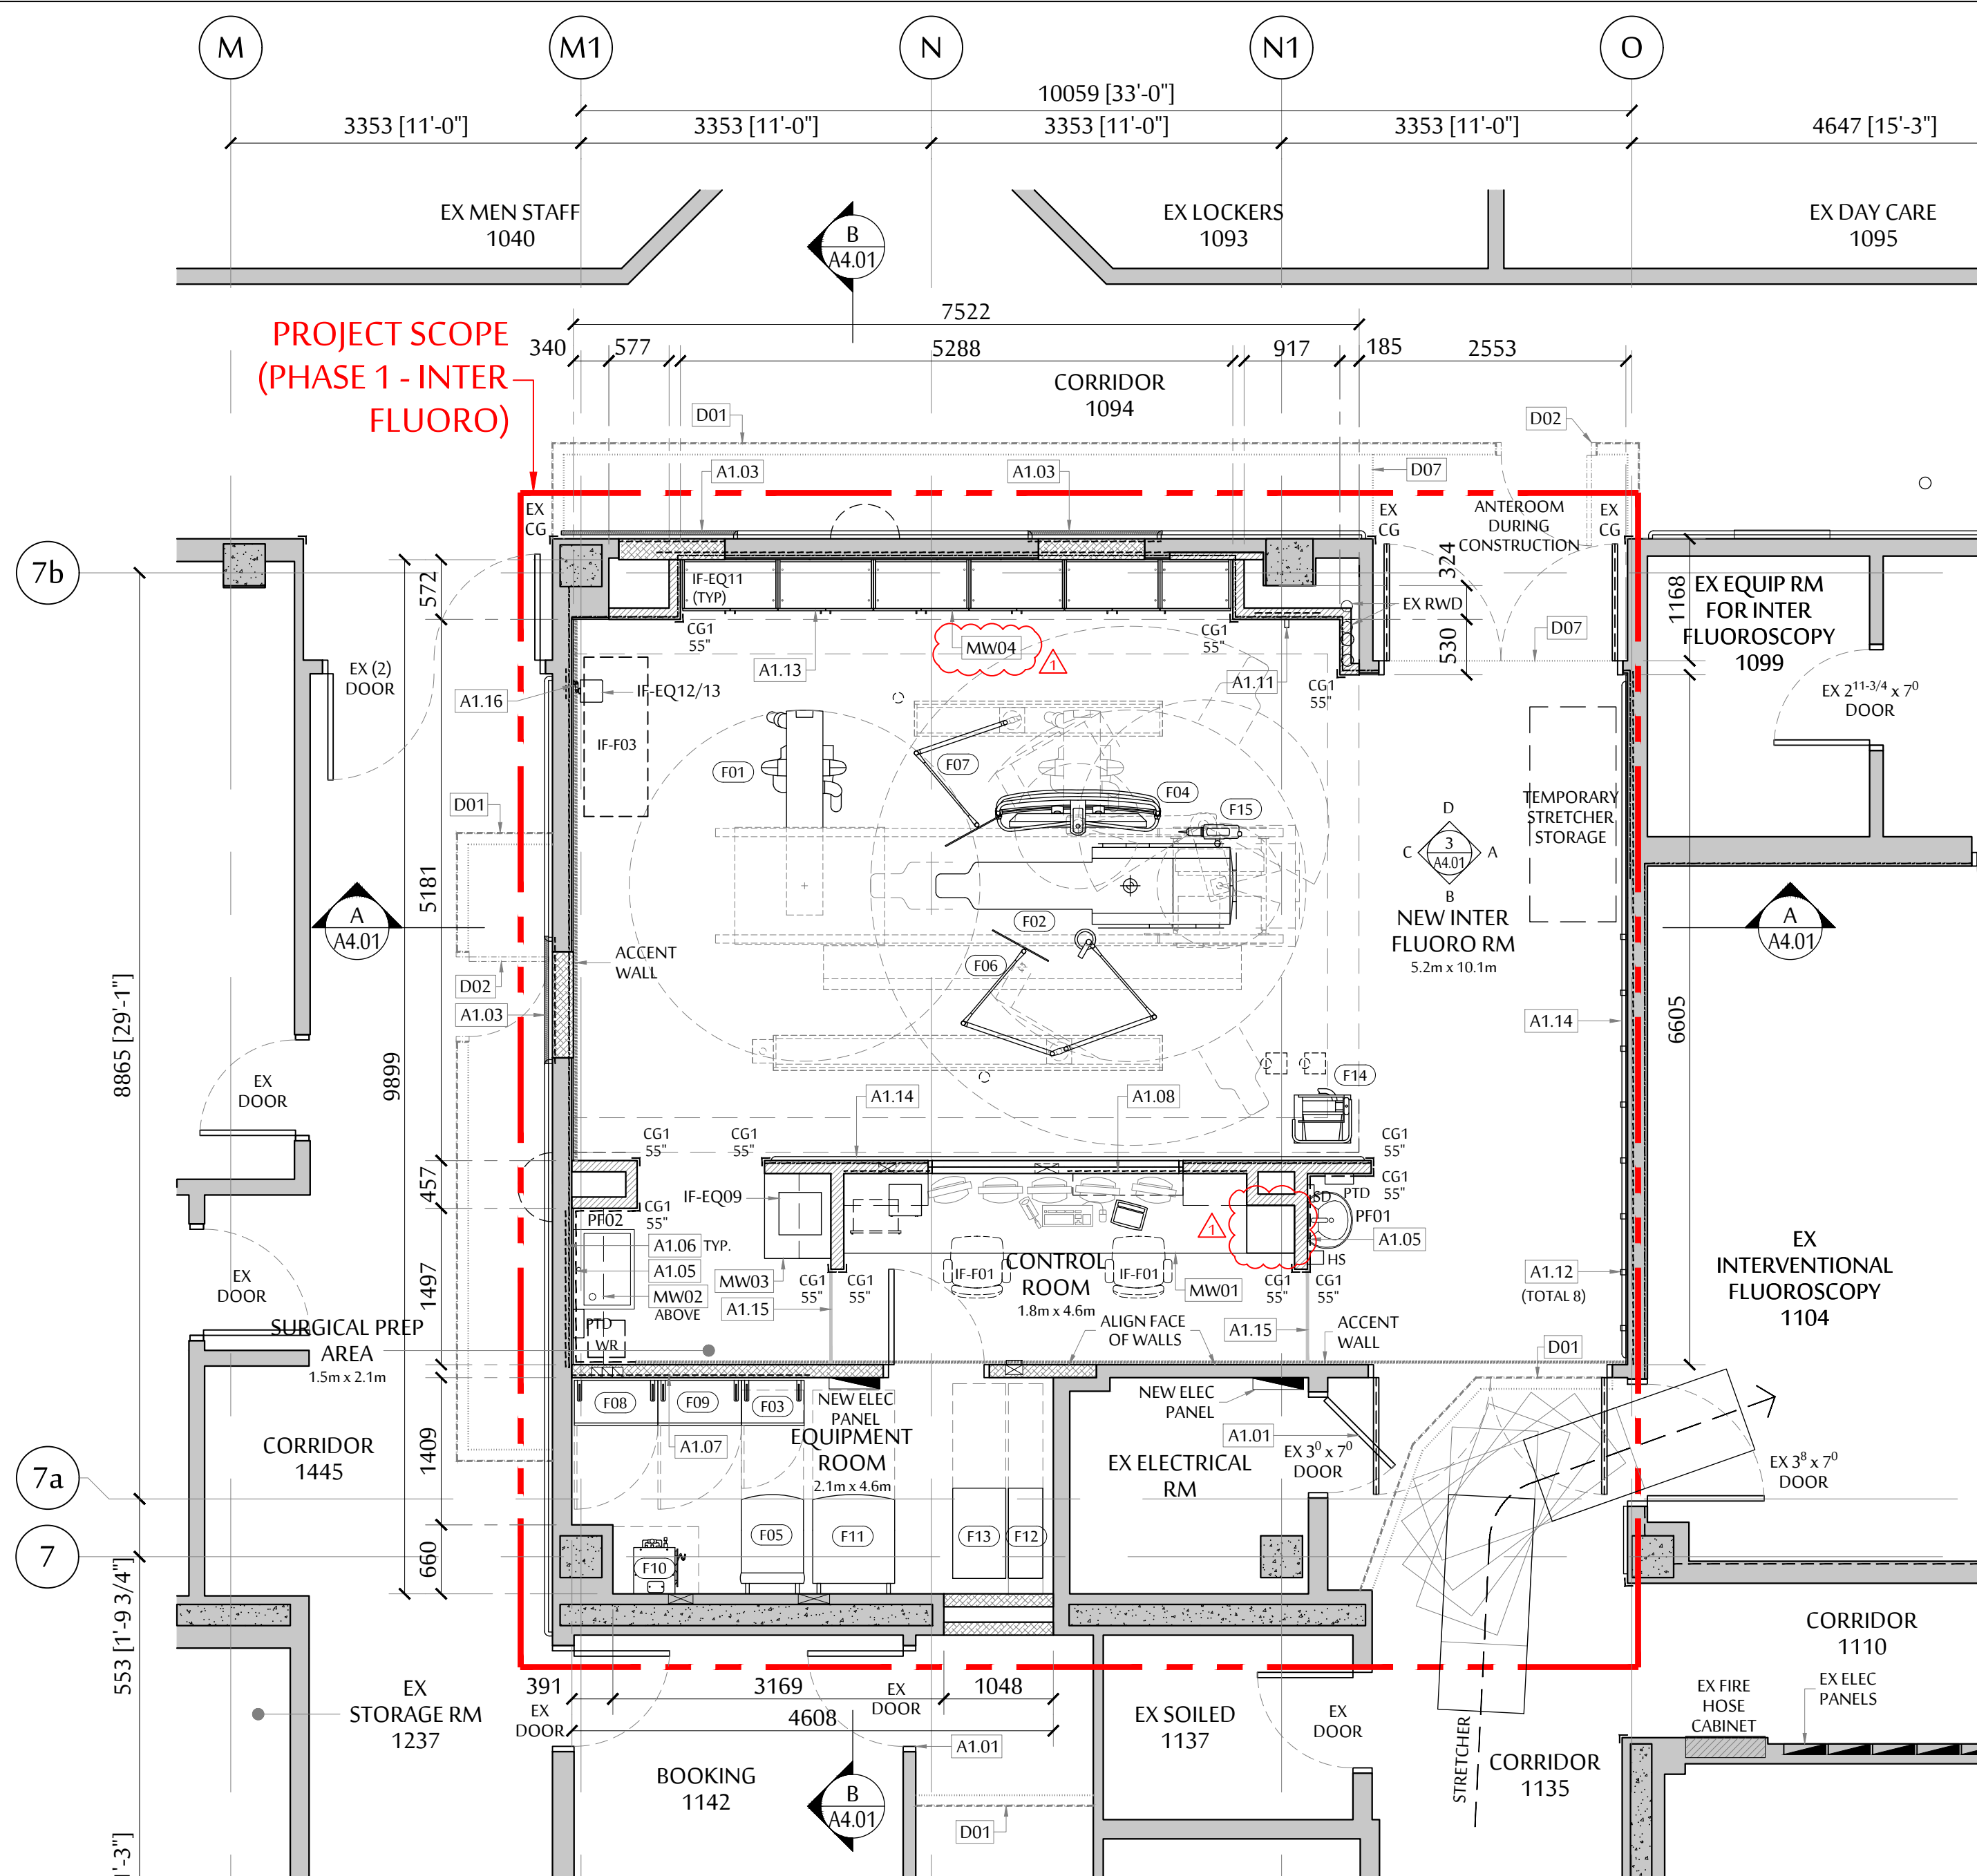

1 PHASE 1 - LEVEL 1 - FURNITURE & EQUIPMENT PLAN
SCALE: 1 = 50

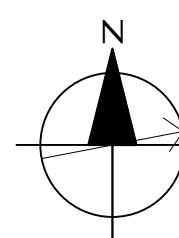

PHASE 1 - INTER FLUORO : APPROX.
GROSS FLOOR AREA = 95.7 m² (1,030 ft²)

UHNBC FLUOROSCOPY REPLACEMENT - FURNITURE & EQUIPMENT SCHEDULE							
DATE: FEBRUARY 10, 2021							
CODE	UNIT	#	EX OR NEW	ACTION REQUIRED	PERSON RESPONSIBLE	CONTRACTOR TO INSTALL	REMARKS
NEW INTER FLUORO ROOM - EQUIPMENT & FURNITURE							
IF-EQ01	SOAP DISPENSER (WALL MOUNTED)	2	NEW	PURCHASE	CLIENT	*	
IF-EQ02	PAPER TOWEL DISPENSER (WALL MOUNTED)	2	NEW	PURCHASE	CLIENT	*	
IF-EQ03	HAND SANITIZER (WALL MOUNTED)	2	NEW	PURCHASE	CLIENT	*	
IF-EQ04	GLOVE DISPENSER (WALL MOUNTED)	2	NEW	PURCHASE	CLIENT	*	
IF-EQ05	CLOCK (WALL MOUNTED)	1	NEW	PURCHASE	CLIENT	*	
IF-EQ06	WASTE RECEPTACLE	3	NEW	PURCHASE	CLIENT	*	
IF-EQ07	ROLLBOARD	1	NEW	PURCHASE	CLIENT	*	
IF-EQ08	LEAD APRON HANGERS	8	NEW	PURCHASE	CLIENT	*	
IF-EQ09	CONTRAST WARMER	1	NEW	PURCHASE	CLIENT	*	
IF-EQ10	COMPUTER (CPU, MONITOR)	TBD	NEW	PURCHASE	CLIENT	*	
IF-EQ11	MEDICAL STORAGE CABINET	6	NEW	PURCHASE	CONTRACTOR	*	Medical Storage purchase order to be provided to contractor
IF-EQ12	PATIENT MONITOR	1	NEW	PURCHASE	CLIENT	*	
IF-EQ13	MONITOR MOUNTING ARM	1	NEW	PURCHASE	CLIENT	*	
IF-F01	TASK CHAIR	2	NEW	PURCHASE	CLIENT	*	
IF-F02	SIDE CHAIR	2	EX	RELOCATION	CLIENT	*	
IF-F03	INSTRUMENT TABLE	1	EX	RELOCATION	CLIENT	*	

EQUIPMENT LEGEND

SIEMENS ARTIS Q CEILING INTERVENTIONAL FLUOROSCOPY (TO BE SUPPLIED BY EQUIPMENT VENDOR - UNLESS NOTED OTHERWISE)

- (F01) ARTIS Q CEILING STAND
- (F02) PATIENT TABLE (COORDINAT)
- (F03) SYSTEM CONTROL CABINET #2
- (F04) DCS EXT. LARGE DISPLAY MONITOR
- (F05) LARGE DISPLAY CONTAINER
- (F06) RADIATION SHIELD + OR LIGHT
- (F07) RADIATION SHIELD
- (F08) GENERATOR CABINET
- (F09) SYSTEM CONTROL CABINET #1
- (F10) COOLING UNIT
- (F11) IMAGE SYSTEM CABINET
- (F12) UPS
- (F13) TRANSFORMER CABINET
- (F14) CONTROL CONSOLE AND ECC ON TROLLEY
- (F15) INJECTOR HEAD (TABLE MOUNTED)

PLUMBING FIXTURE LEGEND

REFER TO PLUMB DWGS FOR DETAILS OF PLUMB FIXTURES

- PF01 NEW WALL MOUNTED HAND WASHING SINK WITH HANDS FREE FAUCET
- PF02 NEW WALL MOUNTED HAND WASHING SINK C/W FOOT PEDAL

- A1.10 - NEW ELEC CONDUITS. SEE ELEC & STRUCT DWGS FOR EXACT ROUTING AND DETAILS.
 - FOR FLOOR, CONTRACTOR TO SCAN EXISTING CONC. FLOOR SLAB BEFORE CORING (IF CORING IS REQ'D).
 - FOR WALL, CONTRACTOR TO CUT WALL AS REQ'D.
 - FOR CEILING, CONTRACTOR TO REMOVE CEILING BELOW AS REQ'D.
 - REPAIR AND MAKE GOOD ALL FLOORS, WALLS, AND CEILINGS TO MATCH EXISTING INCLUDING FIRE RATING & SEPARATION REQUIREMENTS AFTER COMPLETION OF ELECTRICAL WORK.
- A1.11 - PROVIDE NEW ROLLBOARD WALL MOUNT WITH IN WALL FIRE RETARDANT TREATED PLYWOOD BACKING - SEE DWG 3C/A4.01 FOR EXACT WALL MOUNT HEIGHT AND LOCATION ON WALL
- A1.12 - PROVIDE NEW WALL MOUNTED LEAD APRON HOOKS (TOTAL 8) WITH IN WALL FIRE RETARDANT TREATED PLYWOOD BACKING - SEE DWG 3A/A4.01 FOR EXACT HEIGHT AND LOCATION ON WALL
- A1.13 - PROVIDE NEW MEDICAL STORAGE CABINET (IF-EQ11) WITH IN WALL FIRE RETARDANT TREATED PLYWOOD BACKING PER MANUFACTURER'S RECOMMENDATIONS & REQUIREMENTS - SEE EQUIPMENT SCHEDULE FOR DETAILS
- A1.14 - PROVIDE NEW UPPER AND LOWER CRASH RAILS WITH IN WALL FIRE RETARDANT TREATED PLYWOOD BACKING - SEE DWG 3A & 3B/A4.01 FOR EXACT HEIGHT AND EXTENT ON WALL
- A1.15 - 1" WIDE SHEET VINYL FLOOR RED WARNING STRIP
- A1.16 - PROVIDE IN WALL BACKING AS RECOMMENDED BY MANUFACTURER FOR WALL CHANNEL (IF-EQ13) INSTALLATION (REMOVE EX GWB IF REQ'D)
- A1.17 - NEW PIPING/CONDUIT - SEE ELEC & MECH DWGS FOR EXACT ROUTING AND DETAILS.
 - FOR FLOOR, CONTRACTOR TO SCAN EX CONC. FLOOR SLAB BEFORE CORING (IF CORING IS REQ'D).
 - FOR WALL, CONTRACTOR TO CUT WALL AS REQ'D.
 - FOR CEILING, CONTRACTOR TO REMOVE CEILING AS REQ'D.
 - REPAIR AND MAKE GOOD ALL FLOORS, WALLS, AND CEILINGS TO MATCH EXISTING INCLUDING FIRE RATING & SEPARATION REQUIREMENTS AFTER COMPLETION OF ELECTRICAL WORK.

CONSTRUCTION KEY NOTES

- ALL WORKS BELOW ARE NEW INCLUDING SUPPLY & INSTALLATION OF MATERIALS U.N.O.
- A1.01 SEAL DOOR EDGES TO MEET INFECTION CONTROL REQUIREMENT DURING CONSTRUCTION
- A1.02 LEVEL FLOOR WITH SELF-LEVELING FLOOR UNDERLAYMENT TO MEET EQUIPMENT VENDOR FLATNESS AND LEVELNESS REQUIREMENTS - SEE EQUIPMENT DWGS FOR EXTENT
- A1.03 PROVIDE NEW HAND RAIL & LOWER WALL BUFFER INFILL TO MATCH EXISTING C/W IN WALL FIRE RETARDANT TREATED PLYWOOD BACKING - SEE DETAIL 6&7/A5.03
- A1.04 RESERVED
- A1.05 55" H WALL PROTECTION COVERING (WP1) ABOVE WALL BASE - SEE DWG 3A&3B/A4.01
- A1.06 PROVIDE IN WALL FIRE RETARDANT TREATED PLYWOOD BACKING FOR UPPER CABINET (REMOVE EX GWB IF REQ'D)
- A1.07 PROVIDE IN WALL 350mm HIGH FIRE RETARDANT TREATED PLYWOOD BACKING FOR ANCHORING OF SIEMENS ELECTRONICS CABINETS. BACKING TO BE FLUSH MOUNTED, INSTALLED 2160mm AFF TO BOTTOM EDGE, AND MUST COVER THE ENTIRE WIDTH OF THE ELECTRONICS CABINET(S) PLUS MIN. 50mm ON EACH SIDE - SEE EQUIPMENT DWGS
- A1.08 PROVIDE IN WALL 350mm HIGH FIRE RETARDANT TREATED PLYWOOD BACKING FOR ANCHORING OF SIEMENS CONTROL ROOM DISTRIBUTOR. BACKING TO BE FLUSH MOUNTED, INSTALLED 500mm AFF TO BOTTOM EDGE, AND MUST COVER THE ENTIRE WIDTH OF THE DISTRIBUTOR PLUS MIN. 50mm ON EACH SIDE - SEE EQUIPMENT DWGS
- A1.09 PATIENT TABLE INSTALLATION PLATE TO BE ANCHORED TO CONCRETE FLOOR - SEE EQUIPMENT & STRUCT. DWGS

ARCHITECT :



WWW.DCYTARCHITECTURE.CA

No.	REVISION	DATE	BY
7	ISSUED FOR ADDENDUM 1	FEB 22, 2021	RC
6	ISSUED FOR TENDER	FEB 10, 2021	RC
5	ISSUED FOR 80% CD	DEC 16, 2020	RC
4	ISSUED FOR BP SUBMISSION	DEC 4, 2020	RC
3	NOT ISSUED	-	-
2	NOT ISSUED	-	-
1	NOT ISSUED	-	-

THIS DRAWING IS THE PROPERTY OF DCYT ARCHITECTURE. REPRODUCTION OF THIS DRAWING IN WHOLE OR IN PART IS PROHIBITED UNLESS WITH WRITTEN PERMISSION.



UHNBC FLUOROSCOPY REPLACEMENT

1475 EDMONTON STREET, PRINCE GEORGE BC V2M 1S2

PHASE 1 - INTER FLUORO LEVEL 1 - FURNITURE, EQUIP. & FINISHES PLAN

SCALE:

AS NOTED

DATE:

OCTOBER 2020

DRAWN:

RC












CHECKED:

DC

JOB No.:

DCYT2009

PHASE 1
A2.03

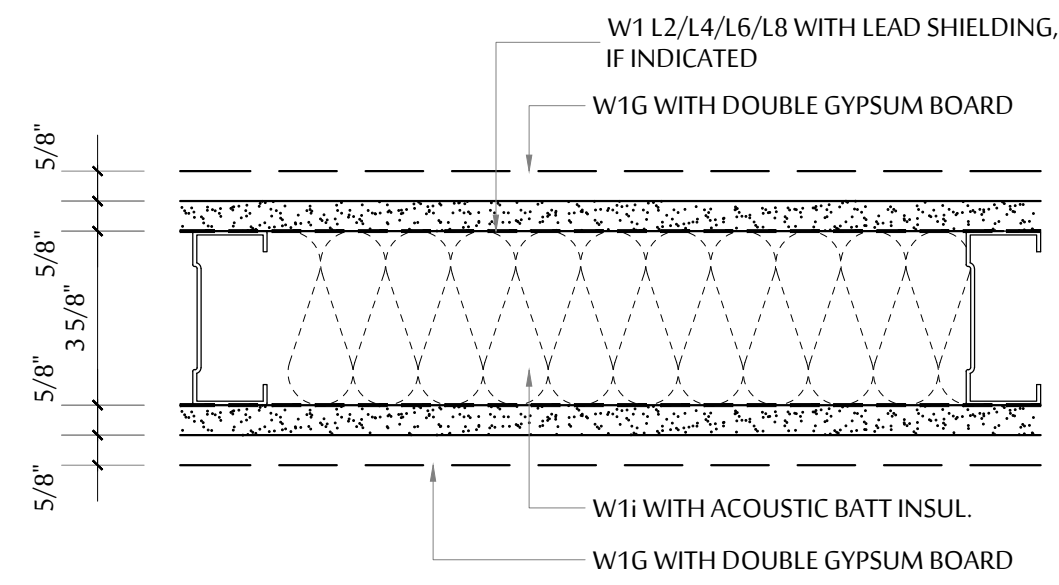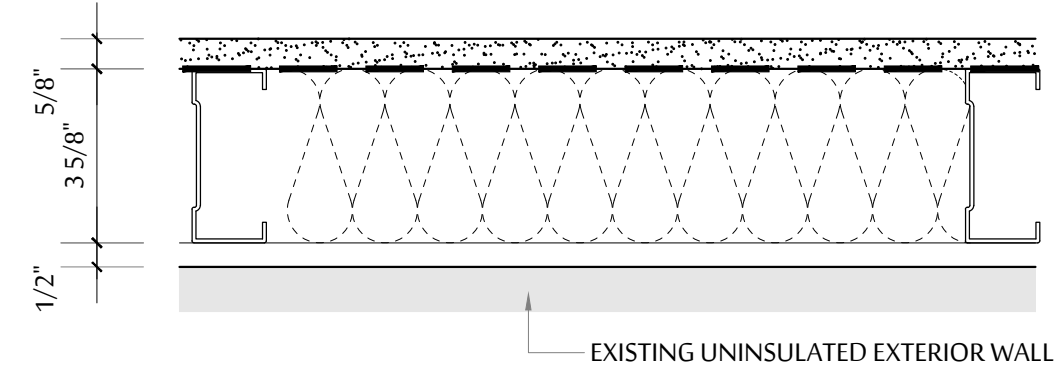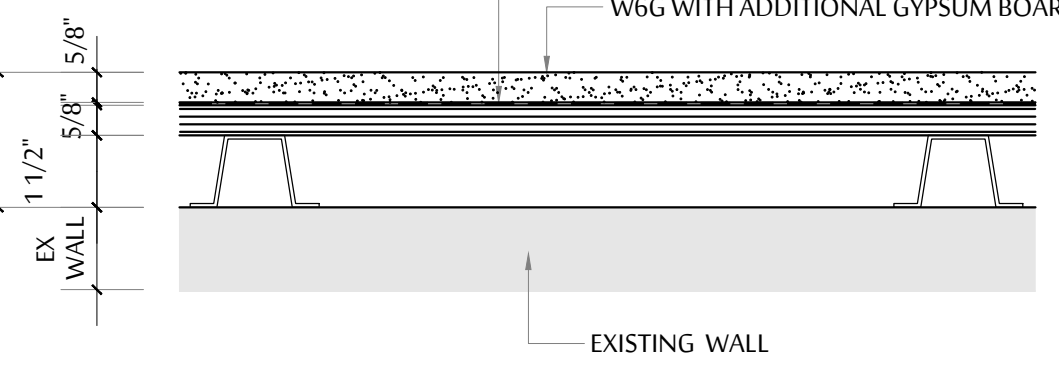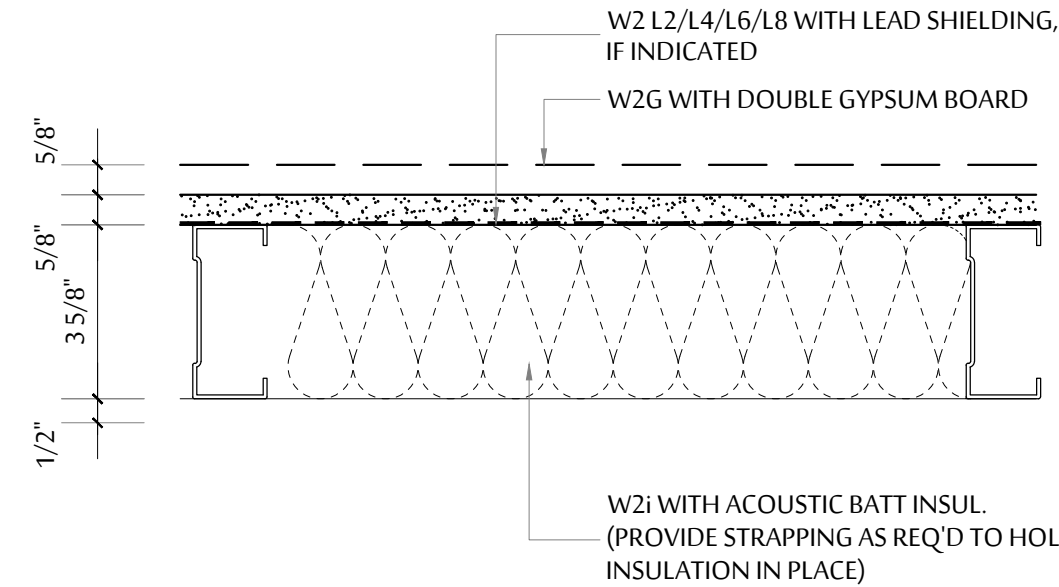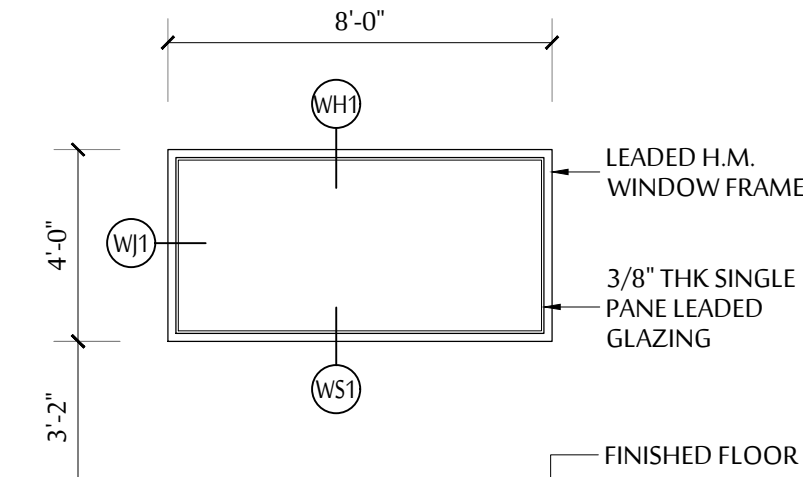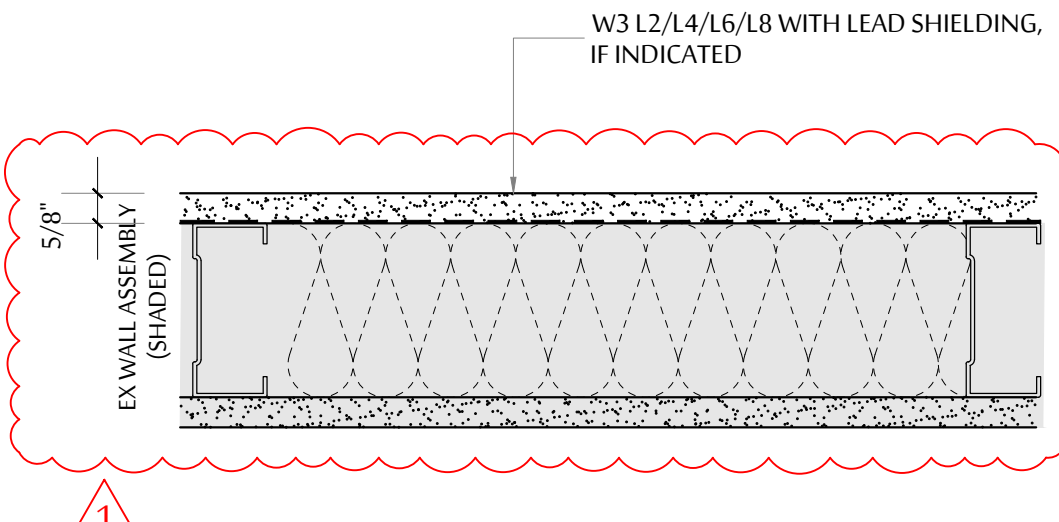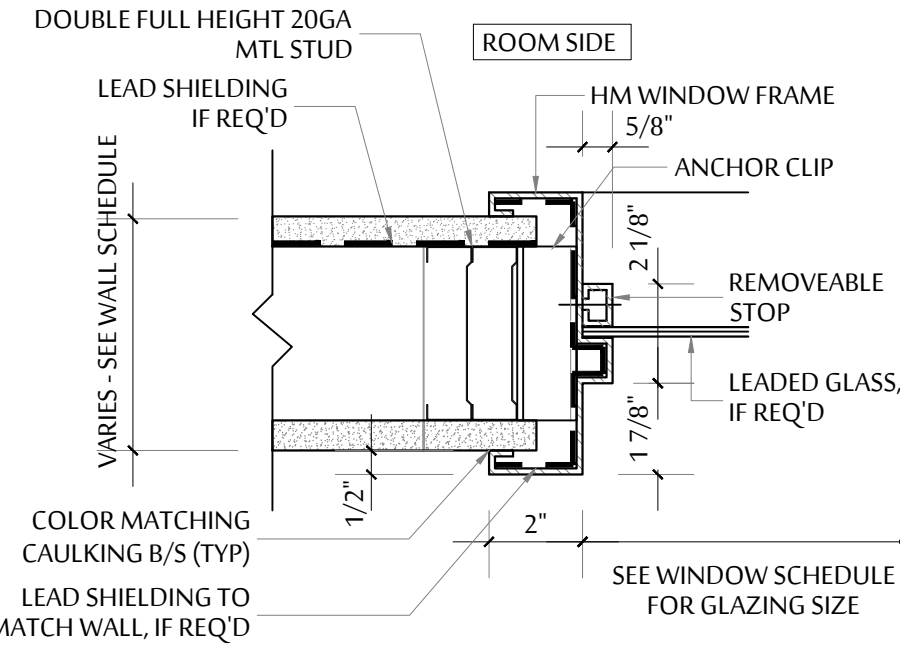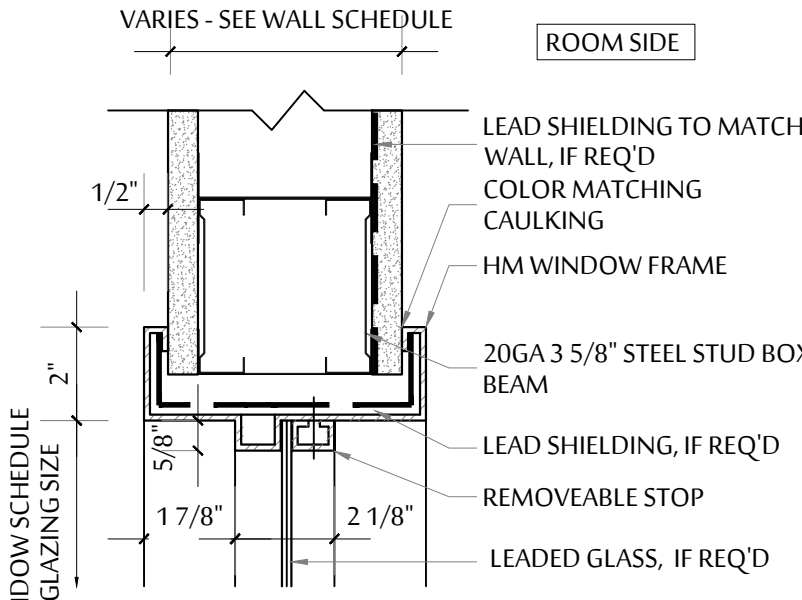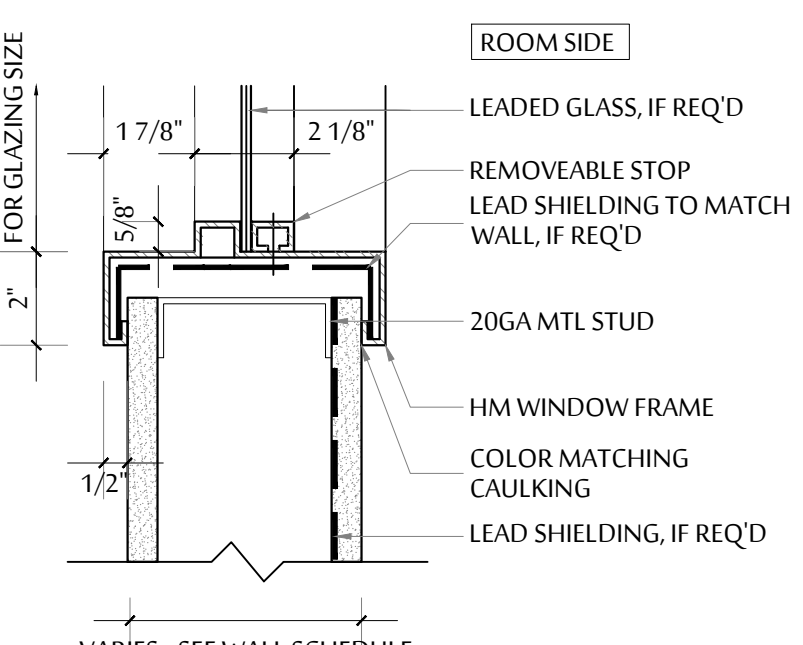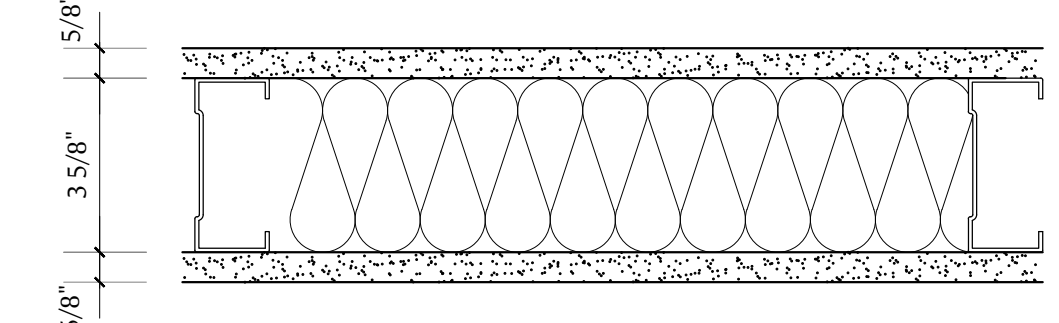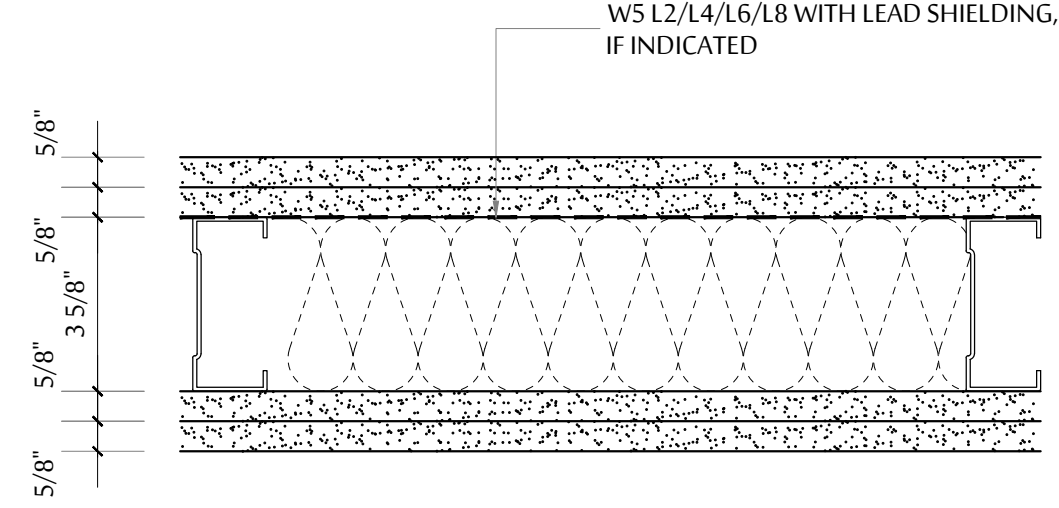WALL SCHEDULE			WINDOW SCHEDULE		
 <p>W1 L2/L4/L6/L8 WITH LEAD SHIELDING, IF INDICATED W1G WITH DOUBLE GYPSUM BOARD</p> <p>W1i WITH ACOUSTIC BATT INSUL. W1G WITH DOUBLE GYPSUM BOARD</p>	W1 NON-RATED WALL ASSEMBLY WALL ASSEMBLY TO EXTEND MIN. 152MM (6") ABOVE FINISHED CEILING & TIED TO STRUCT SLAB ABOVE WITH STEEL STUD BRACING - 16 MM (5/8") GYPSUM BOARD - 92 MM (3-5/8") 20 GA STEEL STUD AT 400MM (16") O.C. - 16 MM (5/8") GYPSUM BOARD	 <p>W6 L2/L4/L6/L8 WITH LEAD SHIELDING, IF INDICATED W6G WITH ADDITIONAL GYPSUM BOARD</p> <p>EXISTING UNINSULATED EXTERIOR WALL</p>	W6 (NOT USED) FUR-OUT WALL ASSEMBLY ON UNINSULATED EXTERIOR WALL - 16 MM (5/8") GYPSUM BOARD - 6 MIL POLY VAPOUR AND AIR BARRIER - 92 MM (3-5/8") 25 GA STEEL STUD AT 400MM (16") O.C. - WITH ACOUSTIC BATT INSULATION - 12MM (1/2" AIR GAP) - EXISTING UNINSULATED EXTERIOR WALL	 <p>W7 L2/L4/L6/L8 WITH LEAD SHIELDING, IF INDICATED W7G WITH ADDITIONAL GYPSUM BOARD</p> <p>EXISTING WALL</p>	W7 FUR-OUT WALL ASSEMBLY - 13 MM (1/2") FIRE-RESISTANT TREATED PLYWOOD - 38 MM (1-1/2") 25 GA STEEL FURRING CHANNEL AT 400MM (16") O.C.
 <p>W2 L2/L4/L6/L8 WITH LEAD SHIELDING, IF INDICATED W2G WITH DOUBLE GYPSUM BOARD</p> <p>W2i WITH ACOUSTIC BATT INSUL. (PROVIDE STRAPPING AS REQ'D TO HOLD INSULATION IN PLACE)</p>	W2 FUR-OUT WALL ASSEMBLY - 16 MM (5/8") GYPSUM BOARD - 92 MM (3-5/8") 20 GA STEEL STUD AT 400MM (16") O.C.	GENERAL NOTES: 1. ALL PARTITIONS FOR THIS PROJECT TO BE TYPE W1 UNLESS NOTED OTHERWISE 2. SEE STRUCT DWGS FOR FRAMING DETAILS FOR ALL WALL INFILLS, ADD ADDITIONAL GWB LAYERS AS REQUIRED TO BRING FLUSH WITH ADJACENT WALLS			 <p>W01 - HM WINDOW WITH 2mm LEAD EQUIVALENT GLASS</p>
 <p>W3 L2/L4/L6/L8 WITH LEAD SHIELDING, IF INDICATED</p> <p>EX WALL ASSEMBLY (SHADED)</p>	W3 LEAD SHIELDING FUR-OUT WALL ASSEMBLY ON EXISTING WALL - 16MM (5/8") GYPSUM BOARD - EXISTING STEEL STUD WALL ASSEMBLY	 <p>HM WINDOW JAMB DETAIL SCALE: 3" = 1'-0"</p>	 <p>HM WINDOW HEAD DETAIL SCALE: 3" = 1'-0"</p>	 <p>HM WINDOW SILL DETAIL SCALE: 3" = 1'-0"</p>	
 <p>W4 L2/L4/L6/L8 WITH LEAD SHIELDING, IF INDICATED</p>	W4 (NOT USED) FIRE-RATED WALL ASSEMBLY (1 HR F.R.R. & STC 47) - BC BUILDING CODE, TABLE A - 9.10.3.1. A WALL NUMBER S4b WALL ASSEMBLY TO EXTEND TO UNDERSIDE OF STRUCT SLAB ABOVE ONE PIECE (NO SPLICING), AND FIRE SEPARATED WITH 1 HR F.R.R. - 16 MM (5/8") TYPE "X" GYPSUM BOARD - 31MM X 92 MM (3-5/8") 20 GA STEEL STUD AT 400MM (16") O.C. - MINERAL FIBRE BATT INSULATION WITH MIN 2.8 KG/S.M. COMPLETELY FILL WALL CAVITY - 16 MM (5/8") TYPE "X" GYPSUM BOARD				
 <p>W5 L2/L4/L6/L8 WITH LEAD SHIELDING, IF INDICATED</p>	W5 FIRE-RATED WALL ASSEMBLY (2 HR F.R.R. & STC 55) - BC BUILDING CODE, TABLE A - 9.10.3.1. A WALL NUMBER S6b WALL ASSEMBLY TO EXTEND TO UNDERSIDE OF STRUCT SLAB ABOVE ONE PIECE (NO SPLICING), AND FIRE SEPARATED WITH 1 HR F.R.R. - 16 MM (5/8") TYPE "X" GYPSUM BOARD - 31MM X 92 MM (3-5/8") 20 GA STEEL STUD AT 400MM (16") O.C. - MINERAL FIBRE BATT INSULATION WITH MIN 2.8 KG/S.M. COMPLETELY FILL WALL CAVITY - 16 MM (5/8") TYPE "X" GYPSUM BOARD				

ARCHITECT :



WWW.DCYTARCHITECTURE.CA

7	ISSUED FOR ADDENDUM 1		
6	ISSUED FOR TENDER		
5	ISSUED FOR 80% CD		
4	ISSUED FOR BP SUBMISSION		
3	NOT ISSUED		
2	NOT ISSUED		
1	NOT ISSUED		
No.	REVISION	DATE	BY

THIS DRAWING IS THE PROPERTY OF DCYT ARCHITECTURE. REPRODUCTION OF THIS DRAWING IN WHOLE OR IN PART IS PROHIBITED UNLESS WITH WRITTEN PERMISSION.



UHNBC
FLUOROSCOPY
REPLACEMENT

1475 EDMONTON STREET, PRINCE GEORGE
BC V2M 1S2



PHASE 1 - INTER FLUORO
WALL & WINDOW
SCHEDULES

SCALE:
AS NOTED
DATE:
OCTOBER 2020
DRAWN:
RC
CHECKED:
DC
JOB No.:
DCYT2009

PHASE 1
A5.01

DOOR & FRAME SCHEDULE																									
DOOR NUMBER	LOCATION		DOOR										FRAME						GLASS				FIRE RATING		NOTES
	FROM	TO	DOOR TYPE	WIDTH	HEIGHT	THICKNESS	MATERIAL	CORE	FINISH	HARDWARE SET	LEAD LINING	MAT'L	FRAME TYPE	JAMB TYPE	HEAD TYPE	FINISH	LEAD LINING	THRESHOLD	LAM TEMPERED	TEMPERED	GEORGIAN WIRED	LOW-E			
D01	CORRIDOR 1135	NEW INTER FLUORO ROOM	B	(2) 3'-8"	7'-0"	1 3/4"	WOOD	SOLID	PAINT PT3	HW1	1.6mm (4lb)	HM	B	J1	H1	PAINT PT3	1.6mm (4lb)	T1	-	-	-	-	-	-	
D02	CORRIDOR 1094	NEW INTER FLUORO ROOM	B	(2) 3'-8"	7'-0"	1 3/4"	WOOD	SOLID	PAINT PT3	HW1	1.6mm (4lb)	HM	B	J1	H1	PAINT PT3	1.6mm (4lb)	T1	-	-	-	-	1.5 HR	-	
D03	CONTROL ROOM	EQUIPMENT ROOM	A	3'-0"	7'-0"	1 3/4"	GLASS & WOOD	SOLID	PAINT PT3	HW2	-	HM	A	J1	H1	PAINT PT3	-	T1	-	X	-	-	-	-	
NOTE: 1. RE-KEY ALL EXISTING DOOR LOCKS 2. SEE MECH DWG FOR DETAILS AND SPECS OF TRANSFER GRILLE																									
<div><div><div>DOOR TYPE</div><div></div><div><div>DOOR TYPE A (SINGLE DOOR WITH VISION PANEL)</div><div>DOOR TYPE B (INTER FLUORO ENTRANCE DOUBLE DOOR)</div></div></div><div><div>FRAME TYPE</div><div></div><div><div>FRAME TYPE A (SINGLE DOOR)</div><div>FRAME TYPE B (DOUBLE DOOR - LEADED)</div></div></div></div>																									

DOOR HARDWARE SCHEDULE					
HARDWARE #	QTY	DESCRIPTION	MANUFACTURER	SPECIFICATION	FINISH
HW1 (INTER FLUORO ROOM)	4	HINGE	MCKINNEY	4 1/2" X 4 1/2" HEAVY WT MPB68 - LEAD LINED	260
	1	LOCKSET	SCHLAGE	CLASSROOM LOCK - L9070 06B - 1/16" (4L8) LEAD LINED ON SITE	260
	1	AUTOMATIC DOOR OPERATOR	NABCO GYRO TECH	GT8500 X OPMAN EXTENDED HEADER C/W X 2 HC ACTUATORS	689
	1	ELECTRIC STRIKE	VON DUPRIN	6200 SERIES - CYLINDRICAL OR MORTISE (FOR DOOR D02 ONLY)	32D
	4	DOOR PROTECTION	ACROVYN	ACROVYN 4000 - KICK PLATE - KP-60N (COLOUR: OYSTER GRAY 929) - FIRE RATED	SUEDE
	1	ASTRAGAL	PEMKO	355_S "T" ASTRAGAL - 1/16" (4L8) LEAD LINED ON SITE	355CS
	1	PERIMETER GASKETING	PEMKO	PEMKO HSS2000X588GR - COMBINATION FIRE/SMOKE SEALING/GASKETING	-
	1	CARD READER	SEE ELEC SPECS	CARD READER TO OPERATE AUTOMATIC DOOR CLOSER (FOR DOOR D02 ONLY)	-
	2	PUSH BUTTON	SEE ELEC SPECS	PUSH BUTTON TO OPERATE AUTOMATIC DOOR CLOSER	-
	1	WALL STOP	GSH	250 (PROVIDE BACKING BEHIND DRYWALL)	260
HW2 (EQUIP. ROOM)	2	DOOR SWEEP	PEMKO	412SRL (ROOM SIDE SURFACE)	32D
	4	HINGE	MCKINNEY	4 1/2" X 4 1/2" HEAVY WT MPB68	260
	1	LOCKSET	SCHLAGE	STOREROOM LOCK - L9080 06B	260
	1	CLOSER	LCN	4040XP - PULL SIDE & METAL COVER	689
	2	DOOR PROTECTION	ACROVYN	ACROVYN 4000 - KICK PLATE - KP-60N (COLOUR: OYSTER GRAY 929) - FIRE RATED	SUEDE
	1	WALL STOP	GSH	250 (PROVIDE BACKING BEHIND DRYWALL)	260
NOTE: 1. SINGLE DOOR FRAME TO COME WITH 3 RUBBER BUMPERS ON SIDE OF FRAME AND DOUBLE DOOR FRAME WITH 2 ON TOP OF FRAME 2. ENTRANCE DOORS TO BE SEALED TO MAINTAIN ROOM PRESSURIZATION PER MECH REQUIREMENTS					

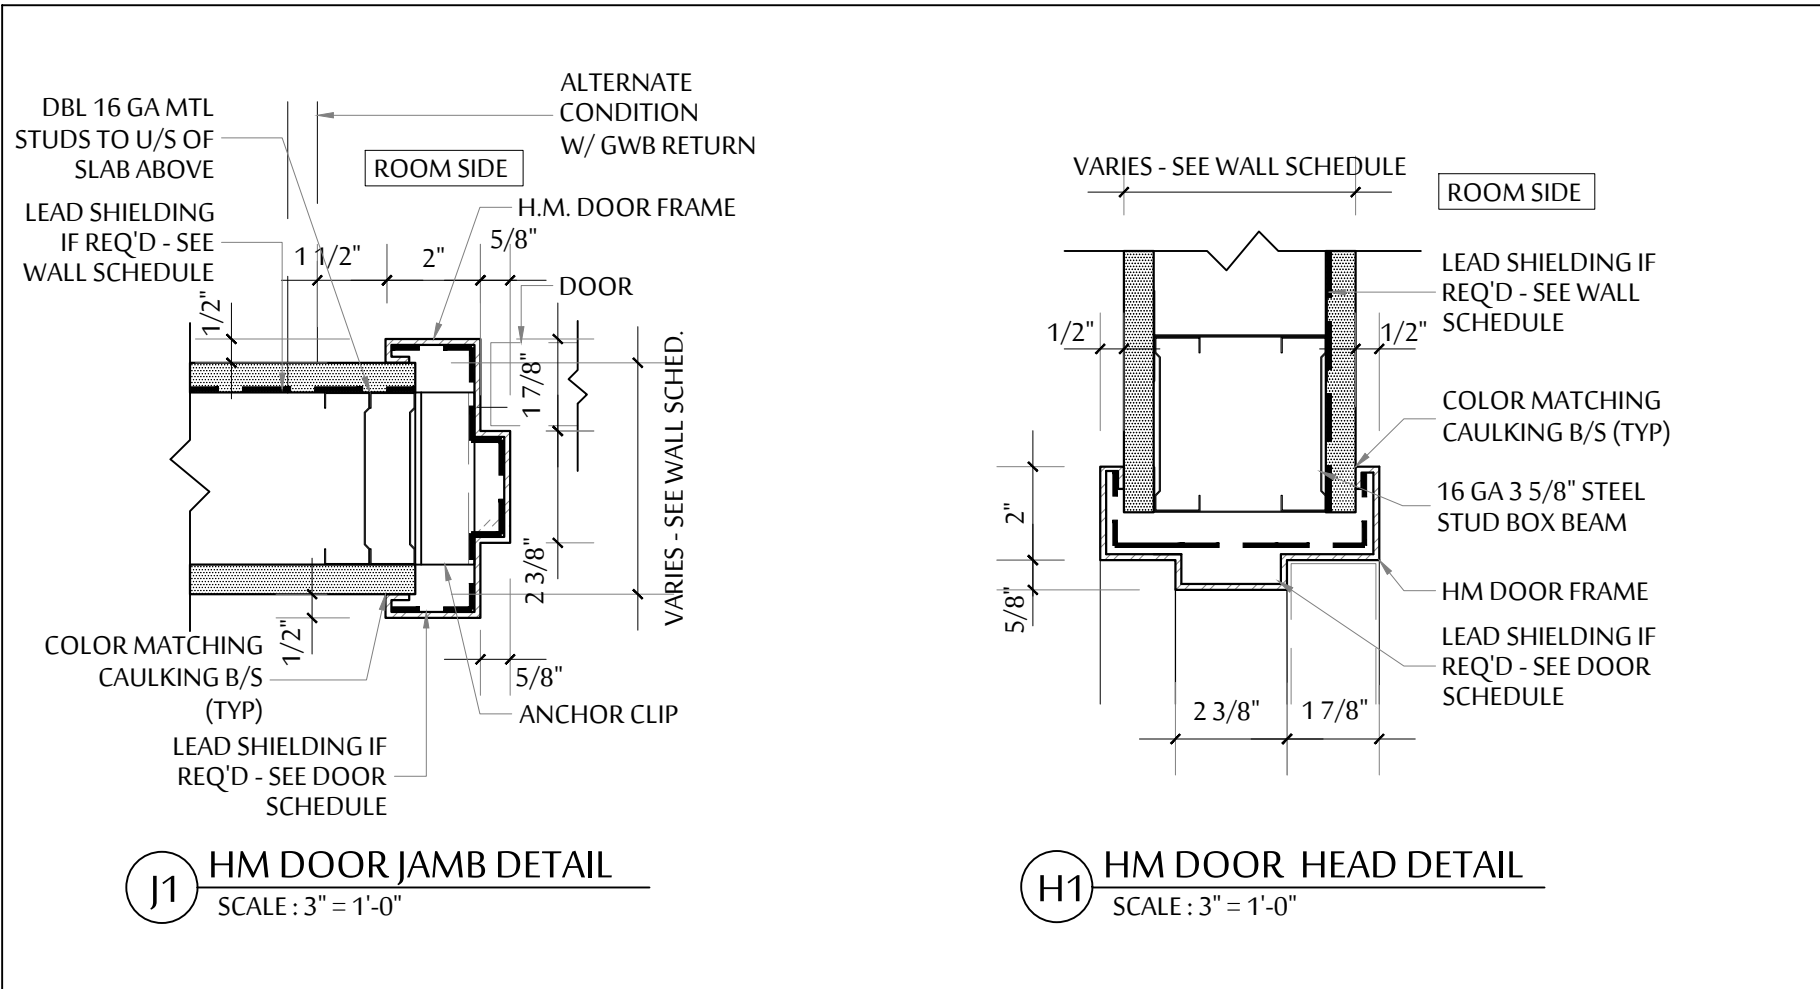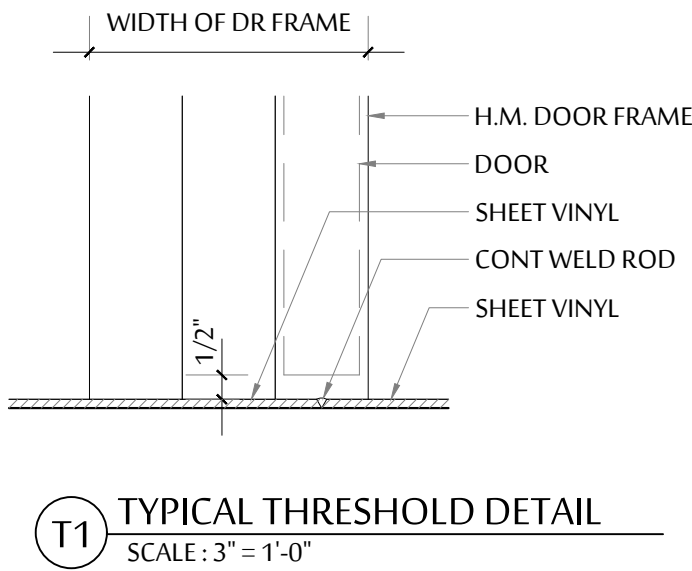

ROOM FINISH SCHEDULE									
LOCATION		WALL (SEE NOTE 2 & 3)				FLOOR (SEE NOTE 1)	BASE	CEILING	NOTES
RM #	ROOM NAME	NORTH	EAST	SOUTH	WEST				
01	INTER FLUORO ROOM	PAINT PT1	PAINT PT1	PAINT PT1	PAINT PT2	SHEET VINYL SV1	INTEGRAL COVE BASE SV1	SUSP CEILING ATC1	SEE NOTE 5
02	CONTROL ROOM	PAINT PT1	PAINT PT1	PAINT PT2	PAINT PT1	SHEET VINYL SV1	INTEGRAL COVE BASE SV1	SUSP CEILING ATC1	SEE NOTE 5
03	SURGICAL PREP AREA	PAINT PT1	PAINT PT1	PAINT PT2	PAINT PT1	SHEET VINYL SV1	INTEGRAL COVE BASE SV1	SUSP CEILING ATC1	SEE NOTE 5
04	EQUIPMENT ROOM	PAINT PT1	PAINT PT1	PAINT PT1	PAINT PT1	SHEET VINYL SV1	INTEGRAL COVE BASE SV1	SUSP CEILING ATC1	SEE NOTE 5
GENERAL NOTES: 1. PATCH & SKIM COAT TO LEVEL EX FLOOR BEFORE INSTALLING SHEET VINYL FLOOR 2. ALLOW 1 ACCENT WALL PAINT COLOR - FINAL LOCATIONS TO BE DETERMINED ON SITE 3. PATCH & MAKE GOOD EX WALLS BEFORE PROVIDING NEW PAINT FINISH 4. SEE DWG 4/AS.03 FOR INTEGRAL SHEET VINYL WALL BASE DETAIL									

FINISHES & FIXTURES SCHEDULE							
	DESCRIPTION	TYPE	SIZE	BRAND	MODEL	COLOR/FINISH	NOTES
PAINT	WALL - FIELD COLOR	PT1	-	DULUX	LIFEMASTER (ZERO VOC)	ENDURING ICE - DLX1102-1	SHEEN : EGGSHELL
	WALL - ACCENT COLOR	PT2	-	DULUX	LIFEMASTER (ZERO VOC)	EMBELLISHMENT - DLX1151-2	SHEEN : EGGSHELL
	METAL DOOR FRAME	PT3	-	DULUX	LIFEMASTER (ZERO VOC)	MOTH GRAY - DLX1024-4	SHEEN : SEMI-GLOSS
	WOOD DOOR	PT3	-	DULUX	LIFEMASTER (ZERO VOC)	MOTH GRAY - DLX1024-4	SHEEN : SEMI-GLOSS
	CEILING	PT4	-	DULUX	LIFEMASTER (ZERO VOC)	DELICATE WHITE - DLX1001-1	SHEEN : FLAT
	WOOD WINDOW FRAME	PT5	-	DULUX	LIFEMASTER (ZERO VOC)	ENDURING ICE - DLX1102-1	SHEEN : SEMI-GLOSS
FLOORING	WALL - CORRIDOR	PT6	-	DULUX	LIFEMASTER (ZERO VOC)	MATCH EXISTING	SHEEN : MATCH EXISTING
	SHEET VINYL - FIELD COLOUR	SV1	2mm THICK	JOHNSONITE	IQ GRANIT	770 SOFT FLEECE WB	SEE FINISHES PLAN DWG A2.03 FOR EXTENT
MILLWORK	SHEET VINYL - CORRIDOR BORDER INFILL	SV2	2mm THICK	MATCH EXISTING	MATCH EXISTING	MATCH EXISTING	SEE FINISHES PLAN DWG A2.03 FOR EXTENT
	PLAS LAM-UPPER CABINET	PL1	-	NEVAMAR	HIGH PRESSURE LAMINATE	GRAPHITE BLUE S3023-T	FINISH: ARP (T-)
	PLAS LAM-UPPER CABINET	PL2	-	NEVAMAR	HIGH PRESSURE LAMINATE	BONE WHITE S7032-T	FINISH: ARP (T-)
	PLAS LAM-UPPER CABINET	PL3	-	NEVAMAR	HIGH PRESSURE LAMINATE	GARDEN MIST SG0004-T	FINISH: ARP (T-)
WALL PROTECTION	DOOR HANDLE	DH1	-	RICHELIEU	1076CV	CHROME	-
	CORNER GUARD 90 DEG	CG1	3" LEG	C/S ACROVYN 4000	SM-20N	#929 OYSTER GRAY	SEE FLOOR PLAN FOR HEIGHT
	CRASH RAIL	CR1	8" H	C/S ACROVYN	SCR-80	#929 OYSTER GRAY	ALUMINUM CLIP, SURFACE MOUNTED
	CRASH RAIL	CR2	5" H	C/S ACROVYN	SCR-50	#929 OYSTER GRAY	ALUMINUM CLIP, SURFACE MOUNTED
	WALL PROTECTION	WP1	0.06" THK	C/S ACROVYN 4000	-	#929 OYSTER GRAY	COMPLETE WITH COLOUR MATCHING CAULKING AT BUTT JOINT & WAINSCOT TRIM ON EXPOSED TOP & SIDES
CEILING	WALL PROTECTION	WP2	0.09" THK	PANOLAM	FRP	WHITE (CLASSIC COLLECTION) SMOOTH (SURFACE TEXTURE)	COMPLETE WITH COLOUR MATCHING CAULKING AT BUTT JOINT & WAINSCOT TRIM ON EXPOSED TOP & SIDES
	SUSPENDED T-BAR	ATC1	15/16"	ARMSTRONG	15/16" CLEAN ROOM ALUMINUM	WHITE	
MISCELLANEOUS	ACOUSTIC CEILING PANEL		24" X 24"	ARMSTRONG	ULTIMA HEALTH ZONE HIGH NRC	WHITE	SQUARE LAY-IN PANELS NRC : 0.80 / CAC : 35
	LEAD APRON HOOK	AH1	-	BOBRICK	HEAVY-DUTY CLOTHES HOOK B-2116	SATIN NICKEL-PLATED FINISH	COMPLETE WITH CONCEALED MOUNTING PROVIDE HOOK AS REQUIRED. SEE PLAN & ELEVATIONS FOR TOTAL NUMBER
	ROLLBOARD HOOK	RH1	-	SAMARIT	ROLLBOARD WALL MOUNT	WHITE	PROVIDE BACKING AS REQUIRED
	UNDER DESK CABLE TRAY ORGANIZER	CTO1	23.6" W	PROGRESSIVE DESK	D0-06-BLACK	BLACK POWDER COATED STEEL	MOUNT TO UNDERSIDE OF DESK

ARCHITECT :




HEALTHCARE COMMERCIAL RESIDENTIAL INTERIOR DESIGN

WWW.DCYTARCHITECTURE.CA

7	ISSUED FOR ADDENDUM 1		
6	ISSUED FOR TENDER		
5	ISSUED FOR 80% CD		
4	ISSUED FOR BP SUBMISSION		
3	NOT ISSUED	-	-
2	NOT ISSUED	-	-
1	NOT ISSUED	-	-
No.	REVISION	DATE	BY

THIS DRAWING IS THE PROPERTY OF DCYT ARCHITECTURE. REPRODUCTION OF THIS DRAWING IN WHOLE OR IN PART IS PROHIBITED UNLESS WITH WRITTEN PERMISSION.



the northern way of caring

UHNBC
FLUOROSCOPY
REPLACEMENT

1475 EDMONTON STREET, PRINCE GEORGE
BC V2M 1S2

PHASE 1 - INTER FLUORO
DOOR, HARDWARE,
FINISHES & ROOM SCHED.

SCALE:
AS NOTED



DATE:
OCTOBER 2020

DRAWN:
RC





CHECKED:
DC

JOB No.:
DCYT2009

PHASE 1
A5.02

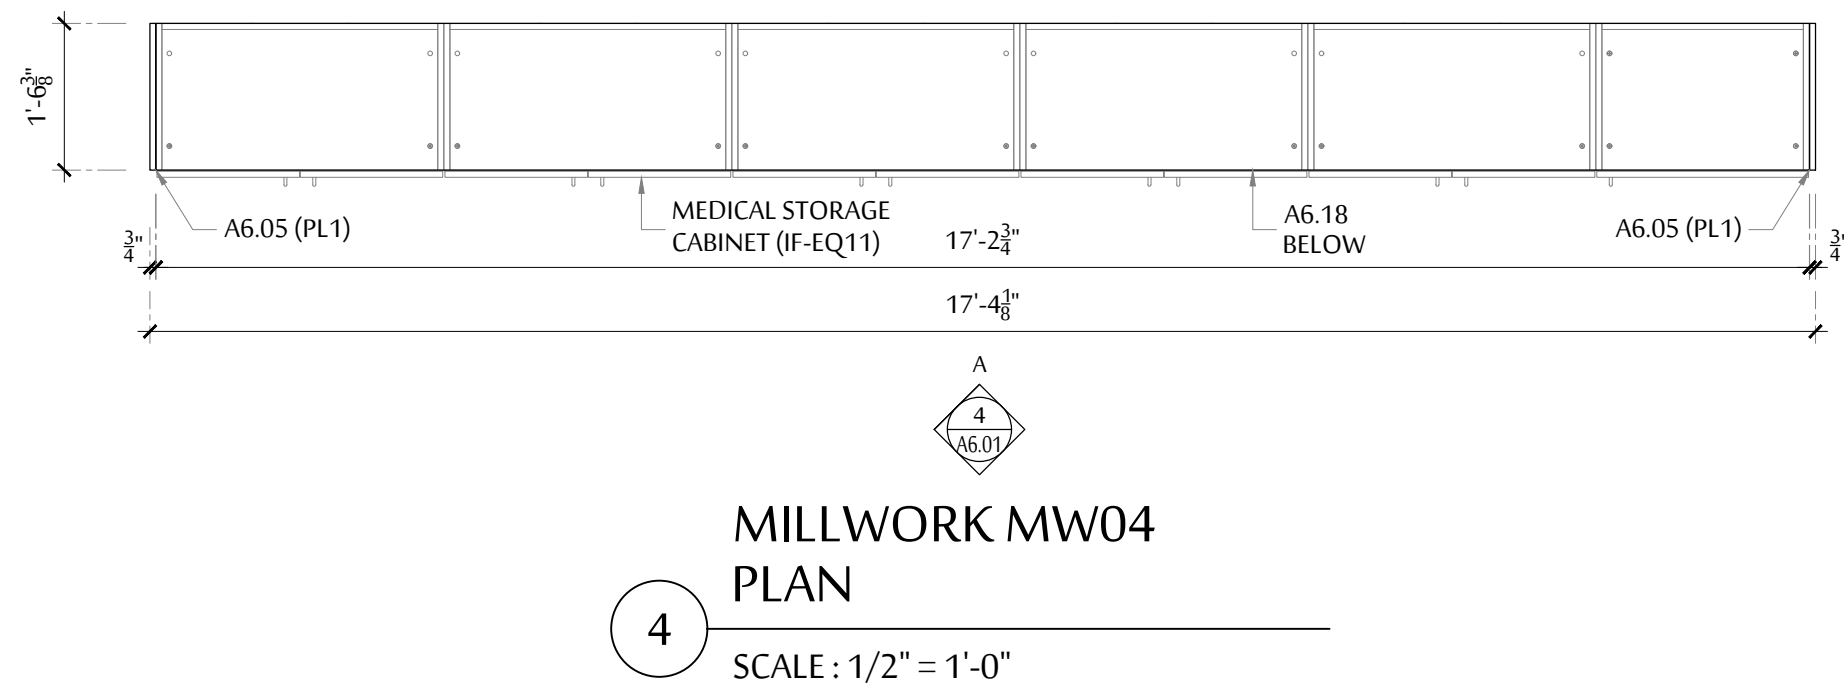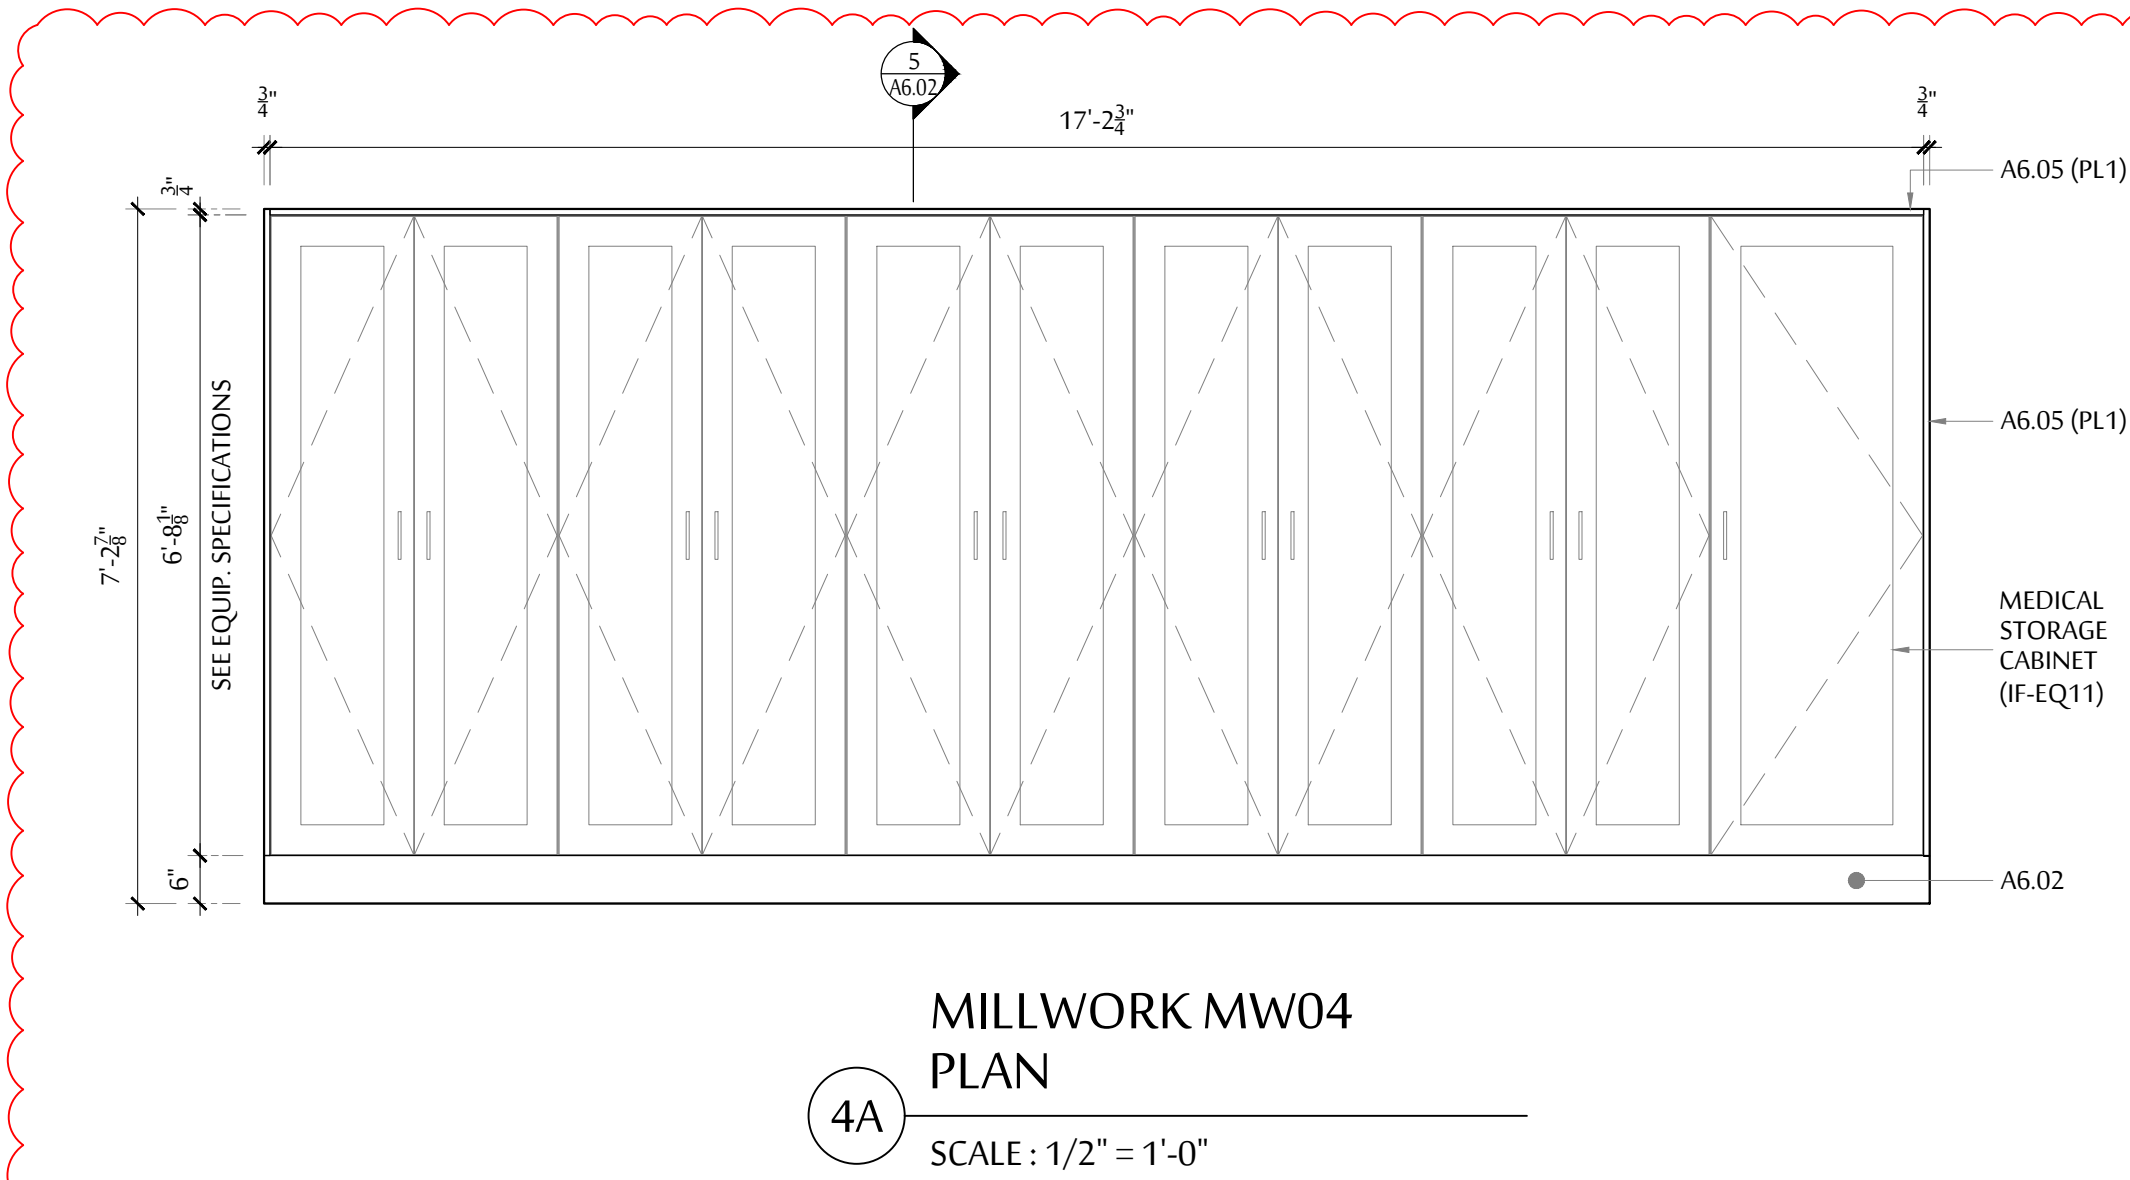

- INTERIOR KEY NOTES
1. ALL WORKS BELOW ARE NEW INCLUDING SUPPLY & INSTALLATION OF MATERIALS U.N.O.
 2. SEE DWG. A5.02 FOR FINISHES.
 3. ALL WOOD GRAIN FINISHES TO BE ORIENTED VERTICALLY WITH CLEAR LACQUERED FINISH & TO BE BOOK-MATCHED U.N.O.
 4. ALL CABINERY DOOR HINGES AND DRAWER SLIDES TO BE SOFT-CLOSING U.N.O.
 5. CASEWORK BACKS NOTED AS 'DOWEL CONSTRUCTION' MUST BE SCREWED TO CASE BODY & NAILED OR STAPLED TO DIVISIONS & FIXED SHELVES.
 6. ALL GAPS BETWEEN DOORS OR BETWEEN DOORS AND FIXED PANEL TO BE 1/16" WIDE.
- A6.01 PAINTED DRYWALL
A6.02 INTEGRAL SHEET VINYL BASE WITH TOP CAP
A6.03 WALL PROTECTION
A6.04 COVER PLATE FOR PLUMB VALVE - SEE PLUMB DWGS
A6.05 FILLER PANEL WITH MATCHING FINISH
A6.06 CABINET DOOR OR DRAWER HANDLE
A6.07 1 1/2" THK COUNTERTOP WITH PLASTIC LAMINATE FINISH & PVC ACCENT EDGING
A6.08 BASE CABINET WITH DOORS, DRAWERS OR SHELVING
A6.09 1 PIECE CONT 3/4" X 3" SUPPORTING STEEL SECTION UNDER COUNTERTOP
A6.10 BLACK SPEEDBRACE METAL BRACKET
A6.11 1 1/2" THK DESKTOP WITH PLAS LAM FINISH & PVC ACCENT EDGING
A6.12 ADJUSTABLE 3/4" THK PLYWOOD SHELF WITH PLAS LAM FINISH AND 3MM THK RIGID PVC ACCENT EDGE
A6.13 1/16" ROUTED SEAM TO BE PAINTED BLACK
A6.14 UPPER CABINET WITH DOORS
A6.15 FINISHED END, SIDE OR TOP PANEL
A6.16 FULL HEIGHT CABINET WITH ADJUSTABLE SHELVING
A6.17 36"W WIRE POWDER COATED STEEL BASKET CABLE TRAY MOUNTED TO UNDERSIDE OF DESK
A6.18 MEDICAL STORAGE CABINET BASE PER MANUFACTURER'S RECOMMENDATIONS AND REQUIREMENTS

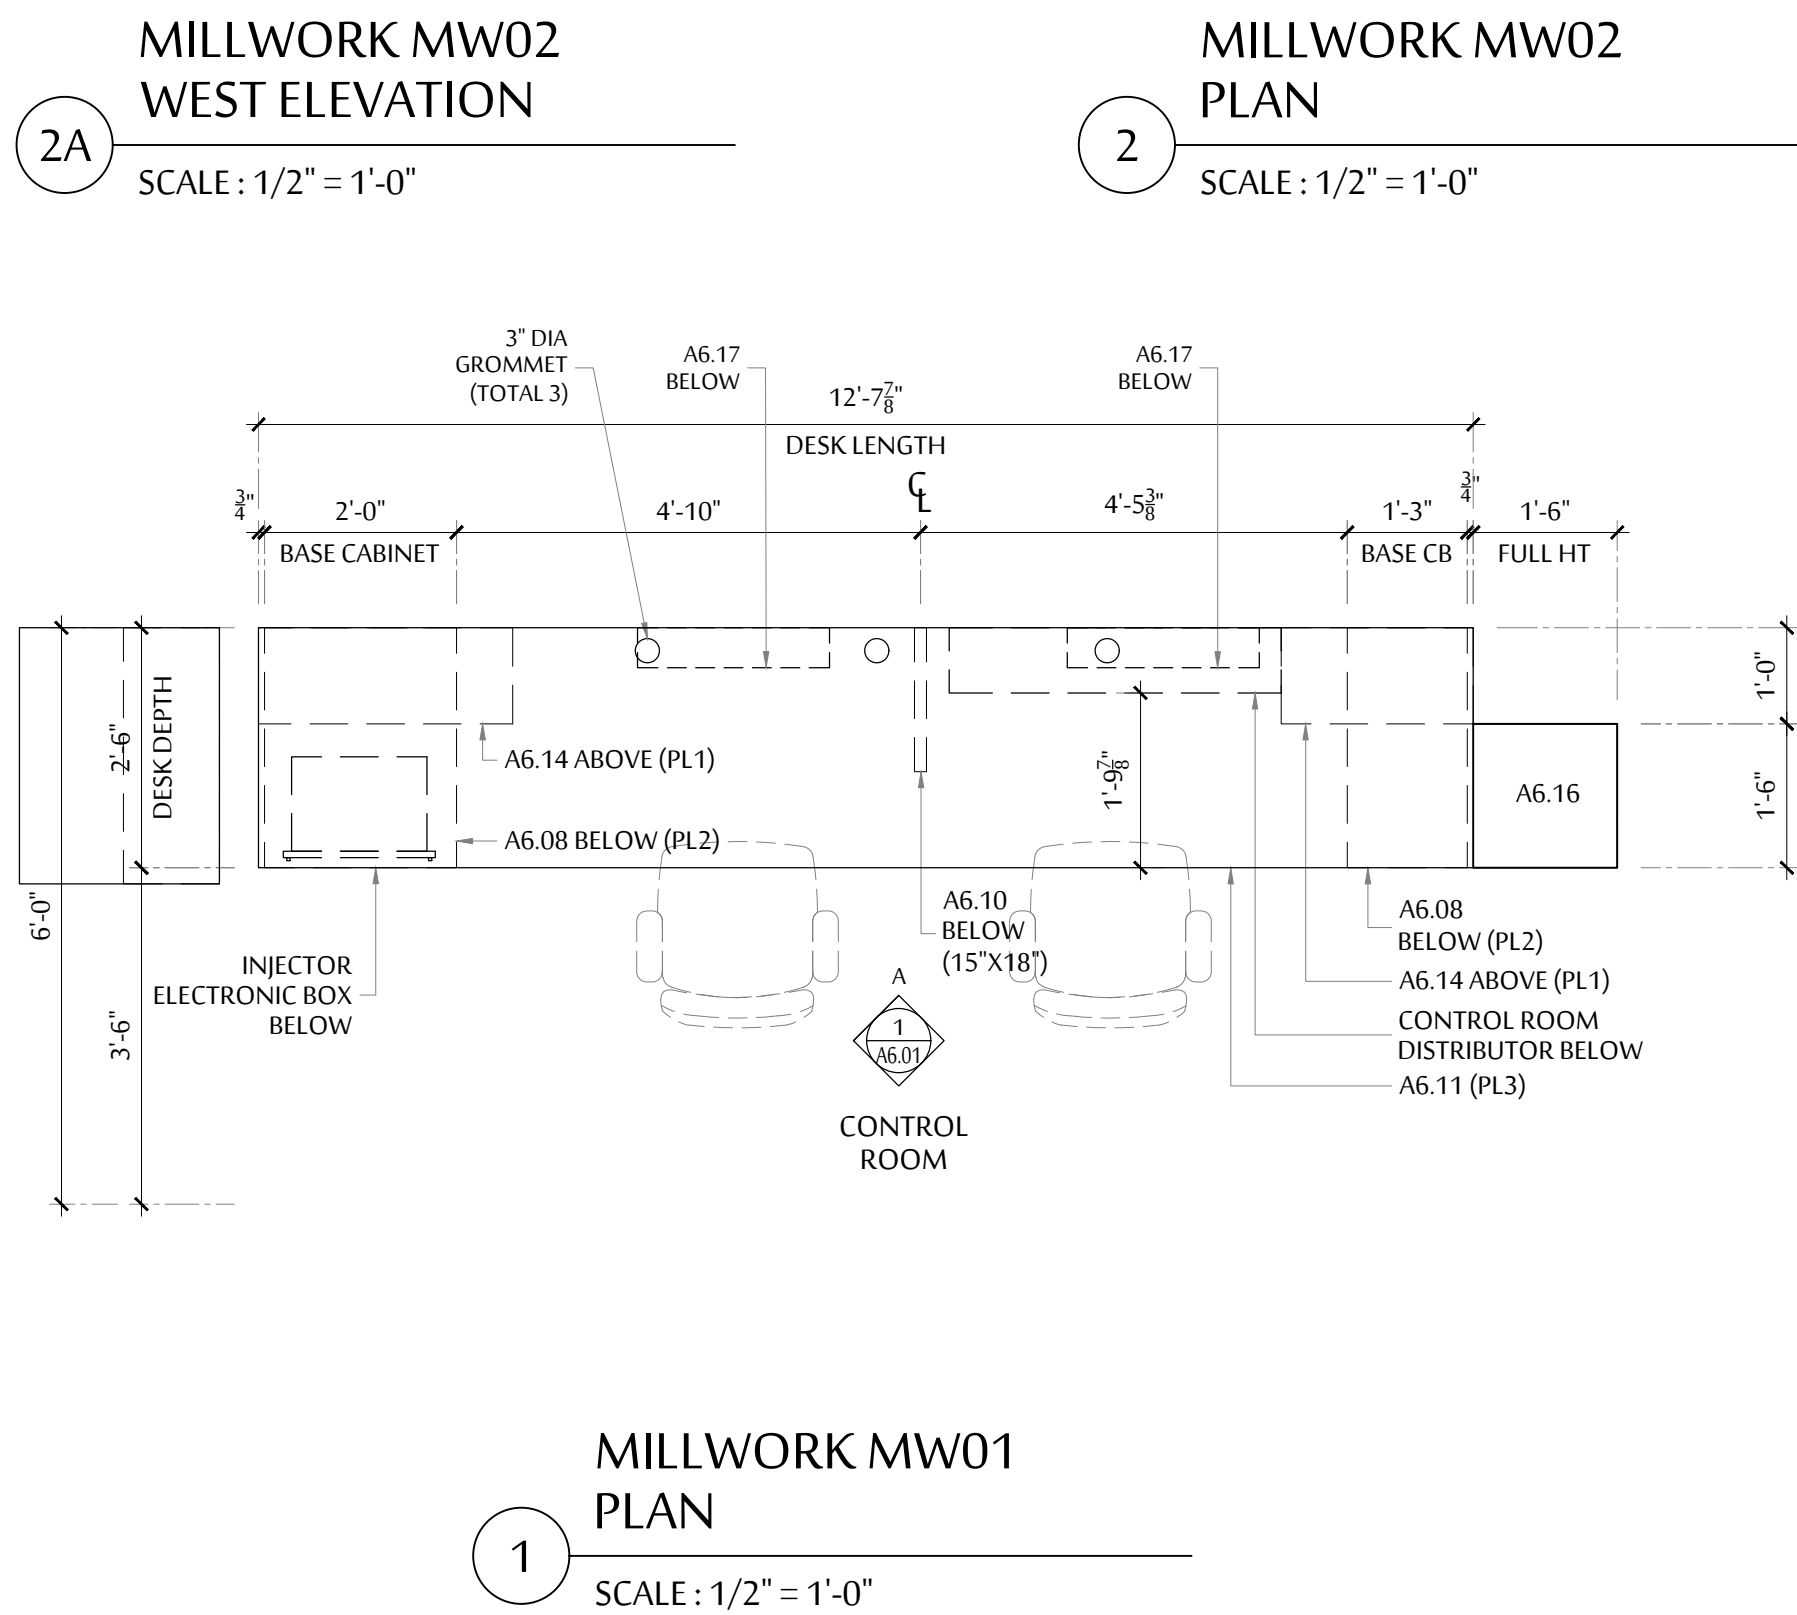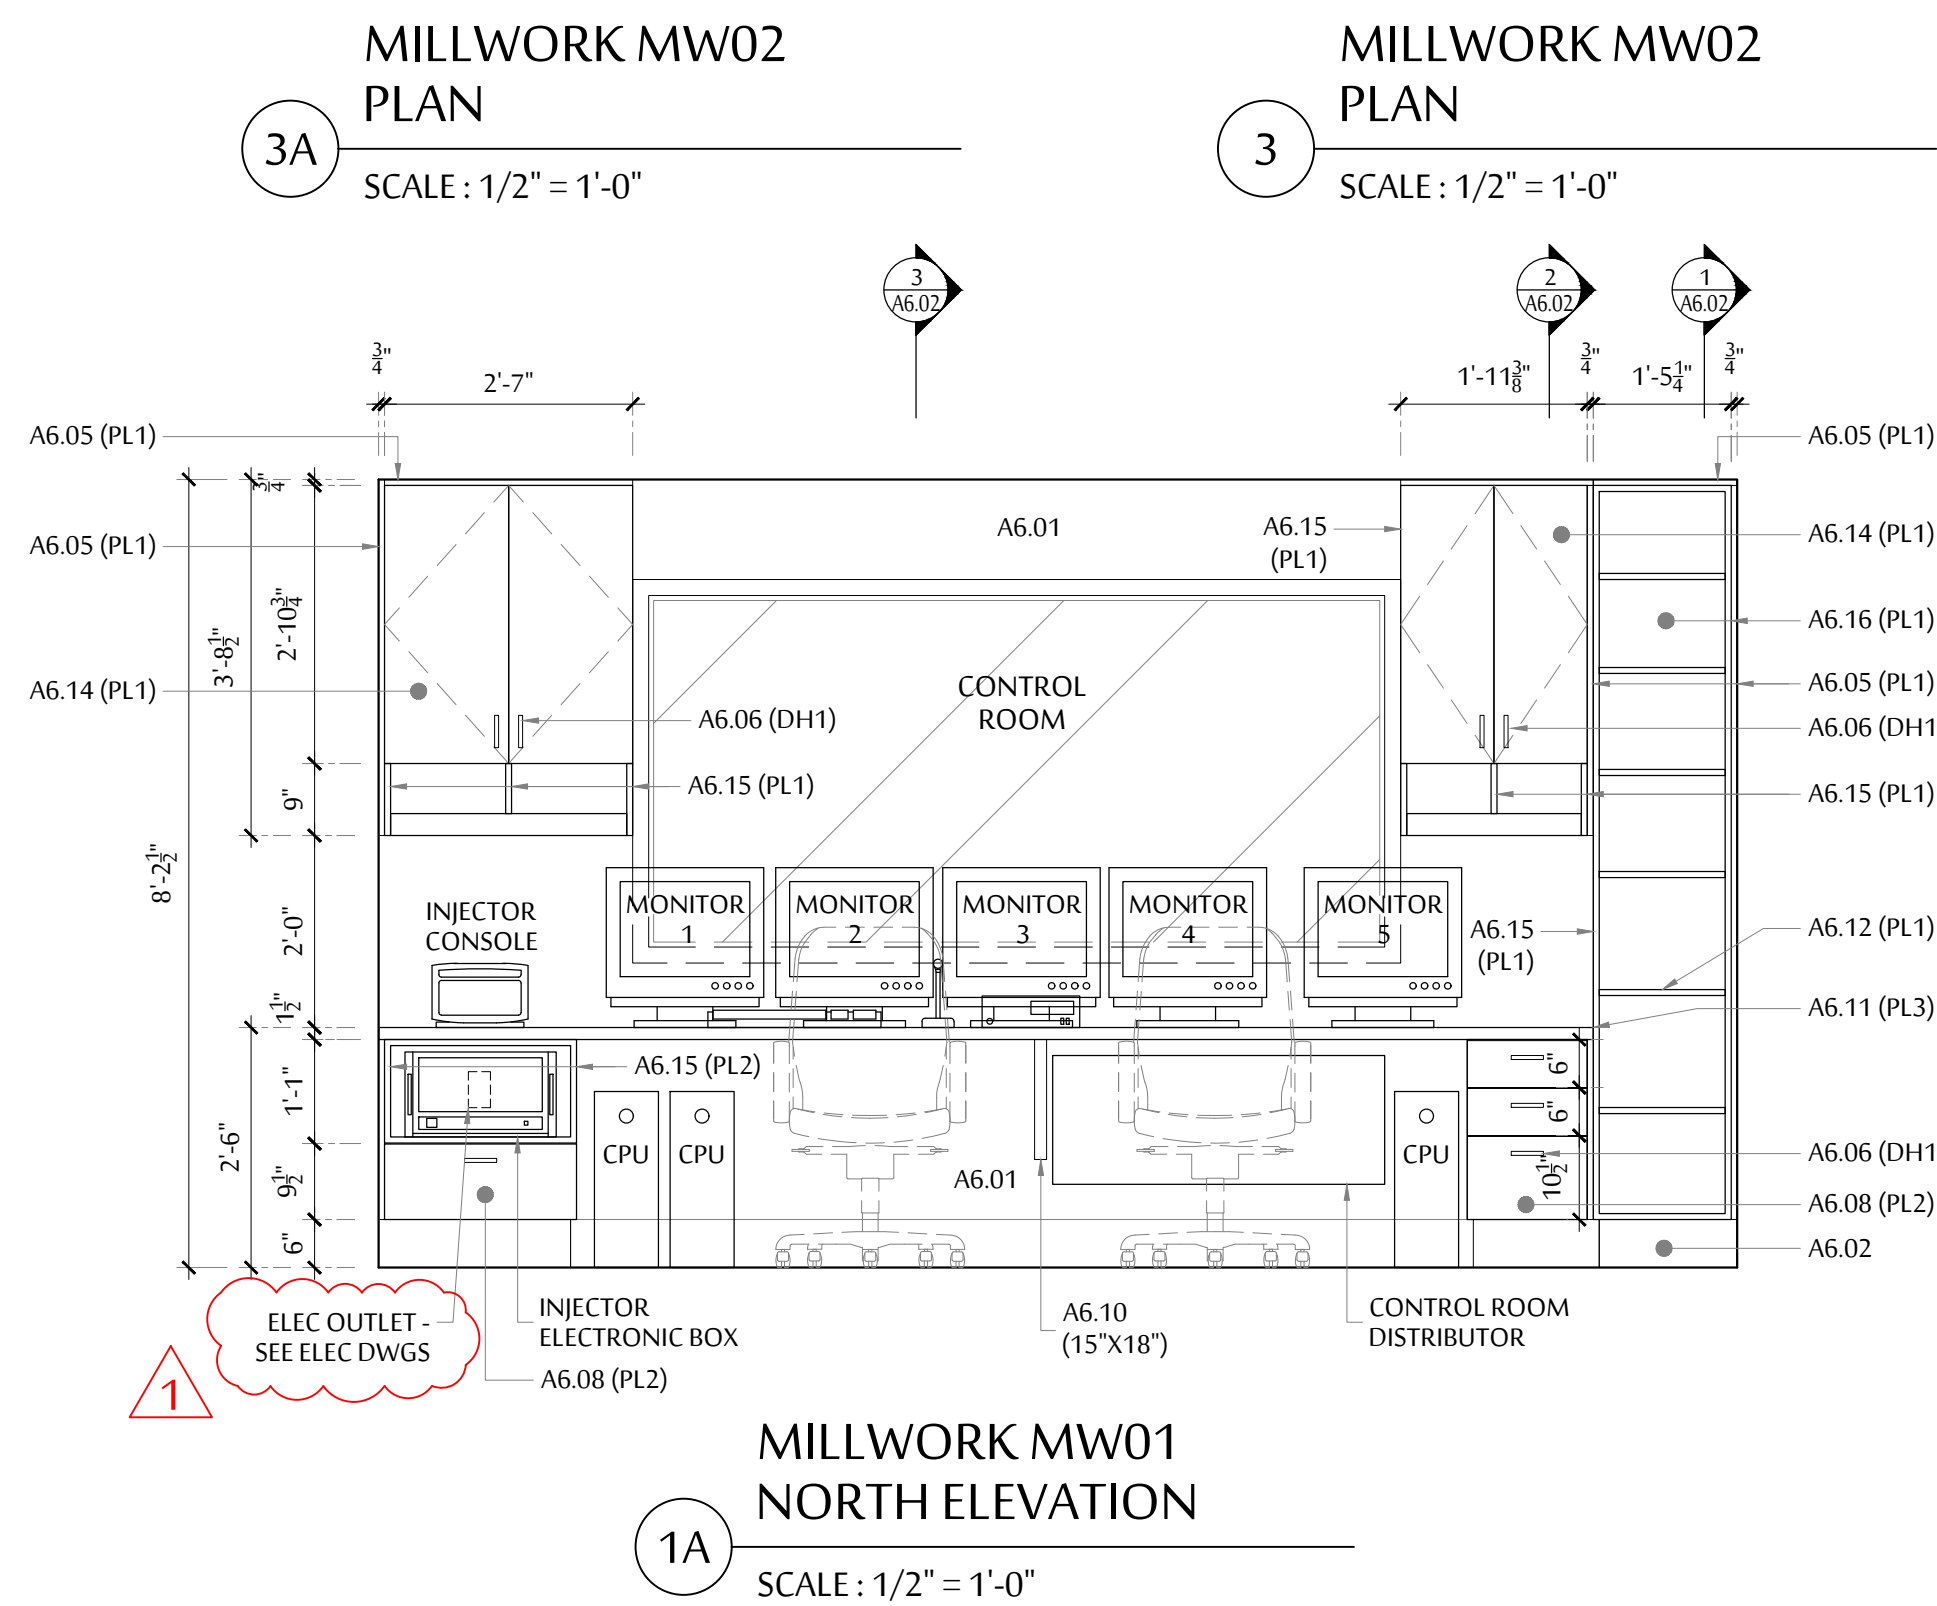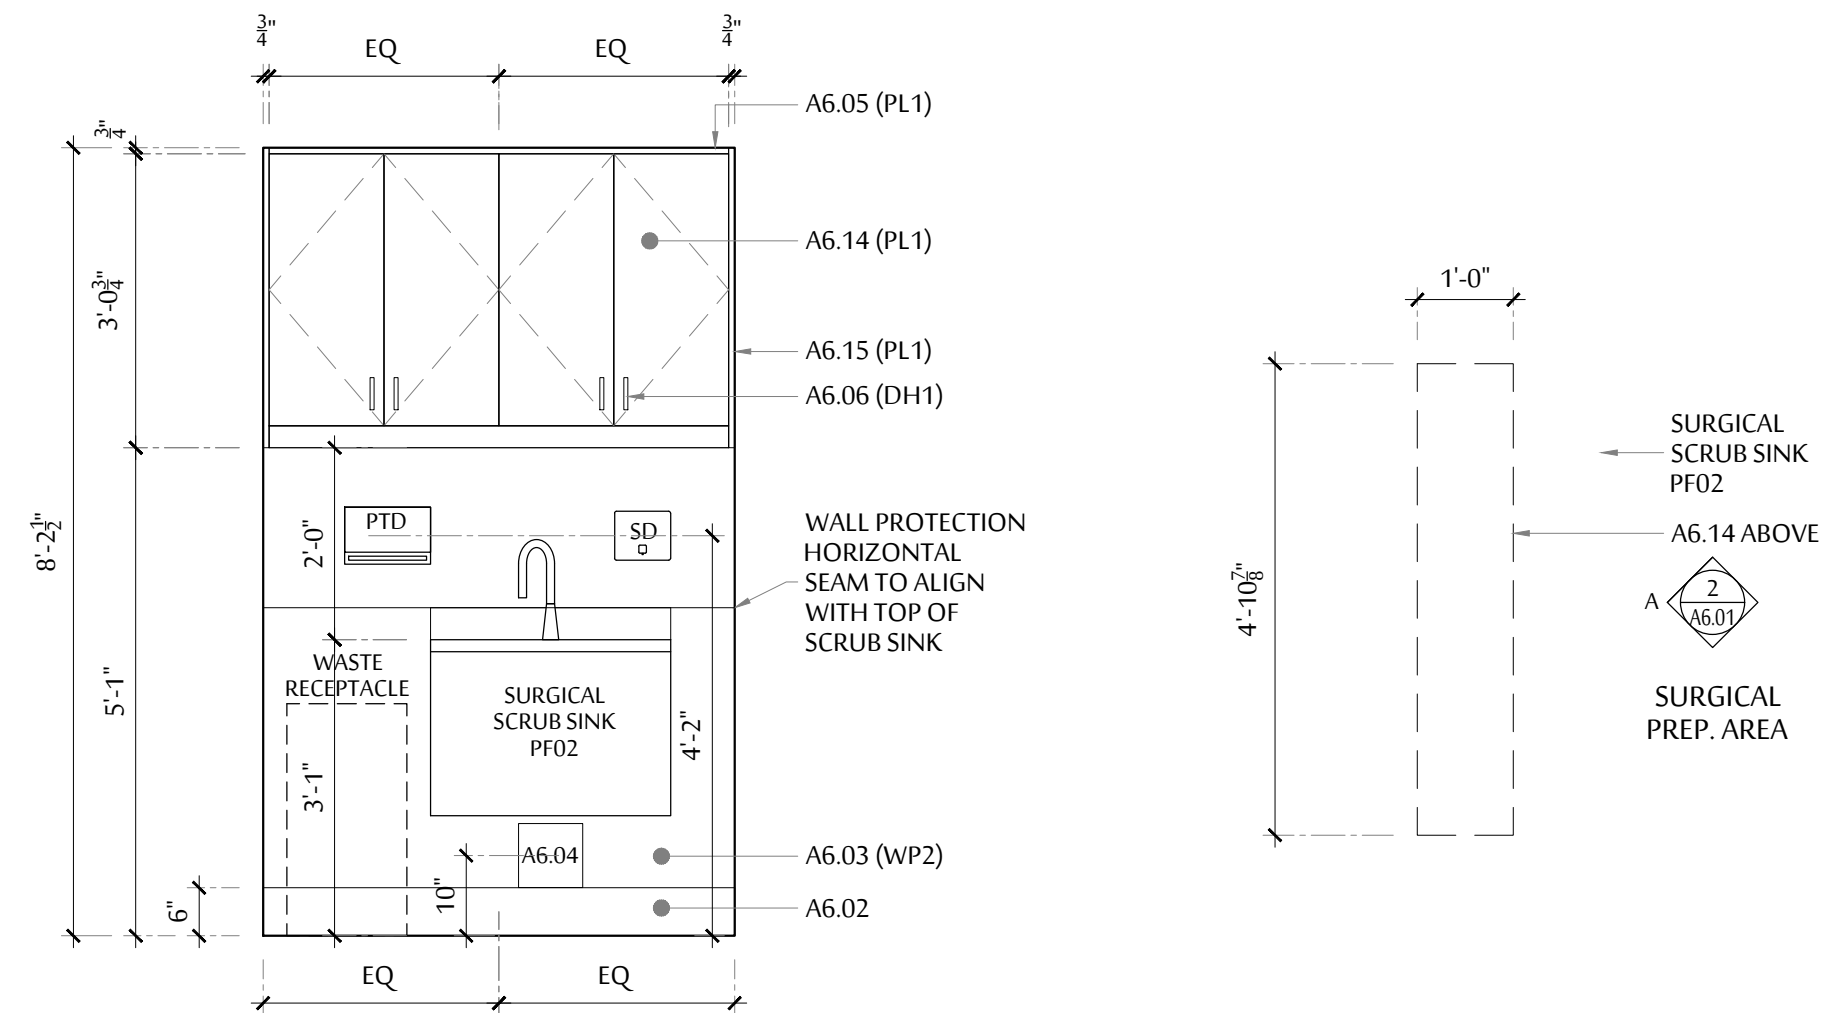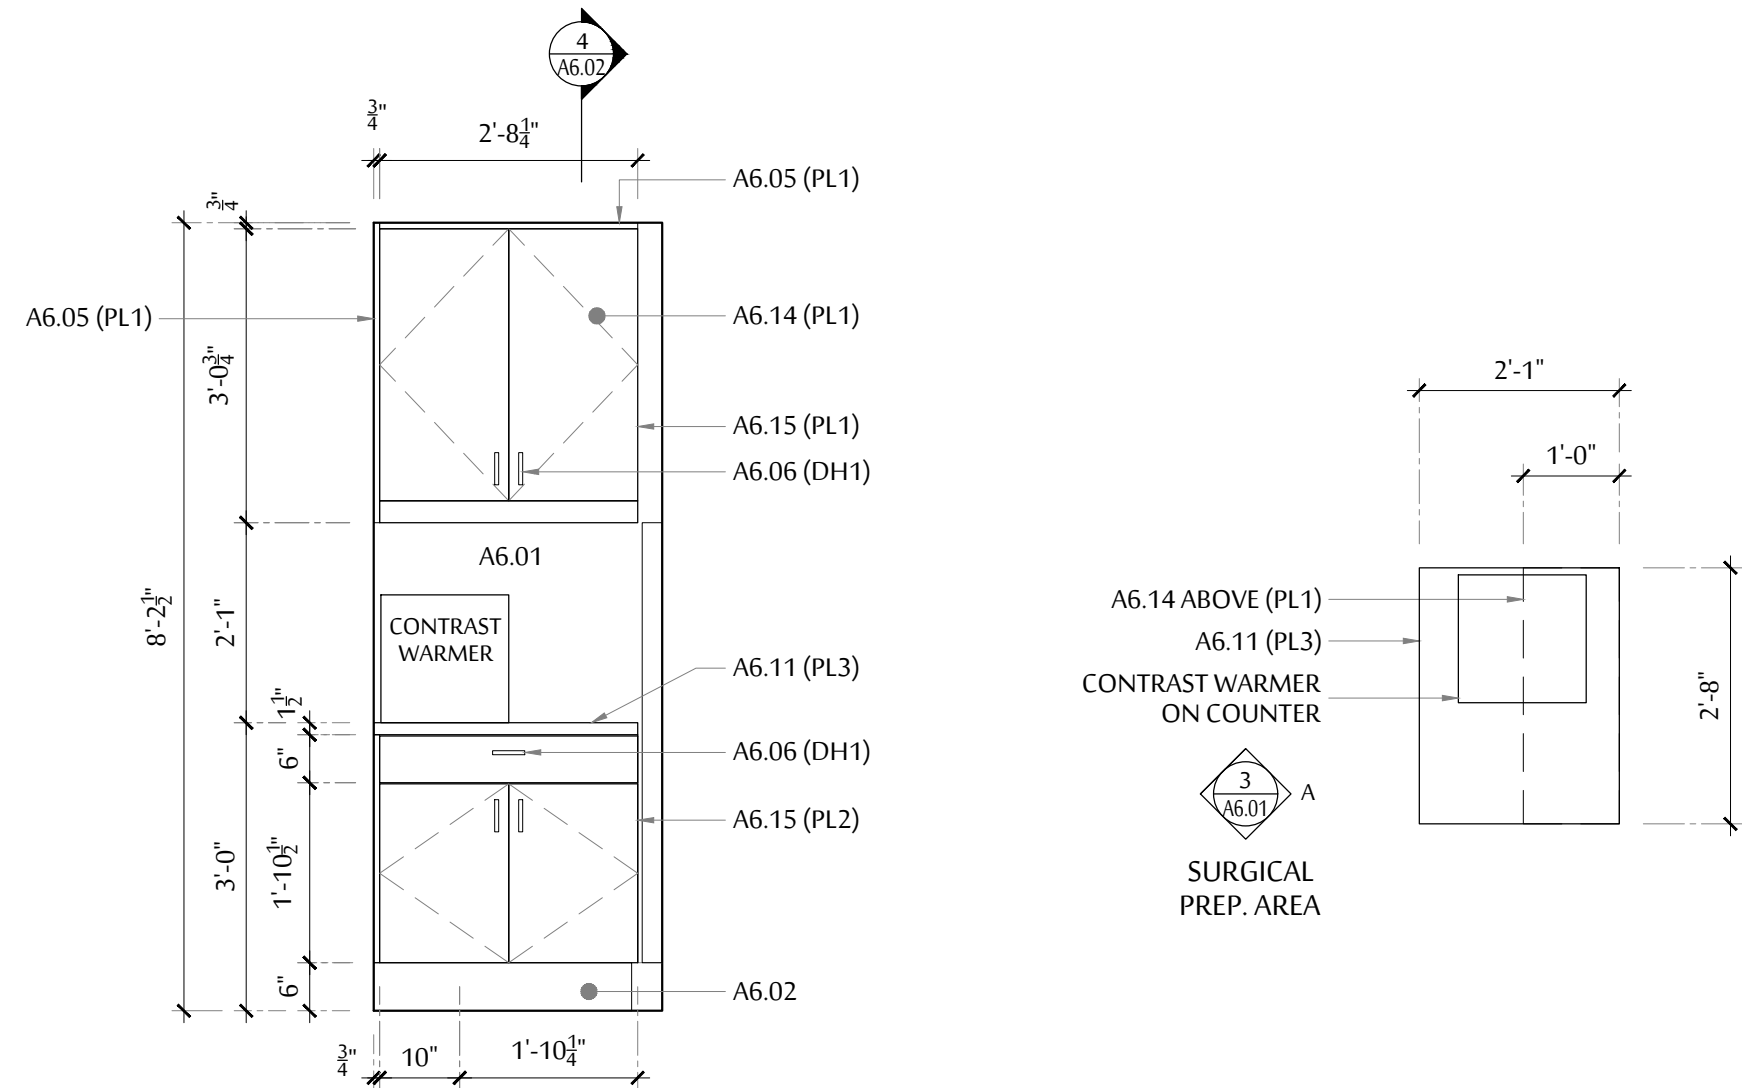

ARCHITECT :



WWW.DCYTARCHITECTURE.CA

No.	REVISION	DATE	BY
7	ISSUED FOR ADDENDUM 1	FEB 22, 2021	RC
6	ISSUED FOR TENDER	FEB 10, 2021	RC
5	NOT ISSUED	-	-
4	NOT ISSUED	-	-
3	NOT ISSUED	-	-
2	NOT ISSUED	-	-
1	NOT ISSUED	-	-

THIS DRAWING IS THE PROPERTY OF DCYT ARCHITECTURE. REPRODUCTION OF THIS DRAWING IN WHOLE OR IN PART IS PROHIBITED UNLESS WITH WRITTEN PERMISSION.



UHNBC FLUOROSCOPY REPLACEMENT

1475 EDMONTON STREET, PRINCE GEORGE BC V2M 1S2

PHASE 1 - INTER FLUORO MILLWORK PLANS & ELEVATIONS

SCALE:
AS NOTED
DATE:
OCTOBER 2020
DRAWN:
RC
CHECKED:
DC
JOB No.:
DCYT2009

PHASE 1
A6.01

ARCHITECT :



WWW.DCYTARCHITECTURE.CA

INTERIOR KEY NOTES

1. ALL WORKS BELOW ARE NEW INCLUDING SUPPLY & INSTALLATION OF MATERIALS U.N.O.
2. SEE DWG. A5.02 FOR FINISHES.
3. ALL WOOD GRAIN FINISHES TO BE ORIENTED VERTICALLY WITH CLEAR LACQUERED FINISH & TO BE BOOK-MATCHED U.N.O.
4. ALL CABINETRY DOOR HINGES AND DRAWER SLIDES TO BE SOFT-CLOSING U.N.O.
5. CASEWORK BACKS NOTED AS 'DOWEL CONSTRUCTION' MUST BE SCREWED TO CASE BODY & NAILED OR STAPLED TO DIVISIONS & FIXED SHELVES.
6. ALL GAPS BETWEEN DOORS OR BETWEEN DOORS AND FIXED PANEL TO BE 1/16" WIDE.


- M01 PAINTED DRYWALL
M02 DESKTOP WITH 3/4" THK PLYWOOD WITH PLAS LAM FINISH
M03 FILLER PANEL WITH MATCHING FINISH
M04 3/4" THK MDF CABINET DOOR OR DRAWER FRONT W/ FIR VENEER FINISH
M05 COUNTERTOP WITH 3/4" THK PLYWOOD WITH PLAS LAM FINISH
M06 FLOOR BASE - SEE MILLWORK ELEVATIONS
M07 3/4" THK TOP PANEL WITH PLAS LAM. FINISH
M08 3/4" THK END PANEL WITH PLAS LAM FINISH
M09 CABINET DOOR PULL
M10 CONT. COLOR MATCHING CAULKING WHERE MILLWORK MEETS WALL AND FLOOR AND SUSPENDED ACOUSTIC CEILING
M11 36"W WIRE POWDER COATED STEEL BASKET CABLE TRAY MOUNTED TO UNDERSIDE OF DESK
M12 3/4" THK MDF CABINET DOOR OR DRAWER FRONT WITH PLAS LAM FINISH & MATCHING EDGE BAND
M13 ADJUSTABLE RECESSED METAL SHELF STANDARDS (TYP)
M14 3/4" PLYWOOD BUILT CABINETRY WITH PLAS LAM FINISH - ALL EXPOSED FASTENERS TO BE COUNTERSUNK WITH MATCHING SCREW COVERS
M15 ADJUSTABLE 3/4" THK PLYWOOD SHELF WITH PLAS LAM FINISH AND 3MM THK RIGID PVC ACCENT EDGE
M16 LED STRIP LIGHTING WHERE INDICATED ON ELEC. DWG.
M17 1 1/2" W X 1/8" THK THICK PVC ACCENT EDGING
M18 BLACK SPEEDBRACE METAL BRACKET
M19 WOOD BLOCK FRAMING
M20 1 1/2" THK END OR SIDE PANEL WITH PLAS LAM FINISH
M21 3/4" PLYWOOD BUILT DRAWER CABINET WITH PLAS LAM FINISH - ALL EXPOSED FASTENERS TO BE COUNTERSUNK WITH MATCHING SCREW COVERS
M22 FIXED 3/4" THK PLYWOOD SHELF WITH PLAS LAM FINISH AND 3MM THK RIGID PVC ACCENT EDGE
M23 3/4" THK MDF CABINET DOOR WITH 2" WIDE ANODIZED ALUM FRAME AND FROSTED GLASS PANEL
M24 3/4" THK PANEL WITH FIR VENEER FINISH
M25 3/4" THK QUARTZ COUNTERTOP ON (2) 3/4" THK PLYWOOD
M26 3/4" THK SOLID SURFACING COUNTERTOP ON 3/4" THK PLYWOOD WITH 1 1/2" THK SQUARE EDGE SOLID SURFACING NOSING & INTEGRAL 4" BACKSPLASH
M27 1/2" MONOLITHIC CLEAR, TEMPERED GLASS - SEE WINDOW SCHEDULE A5.01 FOR DETAILS
M28 3/4" THICK QUARTZ COUNTERTOP ON 3/4" THICK PLYWOOD BACKING
M29 1 1/2" THICK PLYWOOD COUNTER TOP WITH FIR VENEER FINISH (NOT USED)
M30 4 1/2" HIGH 18 GA STAINLESS STEEL TOE PLATE
M31 1 1/2" DEEP 1/8" THK STAINLESS STEEL U-CHANNEL W/ SATIN FINISH ANCHORED TO RECEPTION DESK - SEE WINDOW SCHEDULE A5.01 FOR DETAILS
M32 1 PIECE CONT. 3/4" X 3' SUPPORTING STEEL SECTION UNDER COUNTERTOP
M33 3/4" PLYWOOD DIVIDER FINISHED WITH FIR VENEER BOTH SIDES
M34 1/2" THK PANEL WITH FIR VENEER FINISH
M35 2 1/4" DEEP 1/8" THK STAINLESS STEEL U-CHANNEL W/ SATIN FINISH - SEE WINDOW SCHEDULE A5.01 FOR DETAILS
M36 WALL PROTECTION - SEE FINISH SCHEDULE

MEDICAL STORAGE CABINET SECTION

SCALE : 1" = 1'-0"

5


1

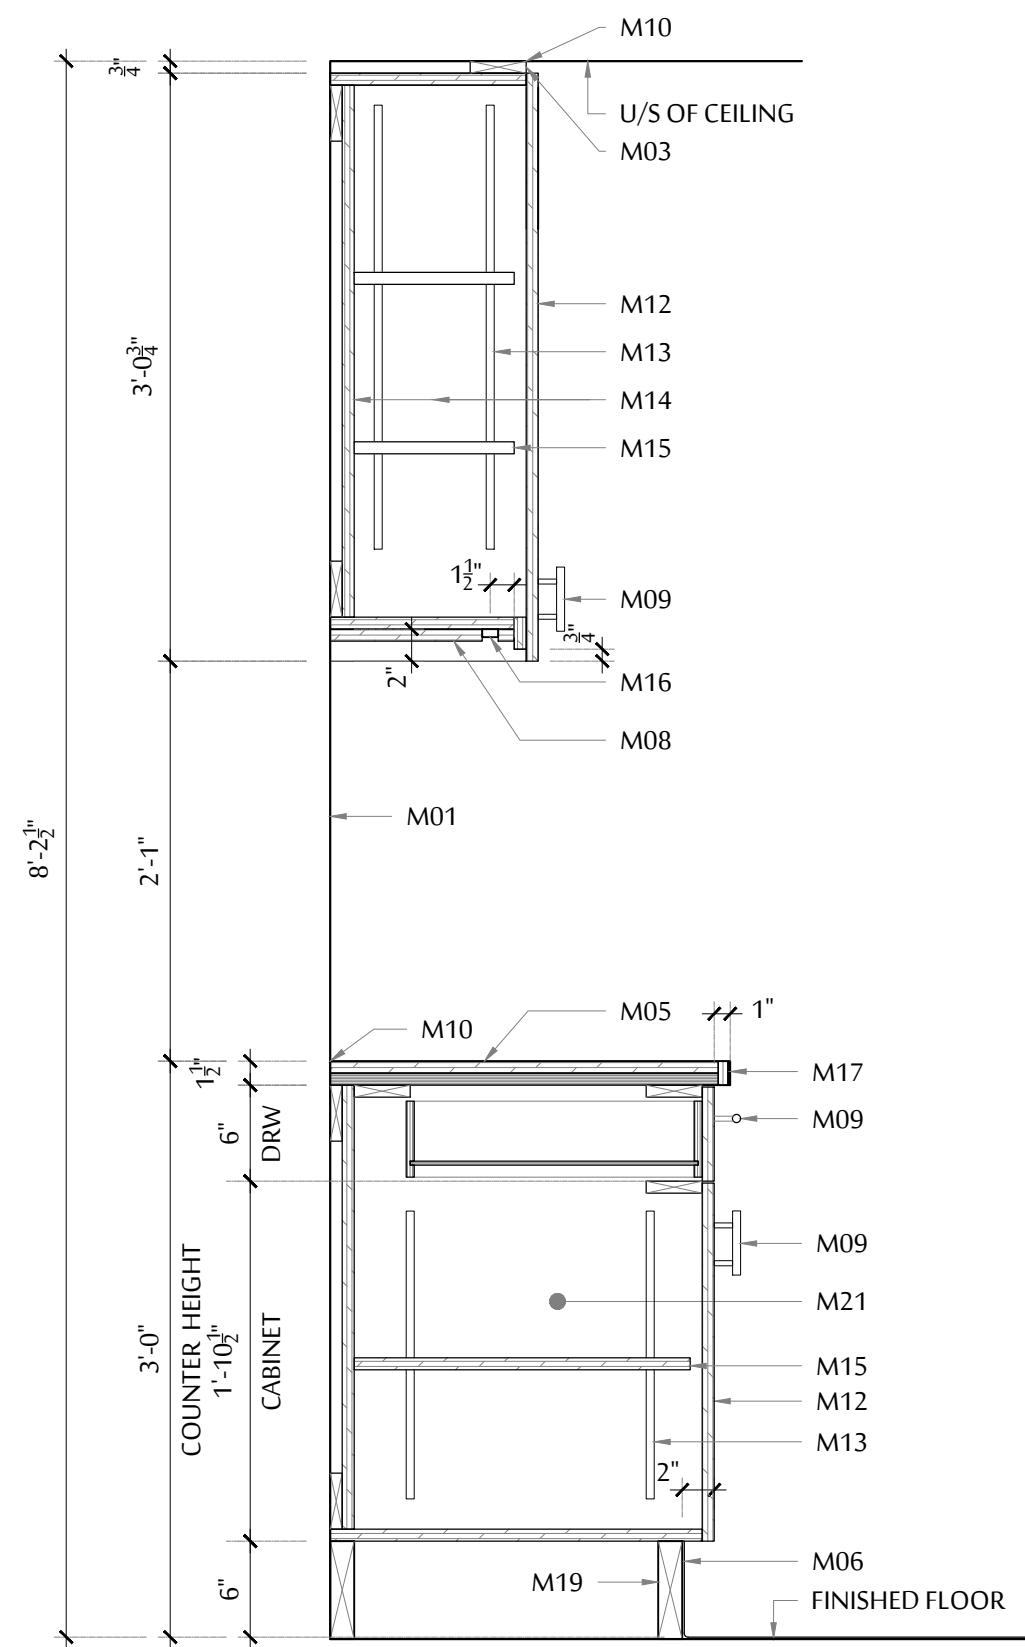

UPPER & LOWER CABINET SECTION

SCALE : 1" = 1'-0"


4

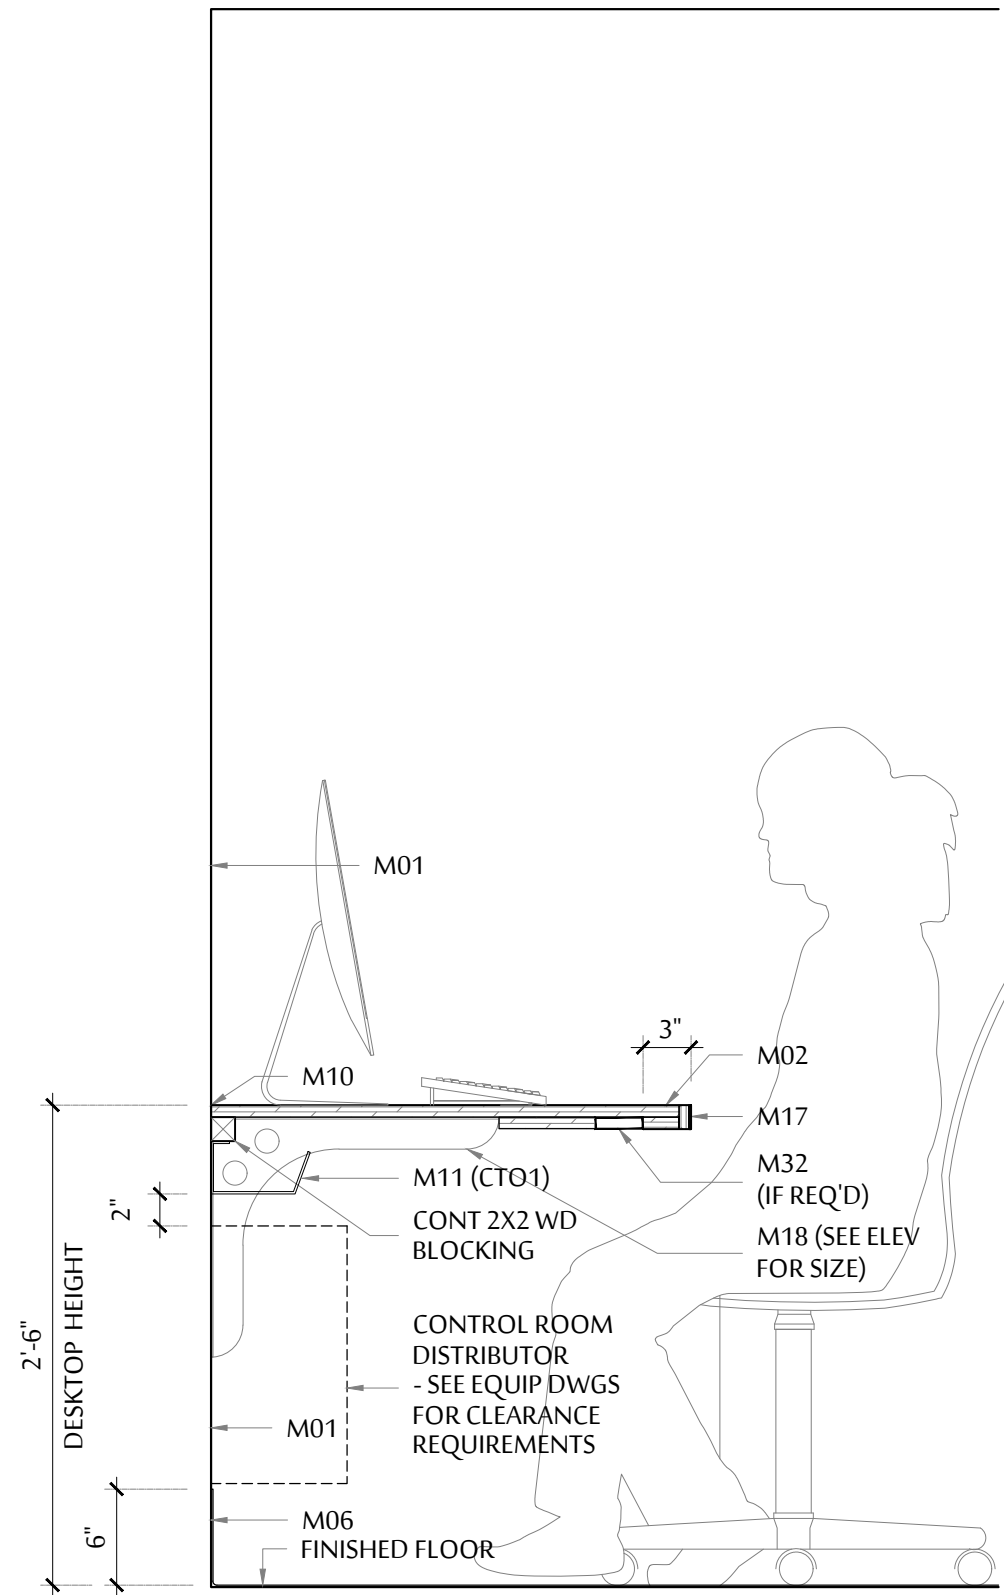

CONTROL ROOM DESKTOP SECTION

SCALE : 1" = 1'-0"


3

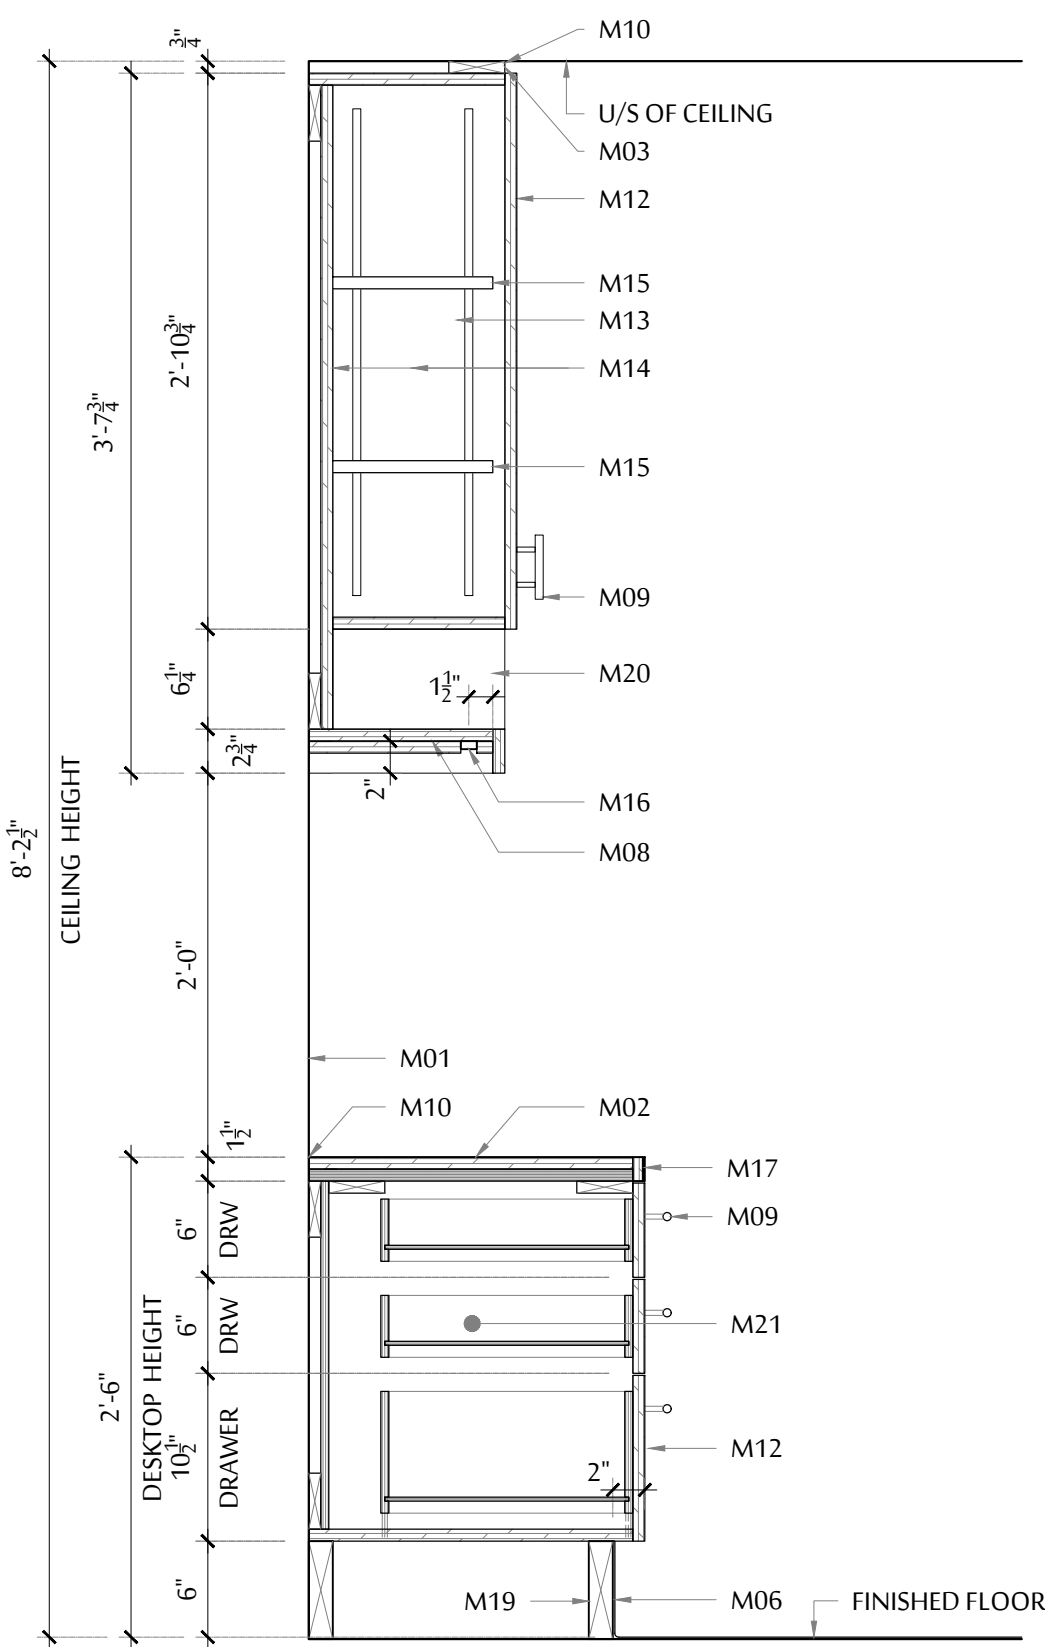

OFFICE DESKTOP UPPER & LOWER CABINET SECTION

SCALE : 1" = 1'-0"

2

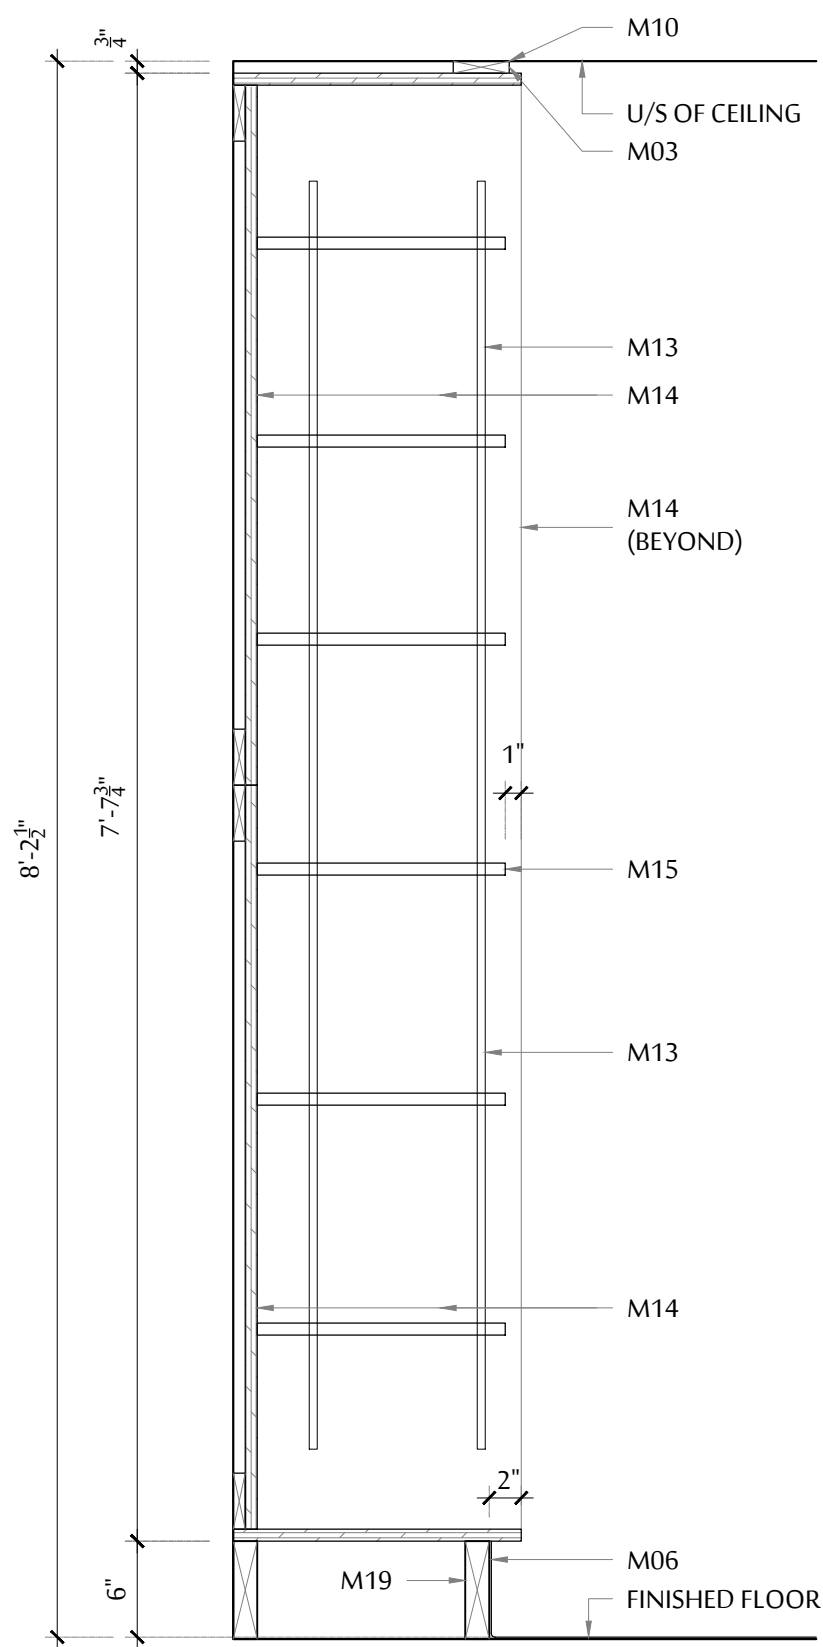

FULL HEIGHT CABINET SECTION (TYPICAL)

SCALE : 1" = 1'-0"

1

NO.	REVISION	DATE	BY
7	ISSUED FOR ADDENDUM 1	FEB 22, 2021	RC
6	ISSUED FOR TENDER	FEB 10, 2021	RC
5	NOT ISSUED	-	-
4	NOT ISSUED	-	-
3	NOT ISSUED	-	-
2	NOT ISSUED	-	-
1	NOT ISSUED	-	-

THIS DRAWING IS THE PROPERTY OF DCYT ARCHITECTURE. REPRODUCTION OF THIS DRAWING IN WHOLE OR IN PART IS PROHIBITED UNLESS WITH WRITTEN PERMISSION.









UHNBC FLUOROSCOPY REPLACEMENT

1475 EDMONTON STREET, PRINCE GEORGE BC V2M 1S2

PHASE 1 - INTER FLUORO MILLWORK SECTIONS

SCALE:
AS NOTED
DATE:
OCTOBER 2020
DRAWN:
RC
CHECKED:
DC
JOB No.:
DCYT2009

PHASE 1
A6.02

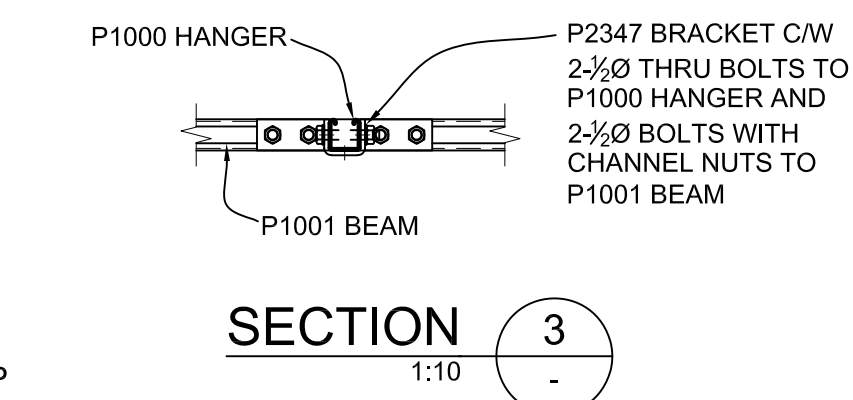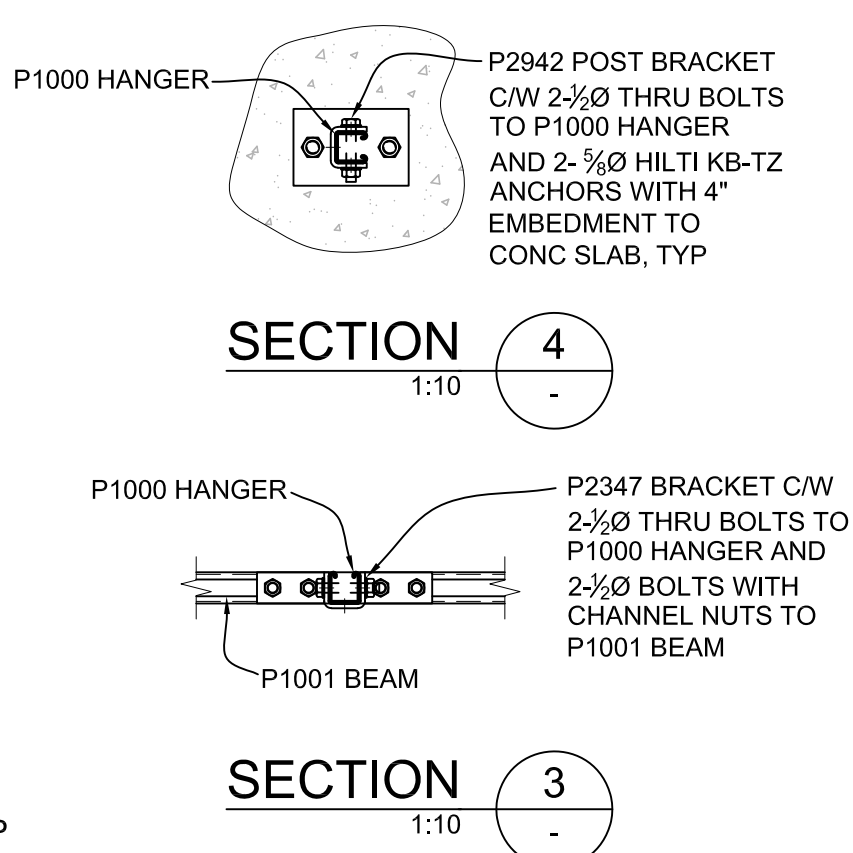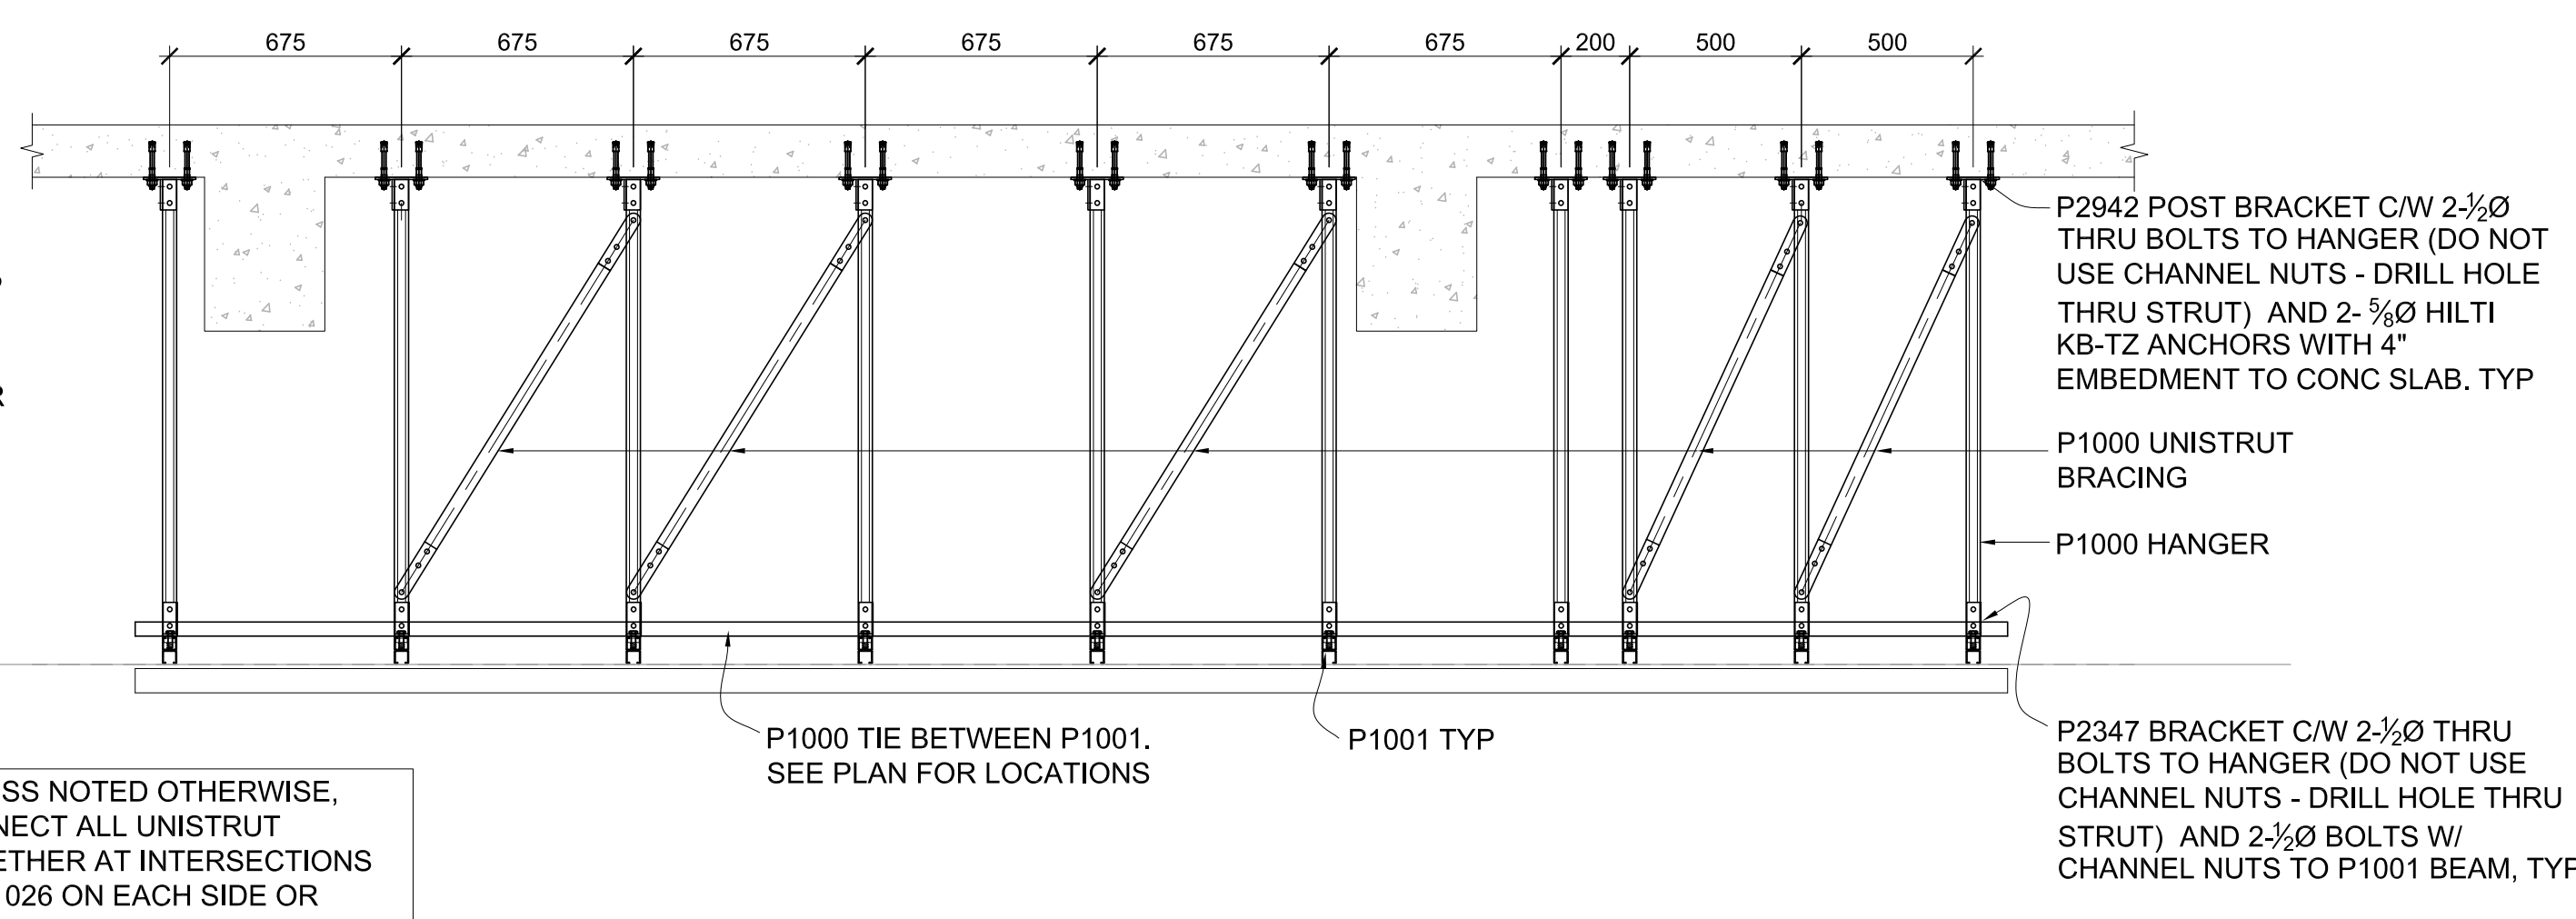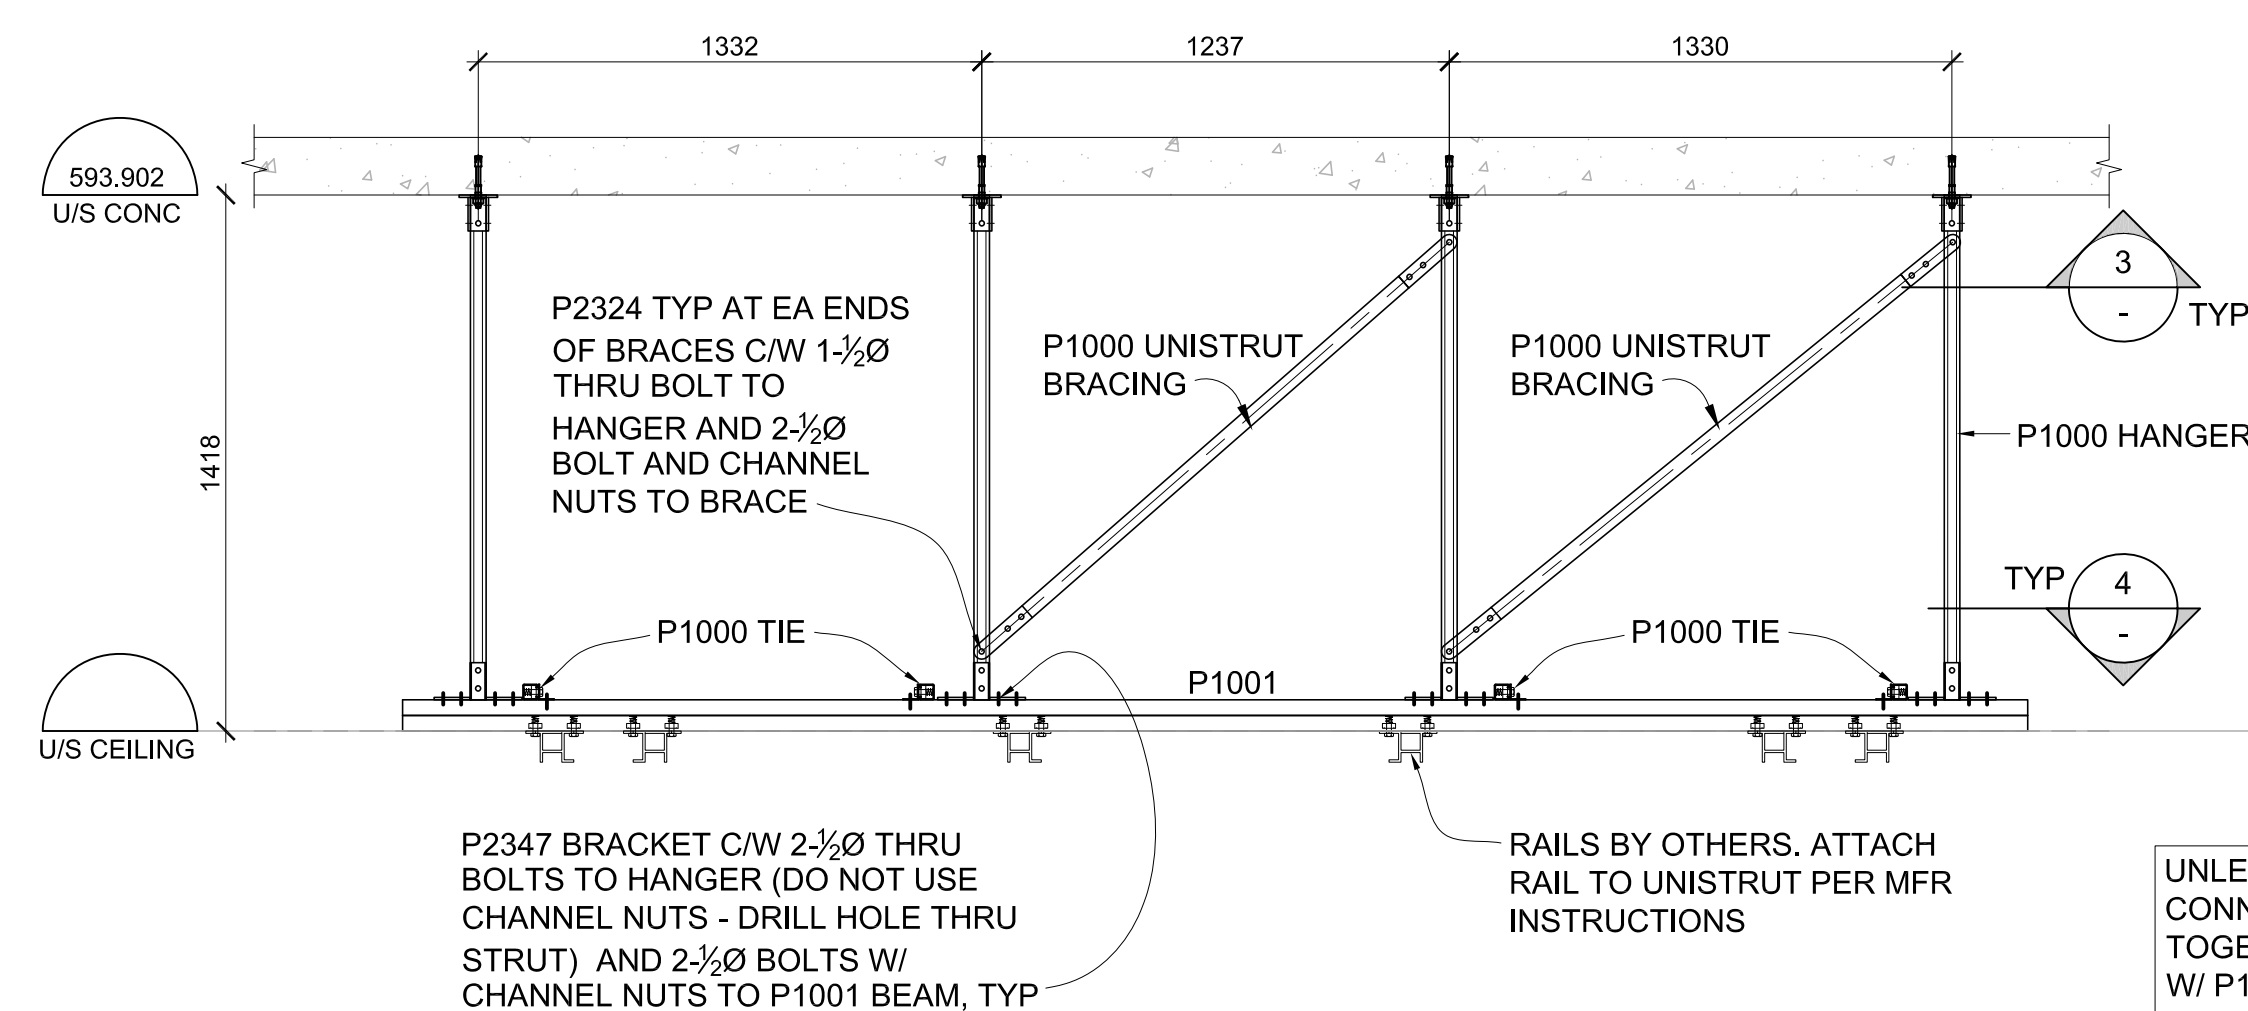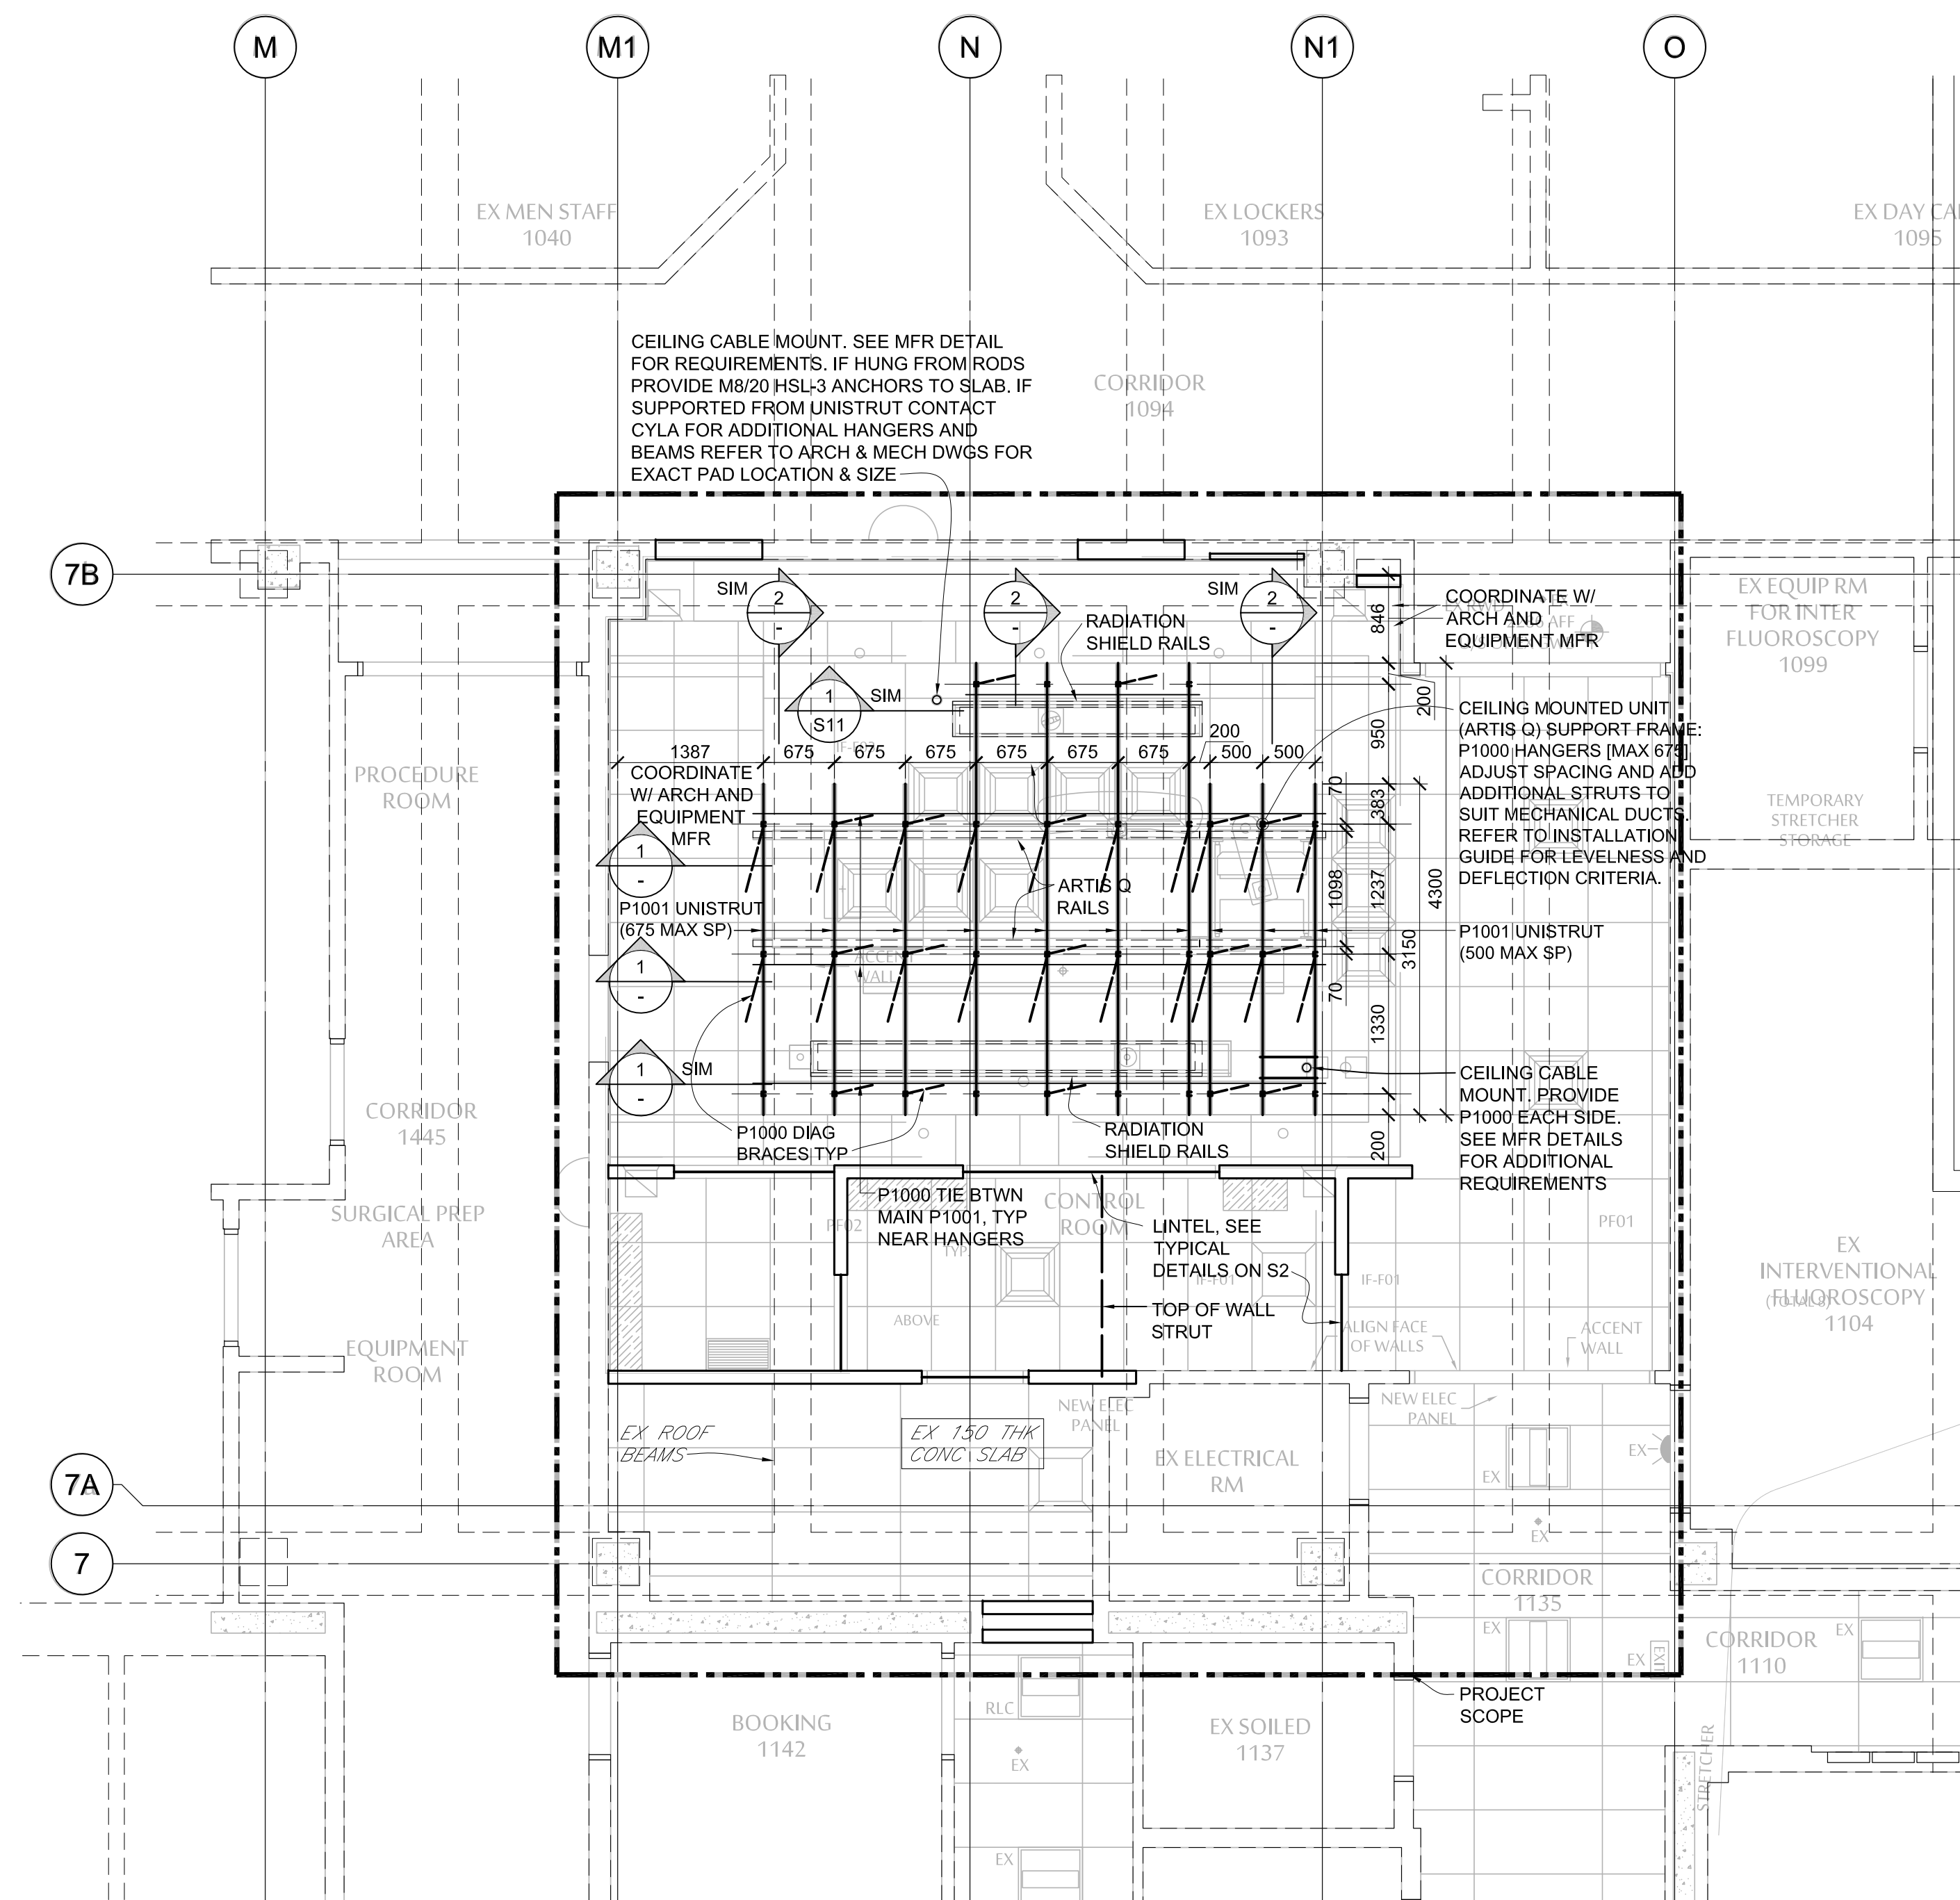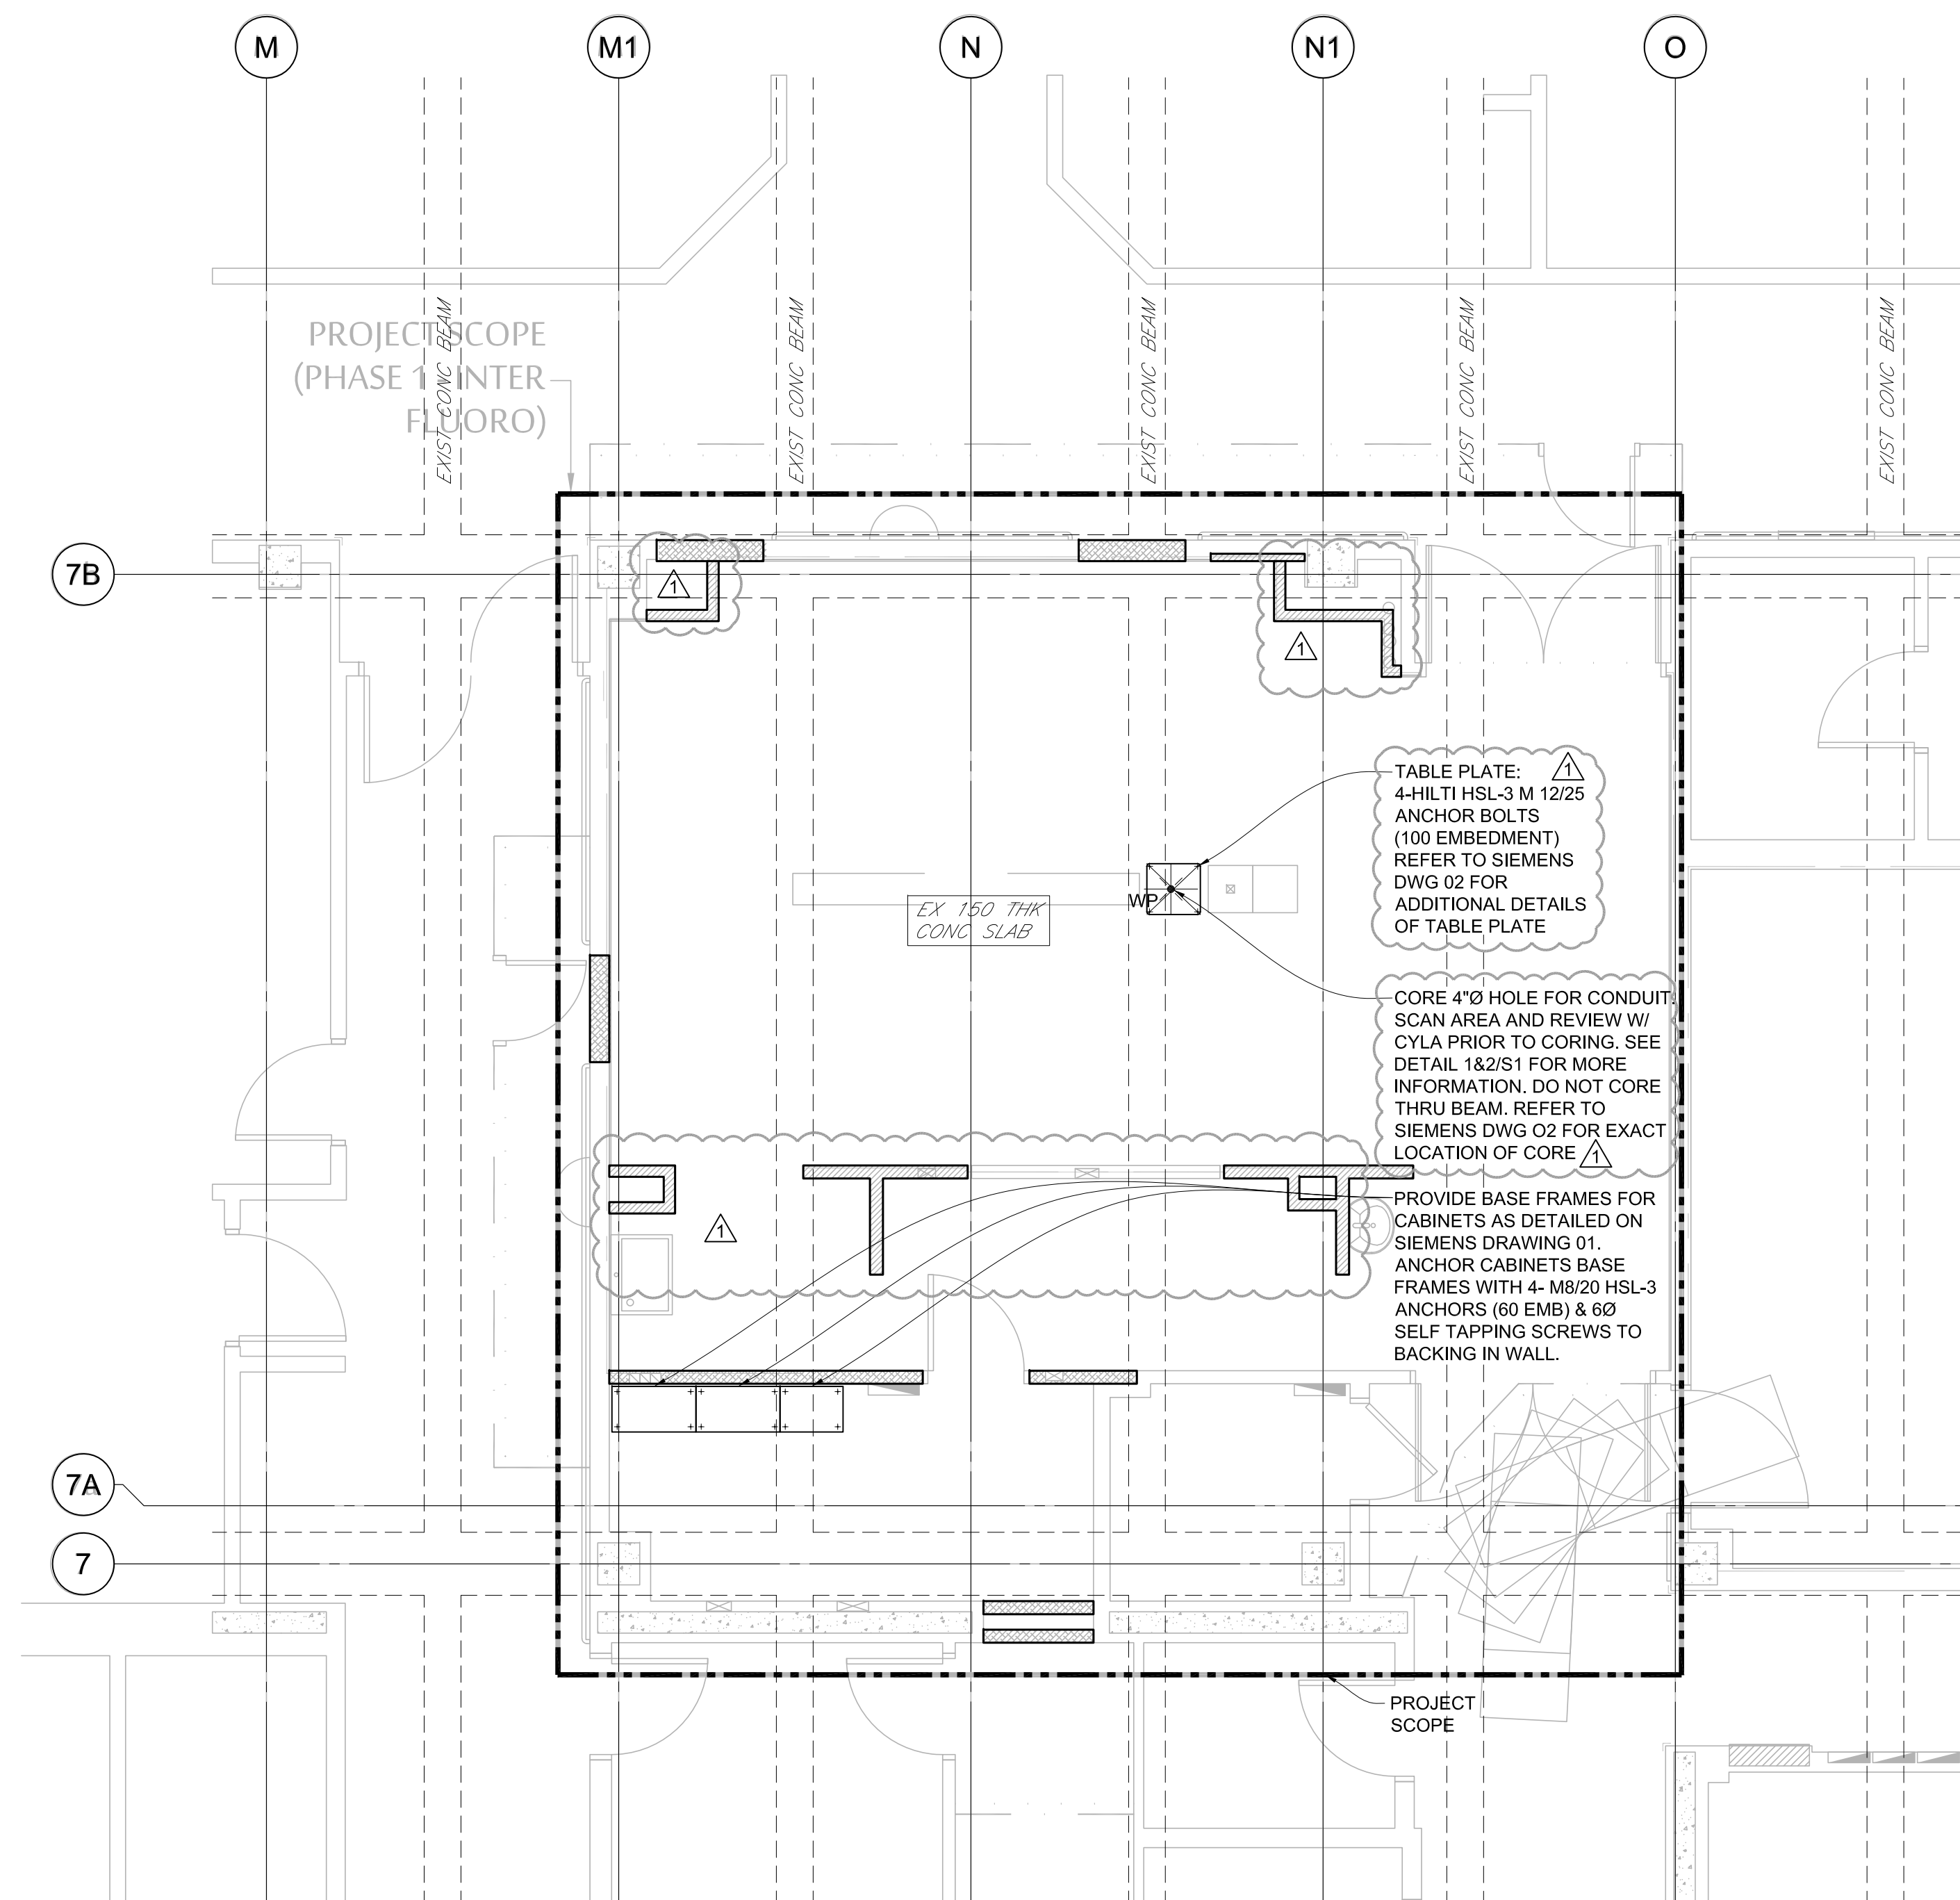

XR UNIT SUPPORT FRAME:
IF MECHANICAL EQUIPMENT
CONFLICTS WITH LAYOUT
CONTACT CYLA FOR
ALTERNATE FRAMING

ON STRUCTURAL DRAWINGS, *EXISTING ELEMENTS ARE TYPICALLY ANNOTATED WITH ITALIC TEXT*.
ALL WORK IN NON-ITALICIZED TEXT IS NEW EXCEPT WHERE NOTED.

01	ISSUED FOR TENDER ADDENDUM 1	2020.02.22
	ISSUED FOR TENDER	2020.02.10
	ISSUED FOR REVIEW	2020.01.13
	ISSUED FOR 80% CD	2020.12.16
	ISSUED FOR BUILDING PERMIT	2020.12.04
	ISSUED FOR DD REVIEW	2020.11.20
No.	REVISION	DATE

THIS DRAWING IS THE PROPERTY OF DCY
ARCHITECTURE. REPRODUCTION OF THIS
DRAWING IN WHOLE OR IN PART IS
PROHIBITED UNLESS WITH WRITTEN
PERMISSION.

UHNBC FLUOROSCOPY REPLACEMENT

1475 EDMONTON STREET, PRINCE GEORGE
BC V2M 1S2

PHASE 1 - INTER FLUOROC LEVEL 1 & RCP PLANS & SECTIONS


SCALE:
AS NOTED

DATE:
FEBRUARY 2021

DRAWN:
SAL


CHECKED:
KM

JOB No.:
11815

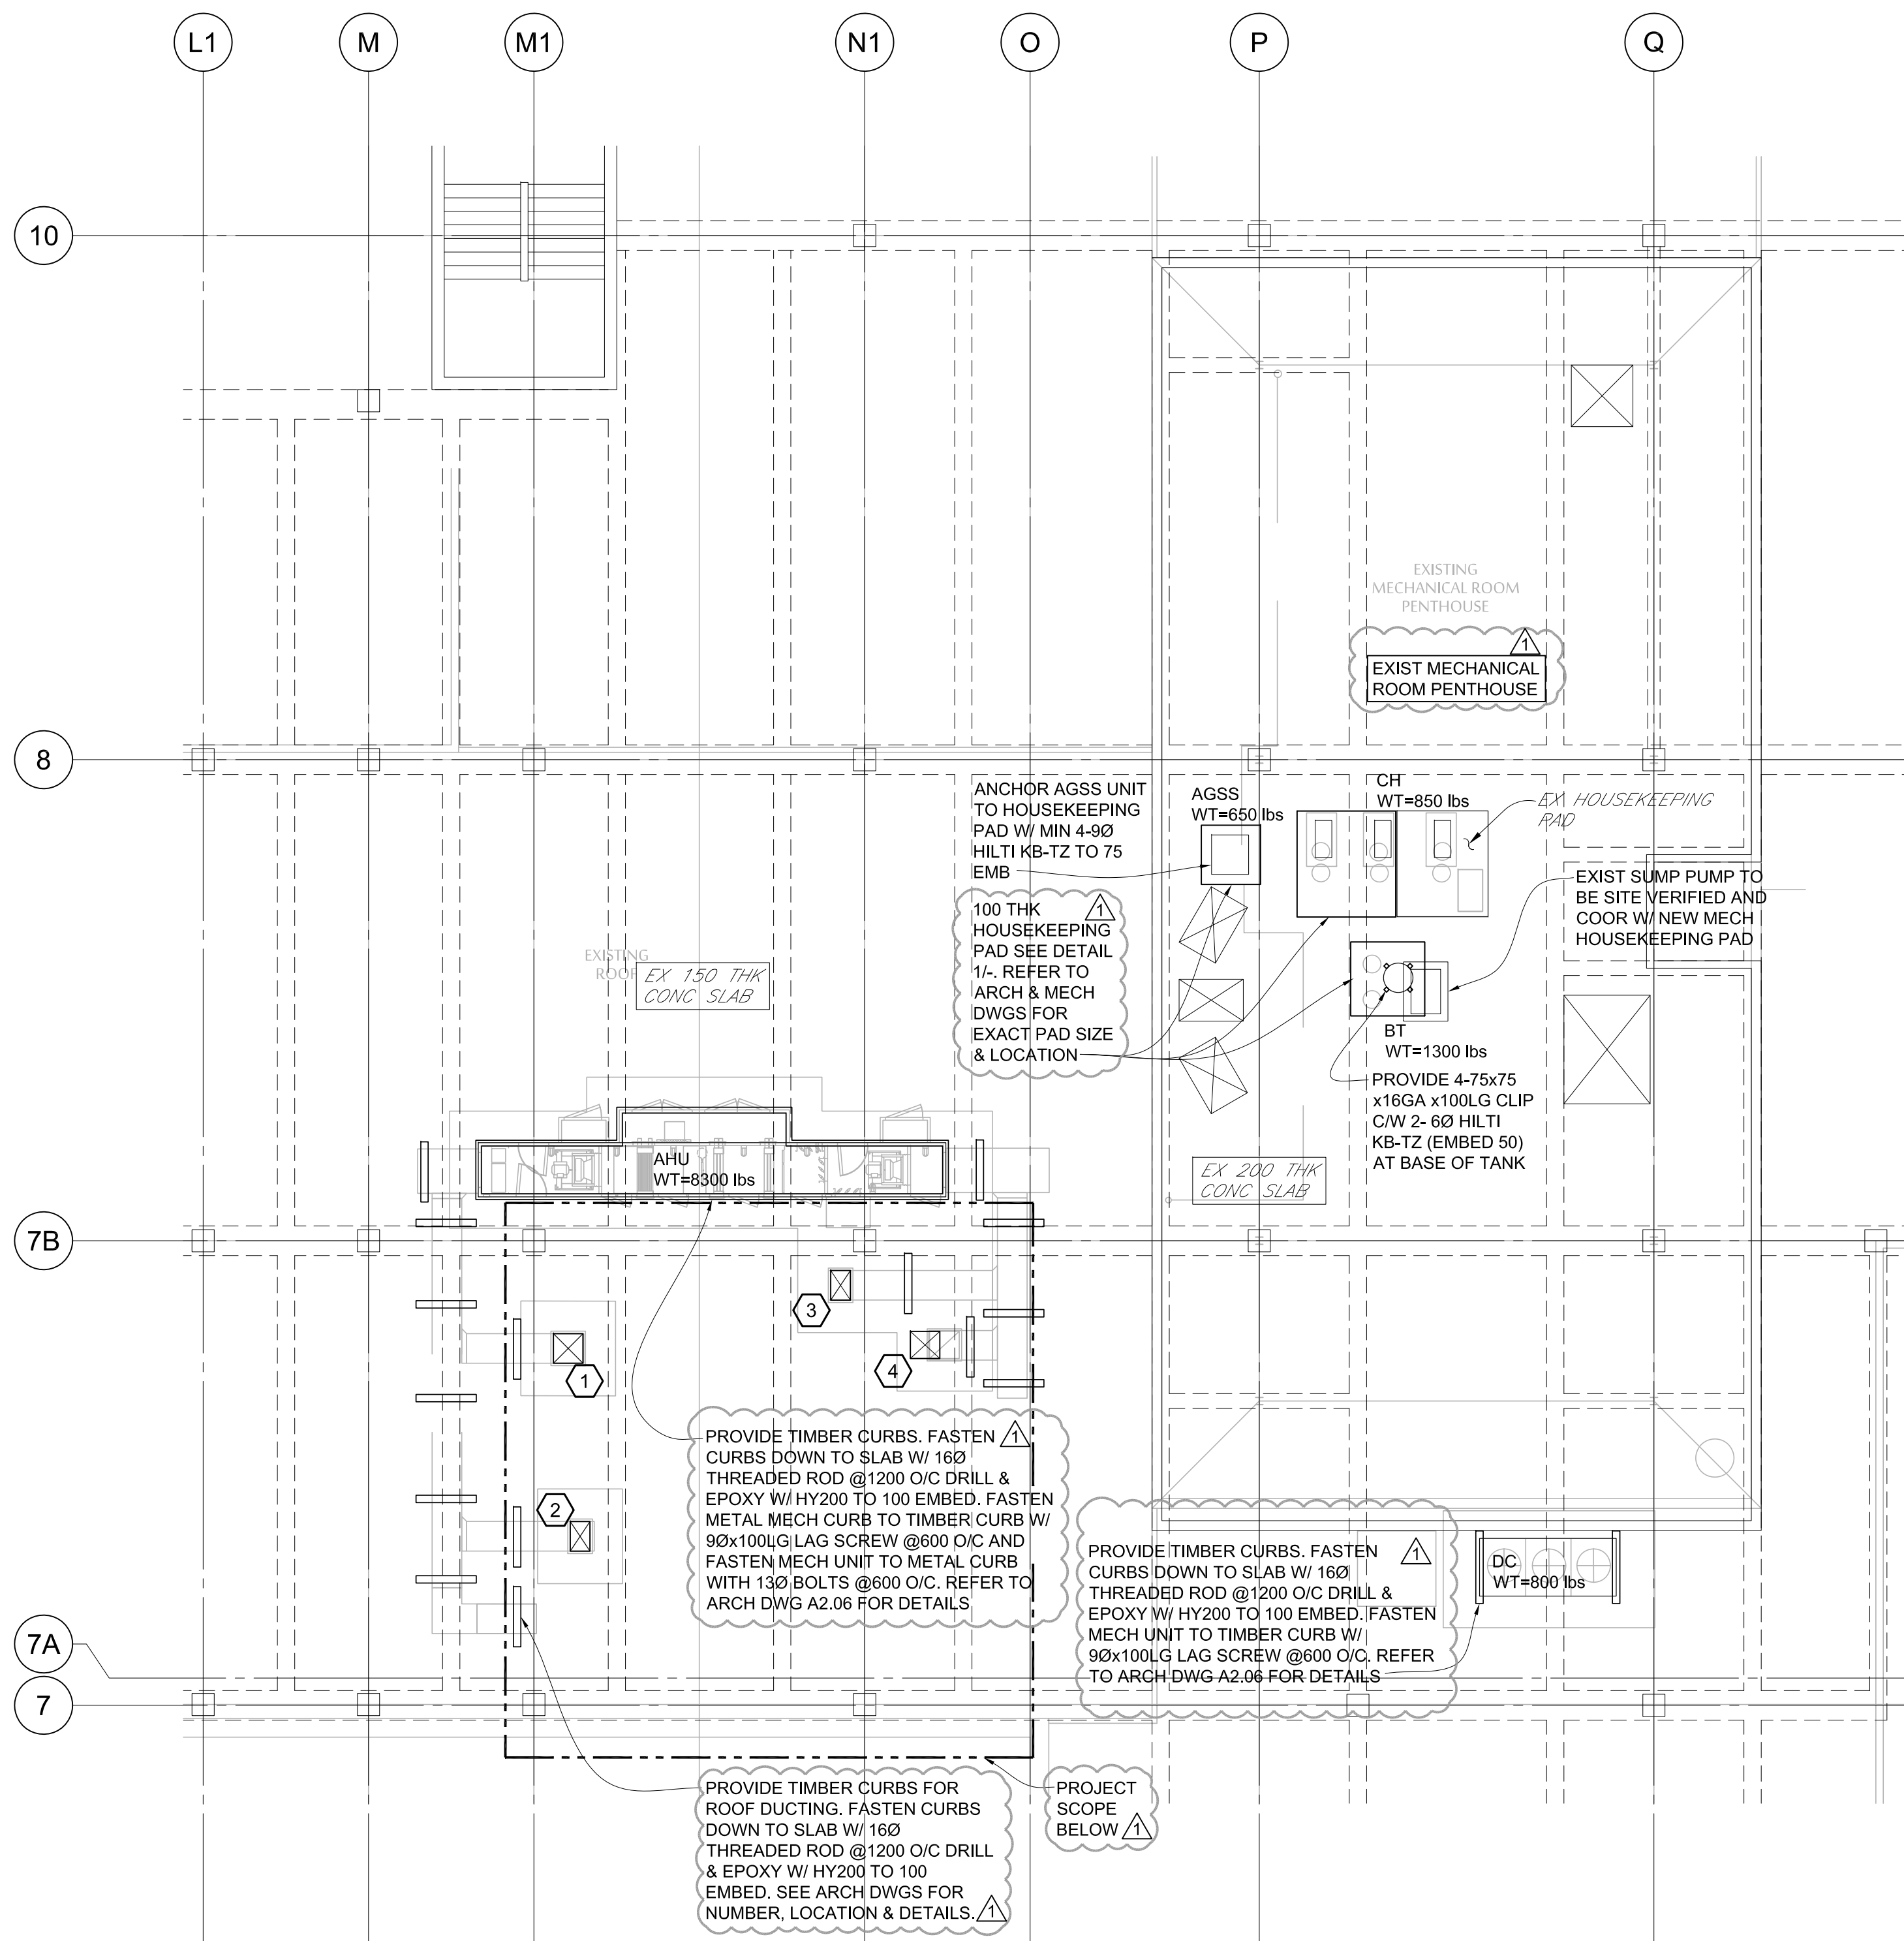


UHNBC - ROOF PART PLAN (D)
1:100


- SLAB OPENINGS:
REFER TO ARCH DWGS A2.06 FOR
EXACT LOCATION OF OPNGS
SCAN CONCRETE AT PROPOSED
OPENING AND PROVIDE PHOTOS
FOR REVIEW, SIZES:
- 1 700x650
 - 2 700x500
 - 3 700x500
 - 4 700x650
- ALL OPENING TO BE MIN
300 CLR FROM EX BEAM

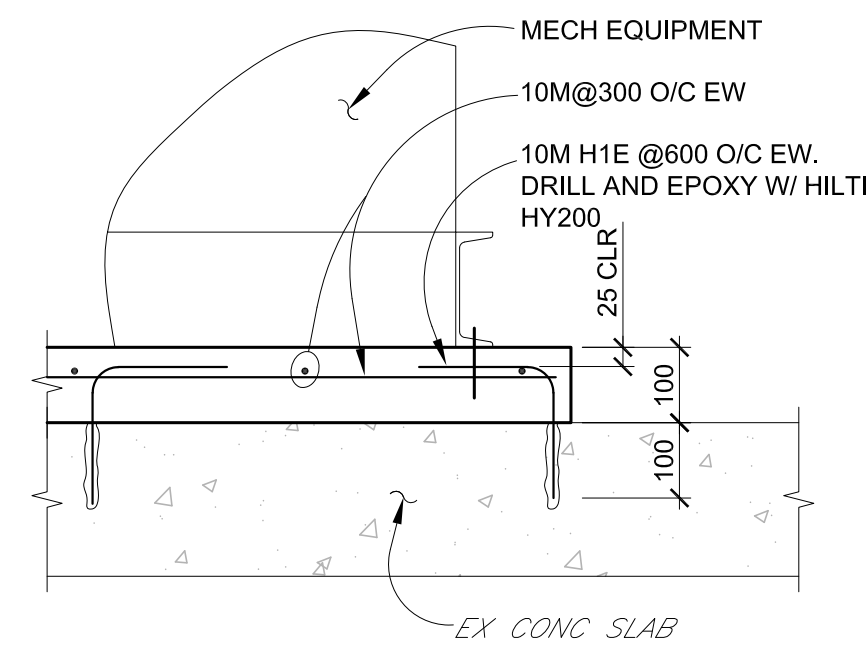


TYP HOUSEKEEPING PAD (1)
1:10

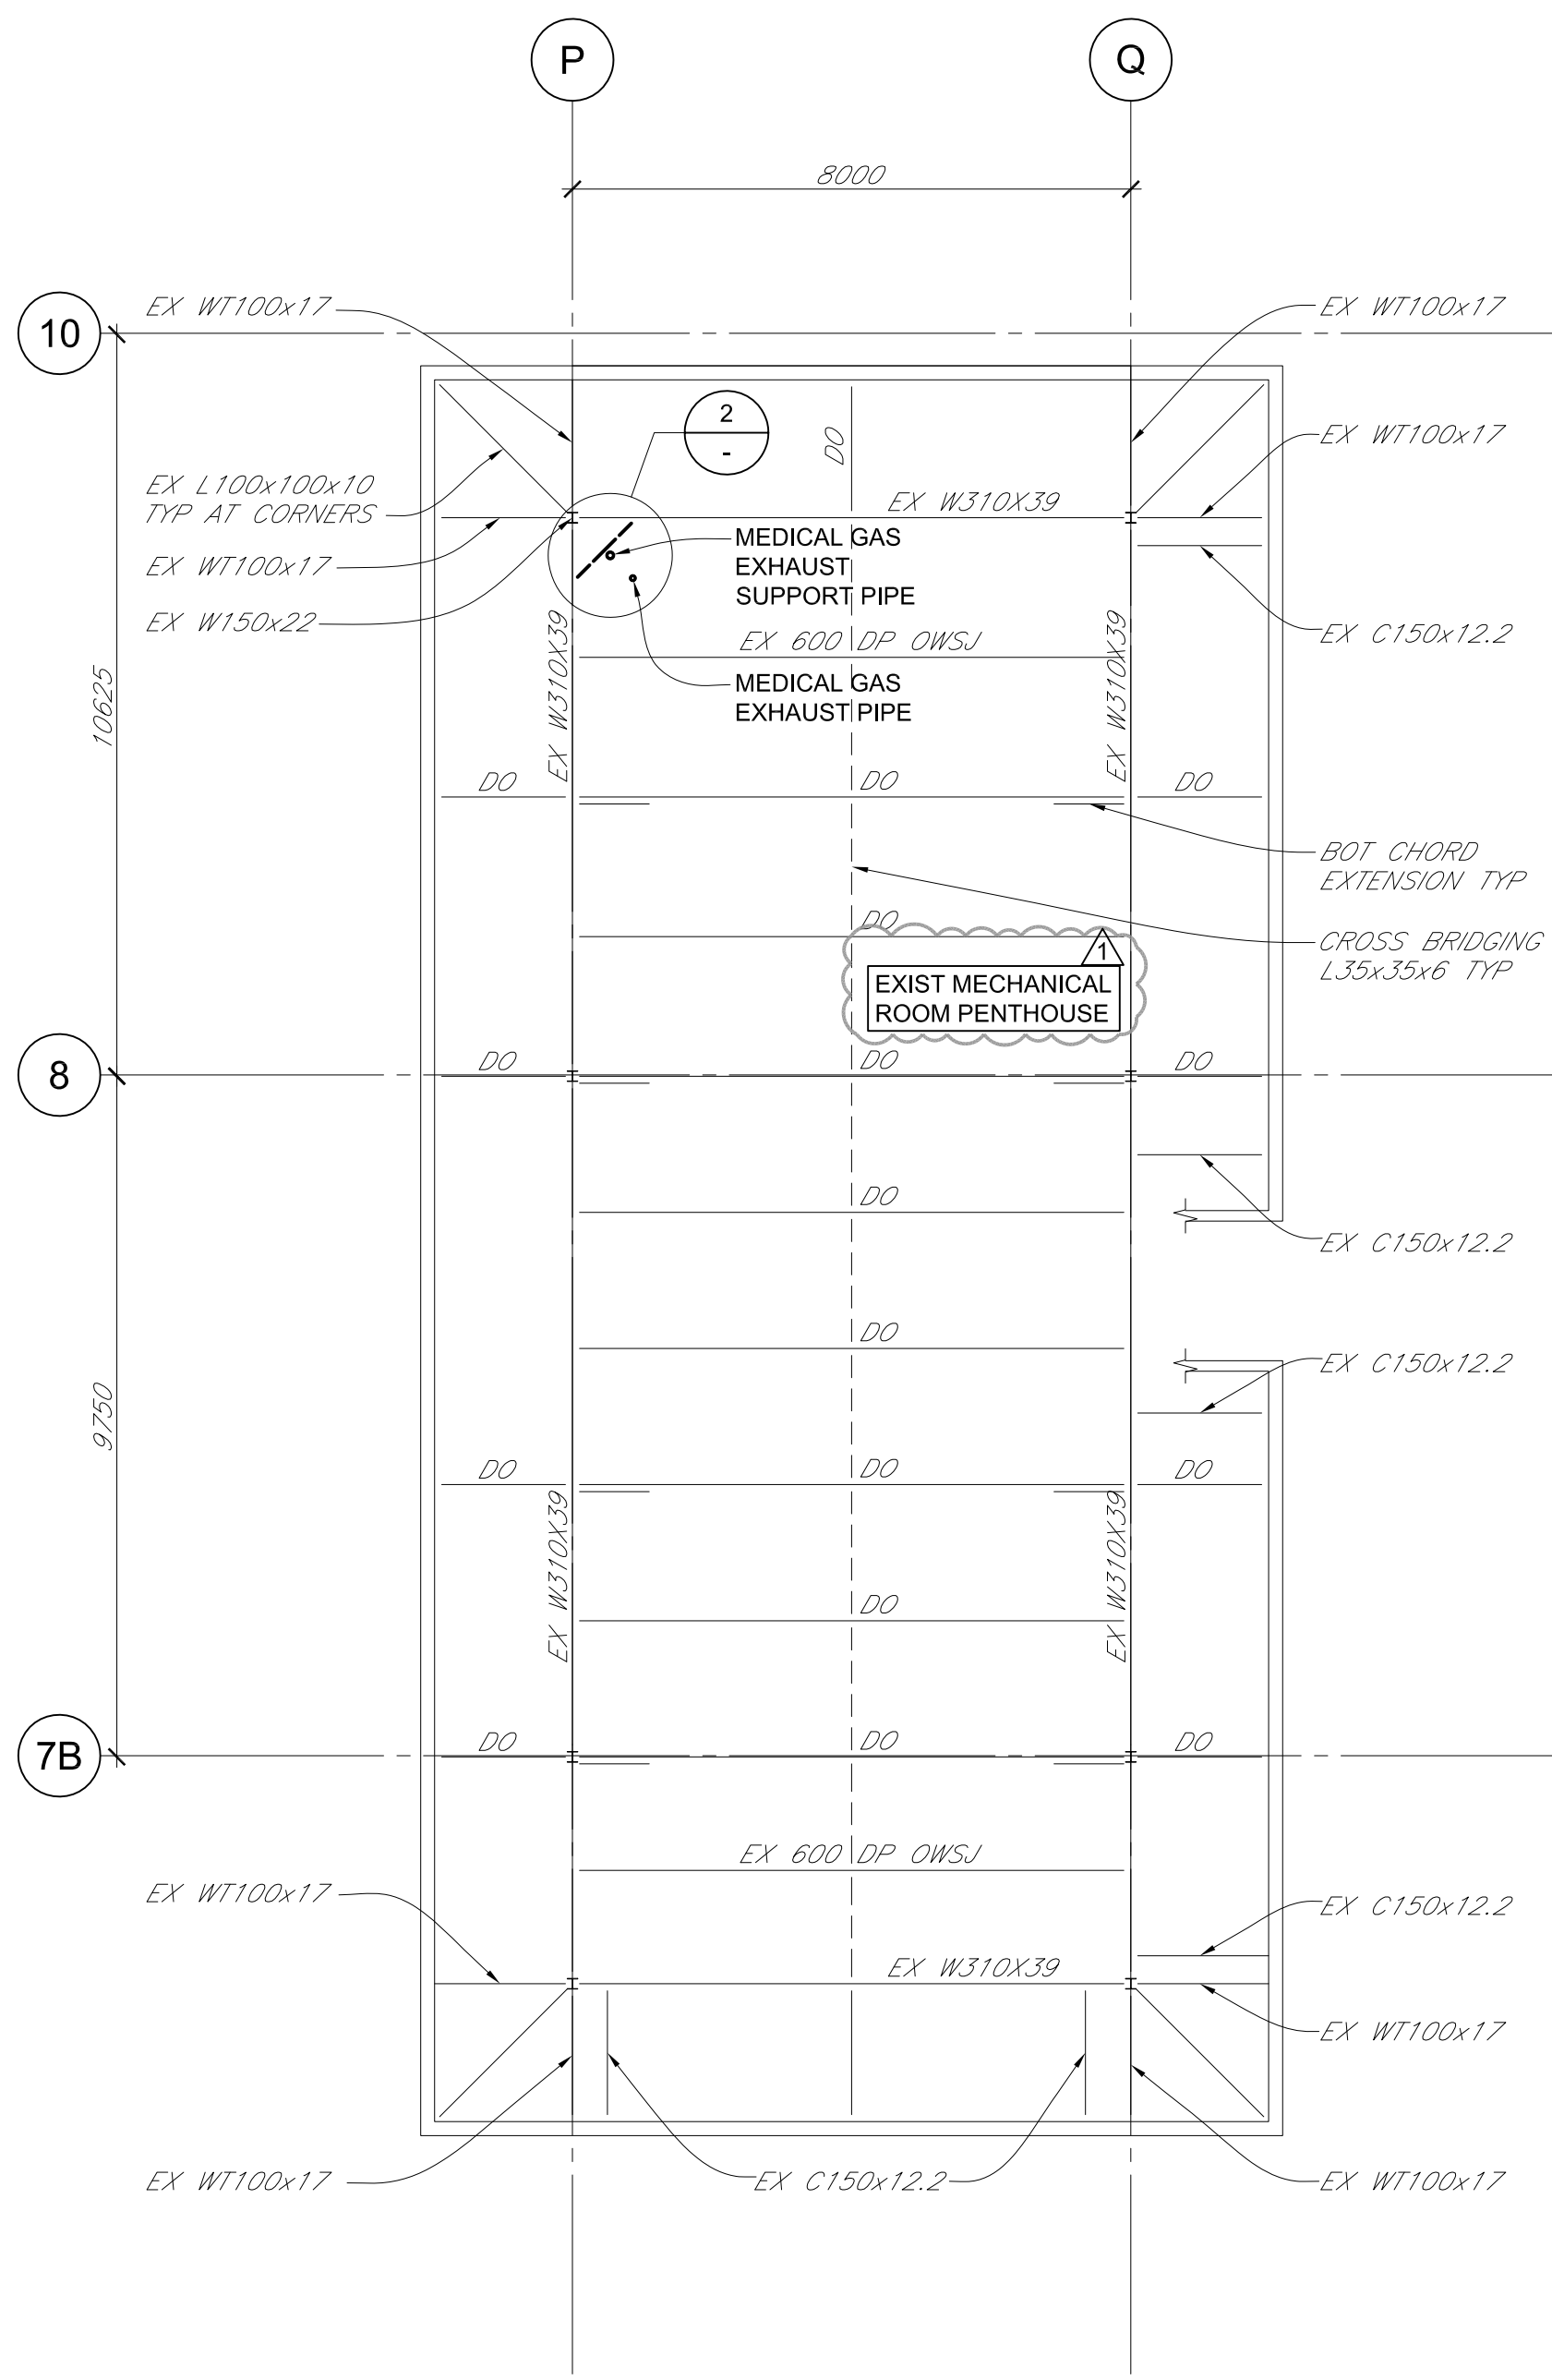

UHNBC - PENTHOUSE ROOF PLAN (E)
1:100

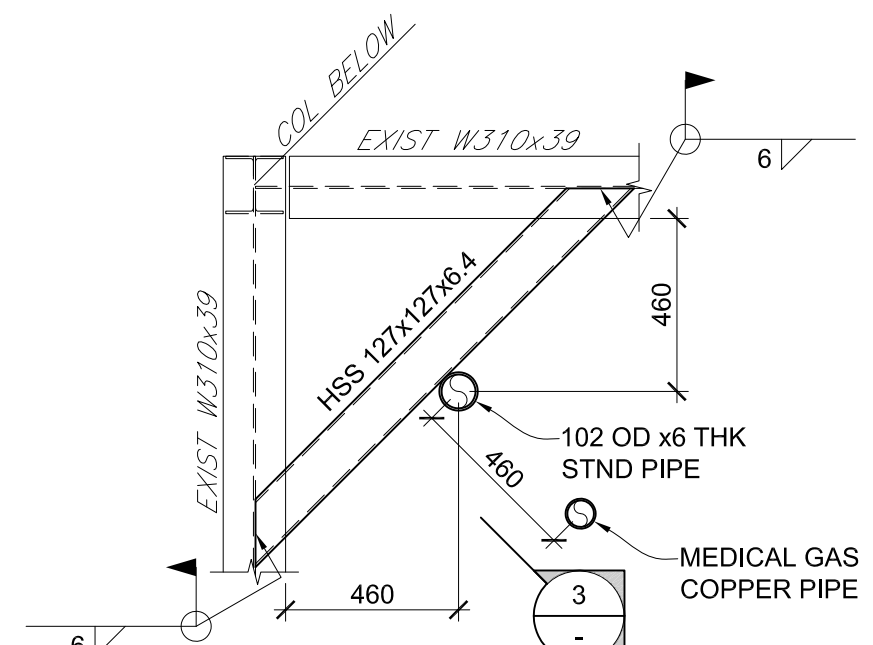

PLAN DETAIL (2)
1:20

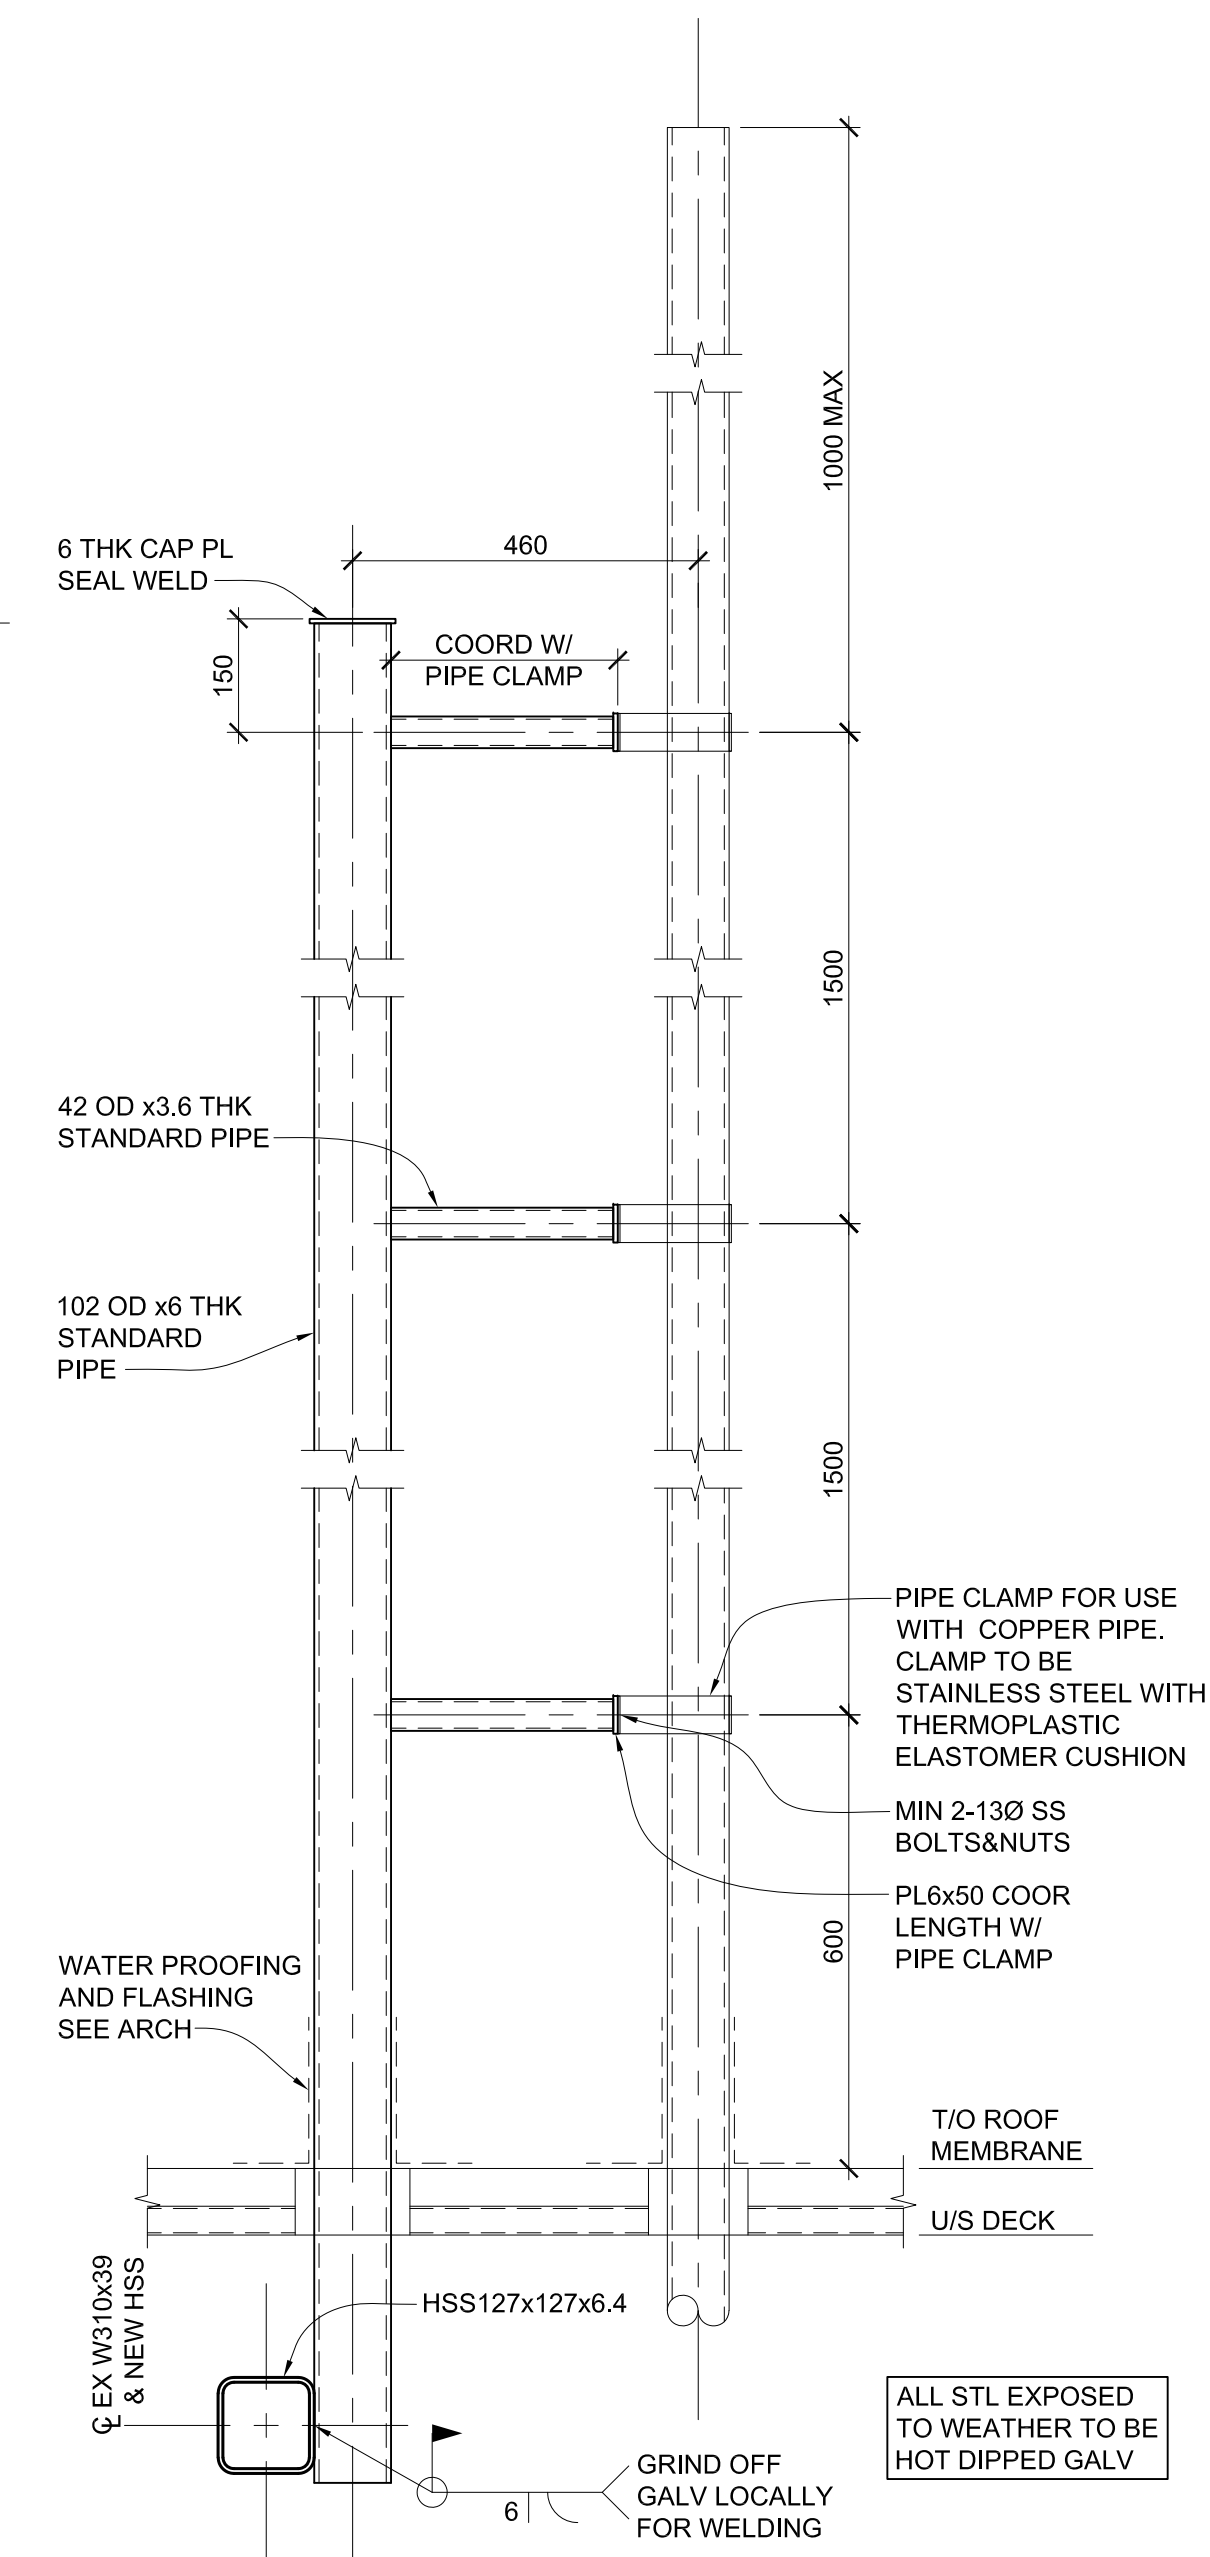

SECTION (3)
1:10

ON STRUCTURAL DRAWINGS, EXISTING ELEMENTS ARE TYPICALLY ANNOTATED WITH ITALIC TEXT
ALL WORK IN NON-ITALICIZED TEXT IS NEW EXCEPT WHERE NOTED.

ARCHITECT :



WWW.DCYTARCHITECTURE.CA

C.Y. LOH ASSOCIATES LTD
Consulting Structural Engineers

1863 Powell Street
Vancouver, B.C. V5L 1H8
T: 604.254.0868
E: cyla@cyla.ca

Copyright reserved. This design and drawing is the exclusive property of C.Y. Loh Associates Ltd. and cannot be used for any purpose without the written consent of C.Y. Loh Associates Ltd.
Prior to commencement of the Work, the Contractor shall verify all dimensions, datums and levels to identify any errors and omissions, ascertain any discrepancies between this drawing and the full Contract Documents, and bring these items to the attention of the C.Y. Loh Associates Ltd. for clarification.

DT	ISSUED FOR TENDER ADDENDUM 1	2020.02.22	SAL
DT	ISSUED FOR TENDER	2020.02.10	SAL
No.	REVISION	DATE	BY

THIS DRAWING IS THE PROPERTY OF DCYT ARCHITECTURE. REPRODUCTION OF THIS DRAWING IN WHOLE OR IN PART IS PROHIBITED UNLESS WITH WRITTEN PERMISSION.



UHNBC
FLUOROSCOPY
REPLACEMENT

1475 EDMONTON STREET, PRINCE GEORGE
BC V2M 1S2

PHASE 1 - INTER FLUORO
ROOF & PENTHOUSE
PLANS & SECTIONS

SCALE:
AS NOTED
DATE:
FEBRUARY 2021
DRAWN:
SAL
CHECKED:
KM
JOB No.:
11815

PHASE 1
S11

Client: Northern Health

Project Number: 20_002

Project Name: UHN Fluoroscopy

Attention: Douglas Cheung

Date: February 22, 2021

Addendum No: 1

Number of Pages: 1

General

1. Clarification:
 - a. All penetrations to be scanned and reviewed by structural consultant before coring.
 - b. Refer to architectural drawings for project area. Any work outside of the project area is to be performed after hours.
 - c. Refer to architectural/structural for exact location of duct penetrations housekeeping pads and roof curbs.
 - i. Refer to architectural and structural drawings for curb and pad details.

Drawings

2. ADD: Drawing M4.100 Schematics
 - a. New equipment and piping connections shown on schematic
 - b. Phasing notes included to maintain operation of existing cooling system
3. ADD: Drawing M5.100 Schedules:
 - a. AHU Schedule and Cutsheet.
 - i. Refer to the attached document.
 - b. Anesthetic Gas Scavenging System.
 - i. Refer to the attached document.
 - c. Glycol and Expansion Tank.
 - i. Refer to the attached document.
4. NOTE: Drawing M5.200 Specifications
 - a. Controls
 - i. The base building controls contractor is Houle
 - Contact: Nick Hauff
 - Nick@houle.ca
 - ii. A cash allowance for the controls scope will be issued in the next addendum.

b. Medical Gas



- i. Medical Gas outlets to be Amico DISS outlets
- ii. Combination Area Alarm and Zone Valve Box:
 - Valve box: zone valve box assembly with quarter turn on/off ball valves. Ball valves to be 25mm diameter and 32mm diameter, full port style suitable for medical gas service. Provide c/w valve piping extensions, 0-100psi and 0-30"hg gauges, 6mm diameter NPTF gauge port, suitable for WOG service to 400 psig, vacuum service of -29"hg. Securely fasten within 18 gauge painted steel casing. Provide with adjustable mounting frame and cover. Cover to have removable window marked Caution -Medical Gas Shut-off Valves - Close Only In Emergency.
 - a. Amico Alarm Valve Combo: Alert Series or equivalent

End of Document

Attachments:

- M4.100
- AHU Equipment Schedule
- AGSS Equipment Cutsheet
- Glycol Equipment Schedule

Jason Le, P.Eng., CEM
Senior Mechanical Engineer
P: 604 992 5920
E: jle@impacteng.ca

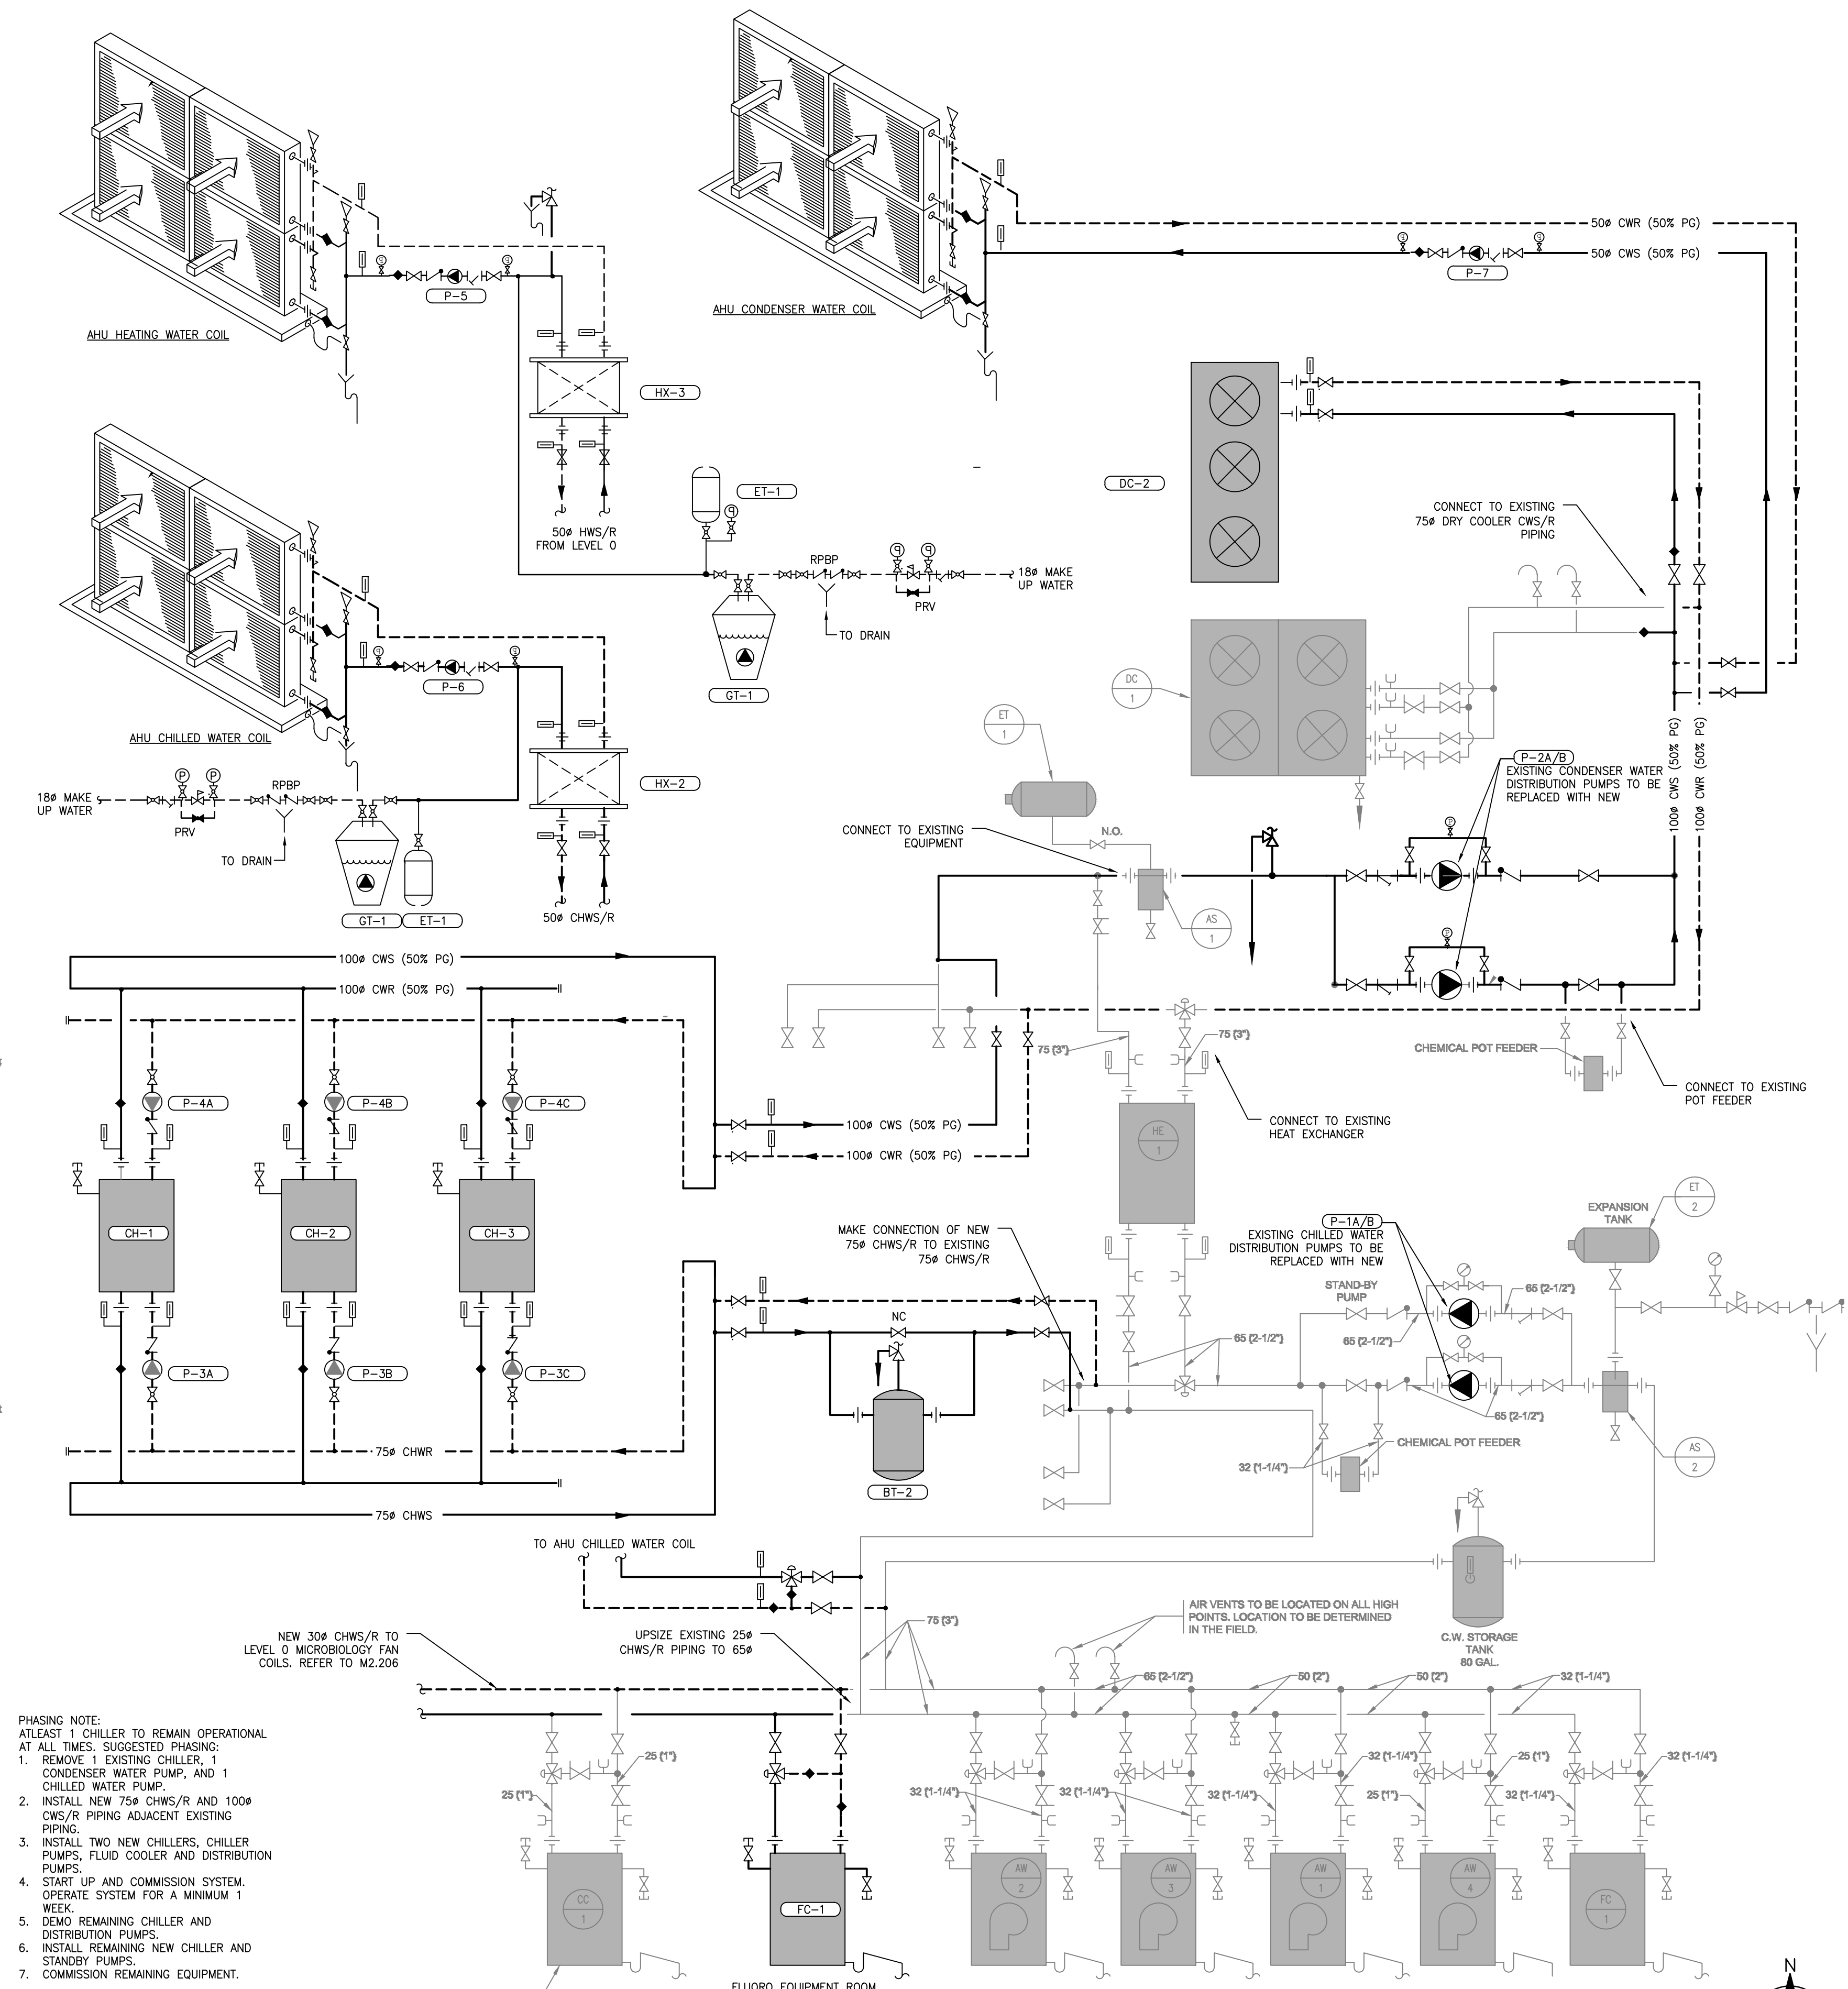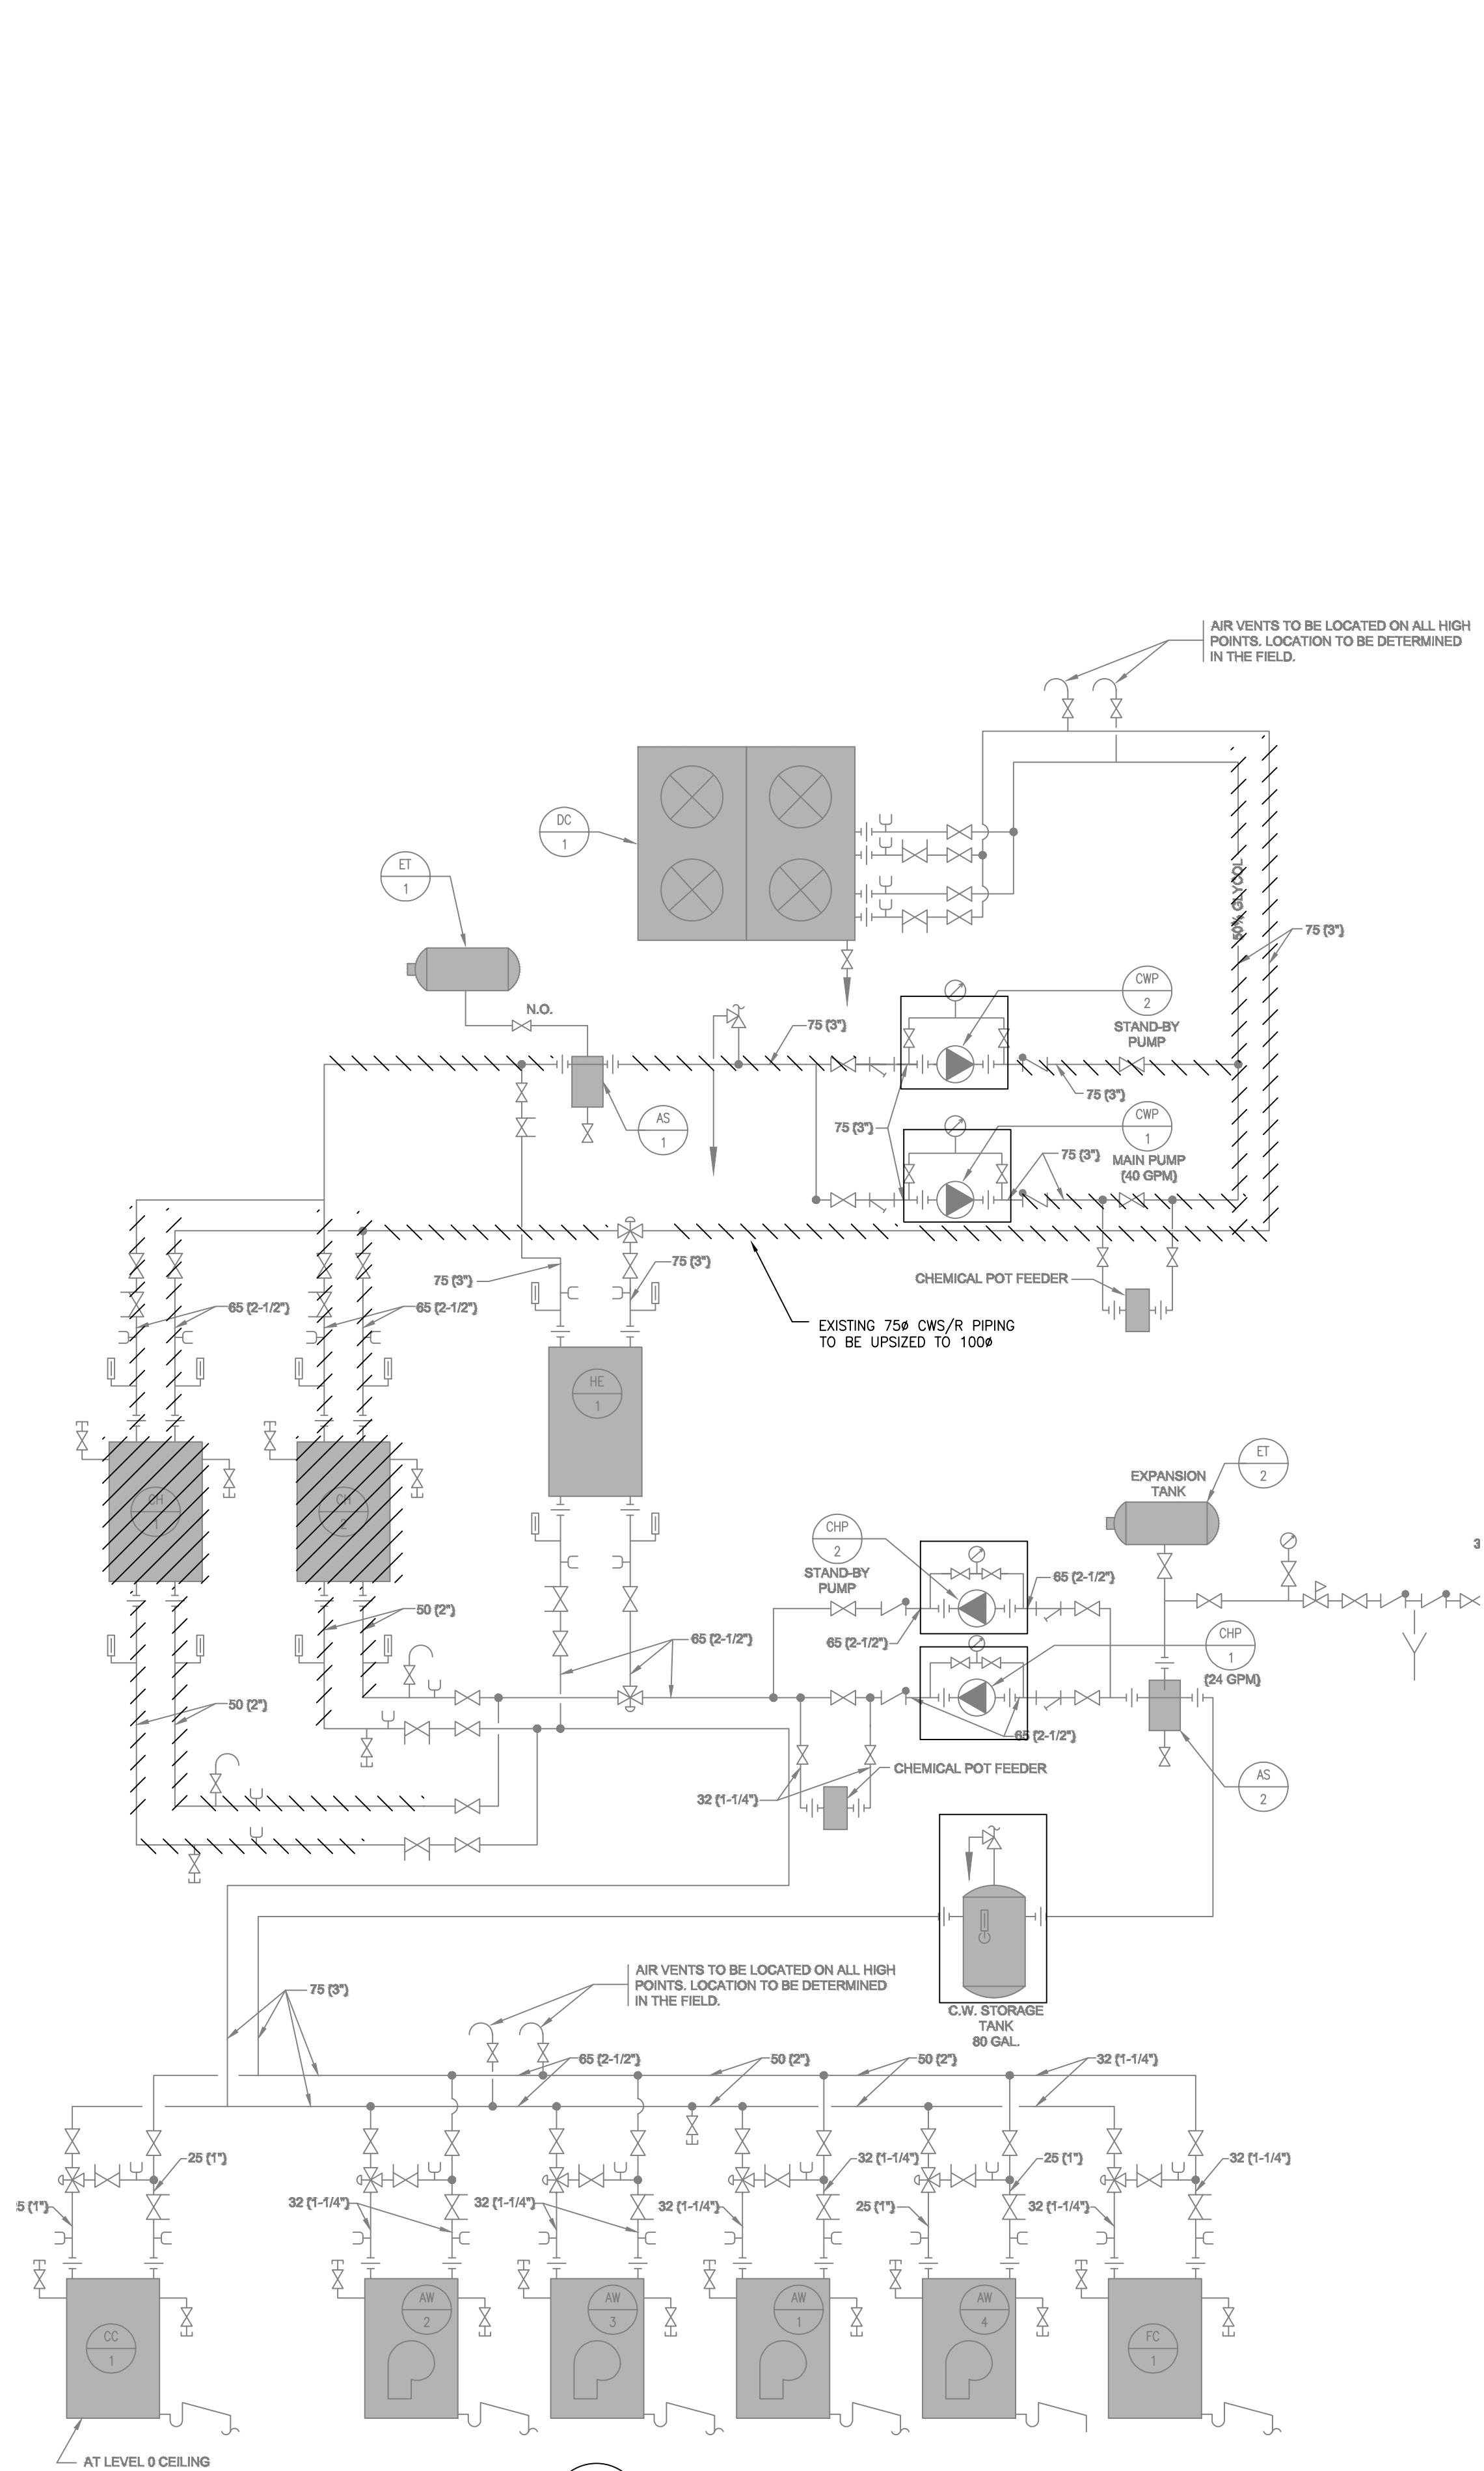

PHASING NOTE:
AT LEAST 1 CHILLER TO REMAIN OPERATIONAL
AT ALL TIMES. SUGGESTED PHASING:
1. REMOVE 1 EXISTING CHILLER, 1
CONDENSER WATER PUMP, AND 1
CHILLED WATER PUMP.
2. INSTALL NEW 75# CHWS/R AND 100#
CWS/R PIPING ADJACENT EXISTING
PIPING.
3. INSTALL TWO NEW CHILLERS, CHILLER
PUMPS, FLUID COOLER AND DISTRIBUTION
PUMPS.
4. START UP AND COMMISSION SYSTEM.
OPERATE SYSTEM FOR A MINIMUM 1
WEEK.
5. DEMO REMAINING CHILLER AND
DISTRIBUTION PUMPS.
6. INSTALL REMAINING NEW CHILLER AND
STAND-BY PUMPS.
7. COMMISSION REMAINING EQUIPMENT.

ARCHITECT :



WWW.DCYTARCHITECTURE.CA

MECHANICAL CONSULTANT :



312 Main Street
Vancouver, BC, V6A 2T2
www.impacteng.ca
(604) 200-9087

5	ISSUED FOR ADDENDUM #1	2021.02.22 JL
4	ISSUED FOR TENDER	2021.02.10 JL
3	ISSUED FOR 80% CD	2020.12.15 JL
2	ISSUED FOR BUILDING PERMIT	2020.12.04 JL
1	ISSUED FOR DD	2020.11.19 KM
No.	REVISION	DATE BY

THIS DRAWING IS THE PROPERTY OF
DCYT ARCHITECTURE. REPRODUCTION
OF THIS DRAWING IN WHOLE OR IN
PART IS PROHIBITED UNLESS WITH
WRITTEN PERMISSION.




UHNBC FLUOROSCOPY REPLACEMENT

1475 EDMONTON STREET, PRINCE GEORGE
BC V2M 1S2

SCHEMATICS

SCALE:
DATE:
FEB 22 2021
DRAWN:
KM
CHECKED:
JL
JOB No.:
20_002

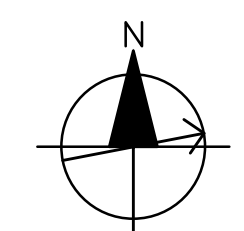

**MECHANICAL
EQUIPMENT SCHEDULES --
CUSTOM AHU**

SYSTEM DATA

TAG		AHU-1		
SERVICE		Fluoroscopy Project		
MANUFACTURER		Haakon		
MODEL		Custom		
TYPE		Roof Top Unit		
AIRFLOW	(CFM)	4000.0		
DIMENSIONS	(LxWxH)	373x44x58"	REFER TO DRAWINGS FOR PIPING CABINET DIMENSIONS	
WEIGHT	(LBS)	8290.0		

FAN DATA


		SUPPLY	RETURN	
PHASE 1: AIRFLOW	(CFM)	2300	2300	
PHASE 1: TOTAL STATIC	(IN WC)	2	1.2	
PHASE 1: EXTERNAL STATIC	(IN WC)	1	1	
PHASE 2: AIRFLOW	(CFM)	3000	3000	
PHASE 2: TOTAL STATIC	(IN WC)	2.7	1.3	
PHASE 2: EXTERNAL STATIC	(IN WC)	1	1	
PHASE 3: AIRFLOW	(CFM)	3500	3500	
PHASE 3: TOTAL STATIC	(IN WC)	3.3	1.4	
PHASE 3: EXTERNAL STATIC	(IN WC)	1	1	
PHASE 4: AIRFLOW	(CFM)	4000	4000	
PHASE 4: TOTAL STATIC	(IN WC)	4	1.5	
PHASE 4: EXTERNAL STATIC	(IN WC)	1	1	
MOTOR	(HP)	5	3	
RPM	(RPM)	1750	1750	
ELECTRICAL	(V)	575/3/60	575/3/60	

COILS

		COOLING	HEATING (HIGH TEMP)	HEATING (PREHEAT)
COOLING TOTAL	(MBH)	117.52	-	-
COOLING SENSIBLE	(MBH)	96.56	-	-
HEATING	(MBH)	-	220	110
APD	(IN WC)	1	0.13	0.17
EDB	(F)	80	30	30
EWB	(F)	67	-	-
LDB	(F)	57	80	55
LWB	(F)	57	-	-
FLUID		50% PG	50% PG	50% PG
FLUID FLOW RATE	(GPM)	34	24	12
EWI	(F)	45	180	100
LWI	(F)	53	160	80
WPD	(FT)	12.7	6.1	9
ROW		8	2	2
SIZE		39x30	39x30	39x30

NOTES

NOTE (1)	MERV 8 PREFILTER, MERV 14 FINAL FILTER (AFTER SUPPLY FAN)
NOTE (2)	REFER TO DRAWINGS FOR DIMENSIONS AND SIZE OF REQUIRED PIPING CABINETS
NOTE (3)	AHU SUPPLIED WITH BASE RAIL AND STEEL CURB
NOTE (4)	C/W VIBRATION ISOLATORS
NOTE (5)	C/W HUMIDIFIER AND ELECTRIC STEAM GENERATOR 30.76 LBS/HR STEAM BASIS OF DESIGN; DRISTEEM CRUV-12 HUMIDISTAT, AIR PROVING SWITCH, DRAIN COOLER, VAPOR LOGIC CONTROLS WITH BACNET.
NOTE (6)	CABINET HEATER. 0.5 KW BASEBOARD HEATER
NOTE (7)	FANS C/W VFDS.
NOTE (8)	REFER TO SPECIFICATIONS FOR ADDITIONAL DETAILS

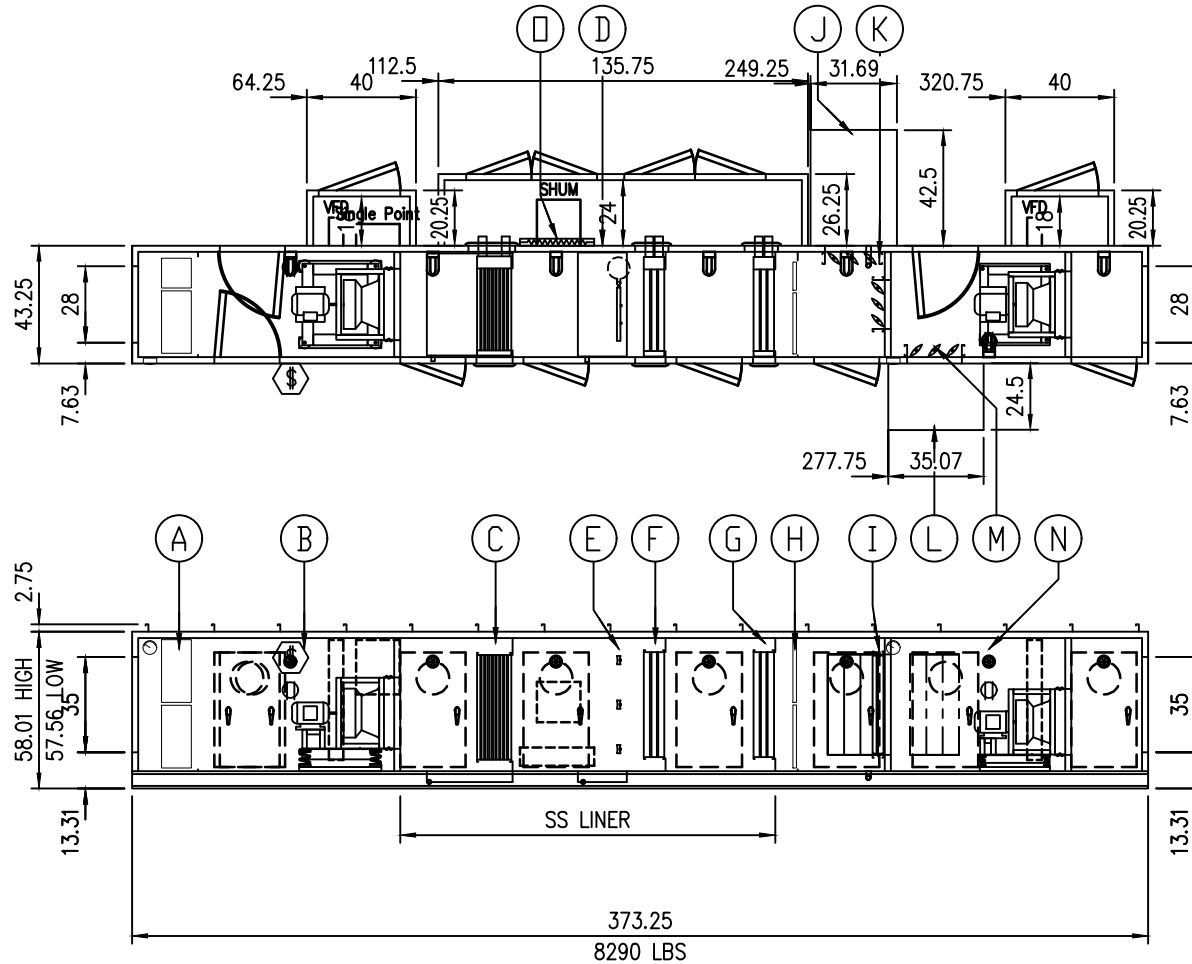

(N) Service : RF
Fan: 16" A EPFN SW, Arrangement-4

Class: 1 Max RPM: 2668

	PH-1	PH-2	PH-3	PH-3+500
A.F.(cfm):	2300	3000	3500	4000
T.S.P.(in wc):	1.2	1.3	1.4	1.5
E.S.P.(in wc):	1	1	1	1
RPM:	1425	1693	1897	2100

MOTOR : 3 HP, ODP Prem-Eff, 575/3/60
RPM : 1750 (GROUNDED SHAFT)
ISOLATORS : OS DEF : 1 in
FEG71 η_{pt} : 65% η_t / η_{pt} : 95%

(D) 0.5 kW Baseboard Heater
- c/w Thermostat

UNIT MOUNTING

The unit is designed to be mounted on a roof curb.

Note : Calculated unit weights are shipping weights and do not reflect operating conditions, items which are field installed or ship loose.

- (A) FILTERS : LIFT-OUT UPSTREAM
VELOCITY : 333 FPM
TYPE : 12" (MERV 14) Farr Riga-Flo 200 PH style
SIZES : 2 @ 24 X 24 2 @ 24 X 12
- (B) Service : SF
Fan: 18" EPFN SW, 60% Width, Arrangement-4
Class: 2 Max RPM: 2930
- | | PH-1 | PH-2 | PH-3 | PH-3+500 |
|----------------|------|------|------|----------|
| A.F.(cfm): | 2300 | 3000 | 3500 | 4000 |
| T.S.P.(in wc): | 2 | 2.7 | 3.3 | 4 |
| E.S.P.(in wc): | 1 | 1 | 1 | 1 |
| RPM: | 1585 | 1938 | 2198 | 2467 |
- MOTOR : 5 HP, ODP Prem-Eff, 575/3/60
RPM : 1750 (GROUNDED SHAFT)
ISOLATORS : OS DEF : 2 in
FEG80 η_{pt} : 73% η_t / η_{pt} : 93%
- (C) COOLING COIL
TYPE : 8 ROW
SIZES : 1 @ 39 X 30
CONN : LEFT PULL : RIGHT
DRAIN : RIGHT VEL : 492 FPM
- (D) DRAIN PAN
CONN : RIGHT
- (E) HUMIDIFIER
- (F) HIGH TEMP HEATING COIL
TYPE : 2 ROW
SIZES : 1 @ 39 X 30
CONN : LEFT PULL : RIGHT
VEL : 492 FPM
- (G) COND WATER HEATING COIL
TYPE : 2 ROW
SIZES : 1 @ 39 X 30
CONN : LEFT PULL : RIGHT
VEL : 492 FPM
- (H) FILTERS : LIFT-OUT UPSTREAM
VELOCITY : 333 FPM
TYPE : 2" (MERV 8) Farr 30/30
SIZES : 2 @ 24 X 24 2 @ 24 X 12
- (I) RA DAMPER : PARALLEL BLADES
MAKE : T.A. Morrison 1000
SIZE : 39 X 20
- (J) OA HOOD
- (K) OA DAMPER : PARALLEL BLADES
MAKE : T.A. Morrison 1000
SIZE : 39 X 20
- (L) EA HOOD
- (M) EA DAMPER : PARALLEL BLADES
MAKE : T.A. Morrison 1000
SIZE : 39 X 20

SDG VER: Jan 21 2021

PROJECT

UHN Fluoroscopy

OPENINGS AND DIMENSIONS MAY VARY FROM CONTRACT DOCUMENTS. RETURN OF APPROVED DRAWINGS CONSTITUTES ACCEPTANCE OF THESE VARIANCES.

HAAKON INDUSTRIES.
11851 DYKE ROAD, RICHMOND, B.C. CANADA V7A 4X8

JOB NO.	63059	DRAWN BY	DW	DWG NO.	63059U05SD01	ACCESS SIDE	RIGHT	DWG UNITS	IN
TAG	RTU-1	DATE	JAN 25/21	TYPE	OUTDOOR	14:04		SCALE	N.T.S.

SALES OFFICE	TRANE VANCOUVER
SALES ENGINEER	IVAN HOLDO


UHN Inter Fluoro
1475 Edmonton Street, Prince George

**MECHANICAL
EQUIPMENT SCHEDULES --
TANKS**

Page 1 of 1

EQUIPMENT DATA

UNIT NO.		GT-1	ET-1	
SERVICE		GLYCOL FILL TANK	EXPANSION TANK	
LOCATION		PENTHOUSE ROOM	PENTHOUSE ROOM	
MANUFACTURER		AXIOM	ARMSTRONG	
MODEL (CUSTOM)		SF100	AMTROL	
VOLUME (GAL)		55	AX-15 (V)	
DIAMETER (mm)		600	300	
(Inches)		24	12	
HEIGHT (mm)		1225		
(Inches)		49		

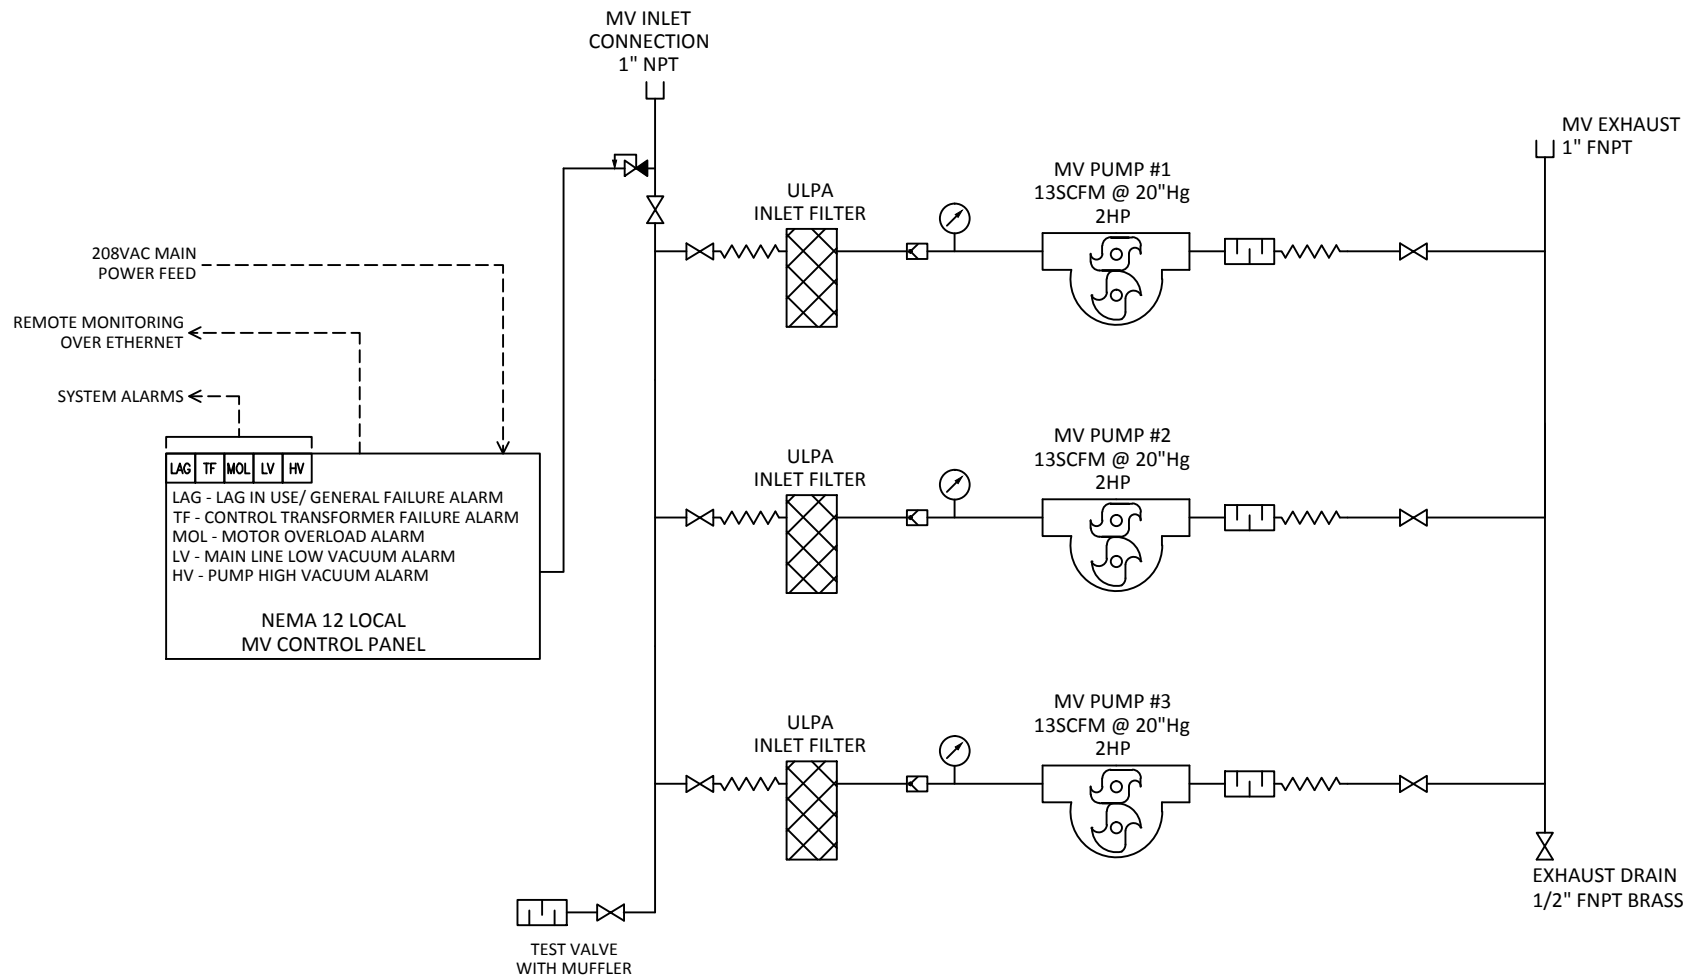

NOTES:



1. ALL INTAKE HEADER PIPING COPPER OR BRASS PIPE AND FITTINGS

LEGEND

- BALL VALVE
- DIAPHRAGM DEMAND CHECK VALVE
- SS BRAIDED FLEX HOSE
- VACUUM GAUGE
- CHECK VALVE


REV.	DESCRIPTION	BY	DATE
B	CHANGE POWER FEED TO 208VAC	DT	21/03/13
A	ISSUED FOR APPROVAL	DT	20/03/13


CLASS 1 INC. Building Better Healthcare™		Class 1 Inc. 565 Boxwood Drive Cambridge, Ontario N3E 1A 5 T(800) 242-9723 F(800) 330-5537 (519) 650-2355 (519) 650-2366 www.class1inc.com		DRAWN BY:	DT	DATE:	20/03/13
		CUSTOMER:		CHECKED BY:		DATE:	
TITLE:		Almonte General Hospital		APPROVED BY:		DATE:	
SUB-TITLE:		OLC200-SX3, 2hp Triplex Oilless Claw Medical Vacuum System		SCALE:	NA	DWG. NO.:	MVS-A-249-PI
		DWG. SUB.	3	REV.	B	SHT. SIZE	A
				SHT. NUM.	1 of 1		

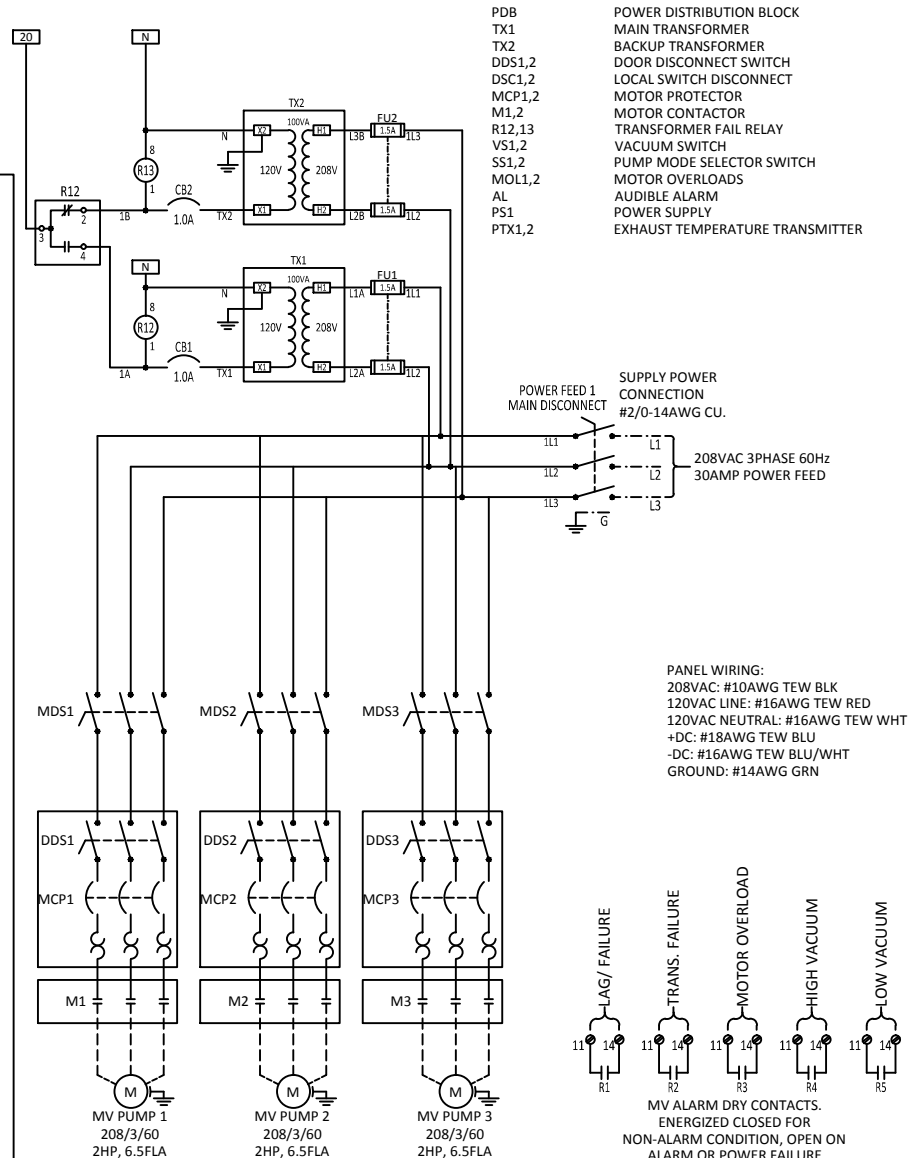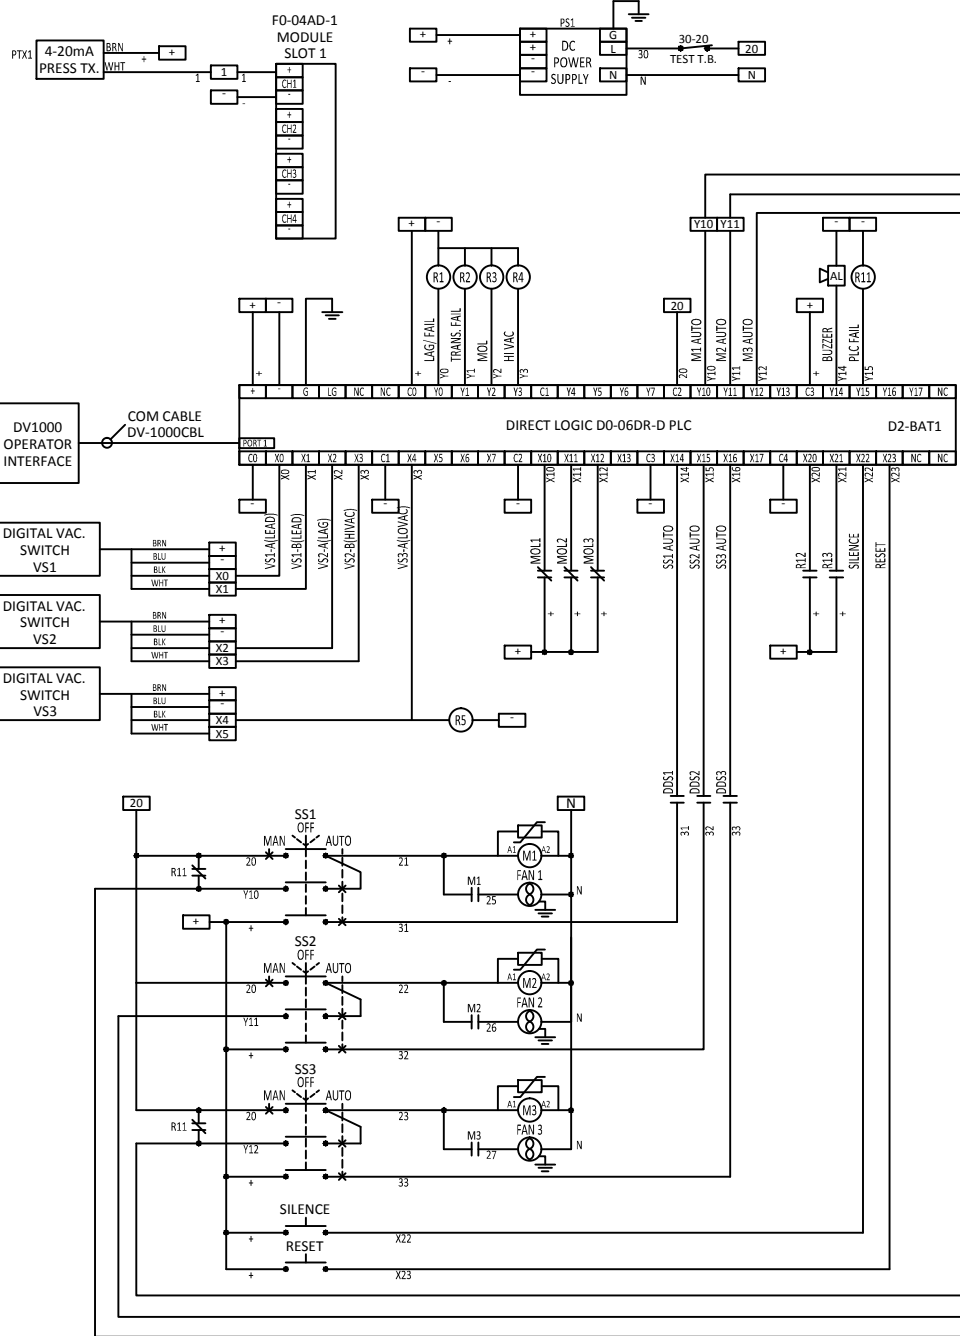

CLASS 1 INC. Building Better Healthcare™		Class 1 Inc. 565 Boxwood Drive Cambridge, Ontario N3E 1A 5 T(800) 242-9723 F(800) 330-5537 (519) 650-2355 (519) 650-2366 www.class1inc.com		DRAWN BY: DT		DATE: 19/03/13	
CUSTOMER: Almonte General Hospital				CHECKED BY:		DATE:	
TITLE: OLC200-SX3, 2hp Triplex Oilless Claw Medical Vacuum System				APPROVED BY:		DATE:	
SUB-TITLE: WIRING DIAGRAM		SCALE: NA	DWG. NO. MVS-A-249-WD	DWG. SUB. 3	REV. B	SHT. SIZE A	SHT. NUM. 1 of 1

REV.	DESCRIPTION	BY	DATE
B	CHANGE POWER FEED TO 208VAC	DT	21/03/13
A	ISSUED FOR APPROVAL	DT	19/03/13

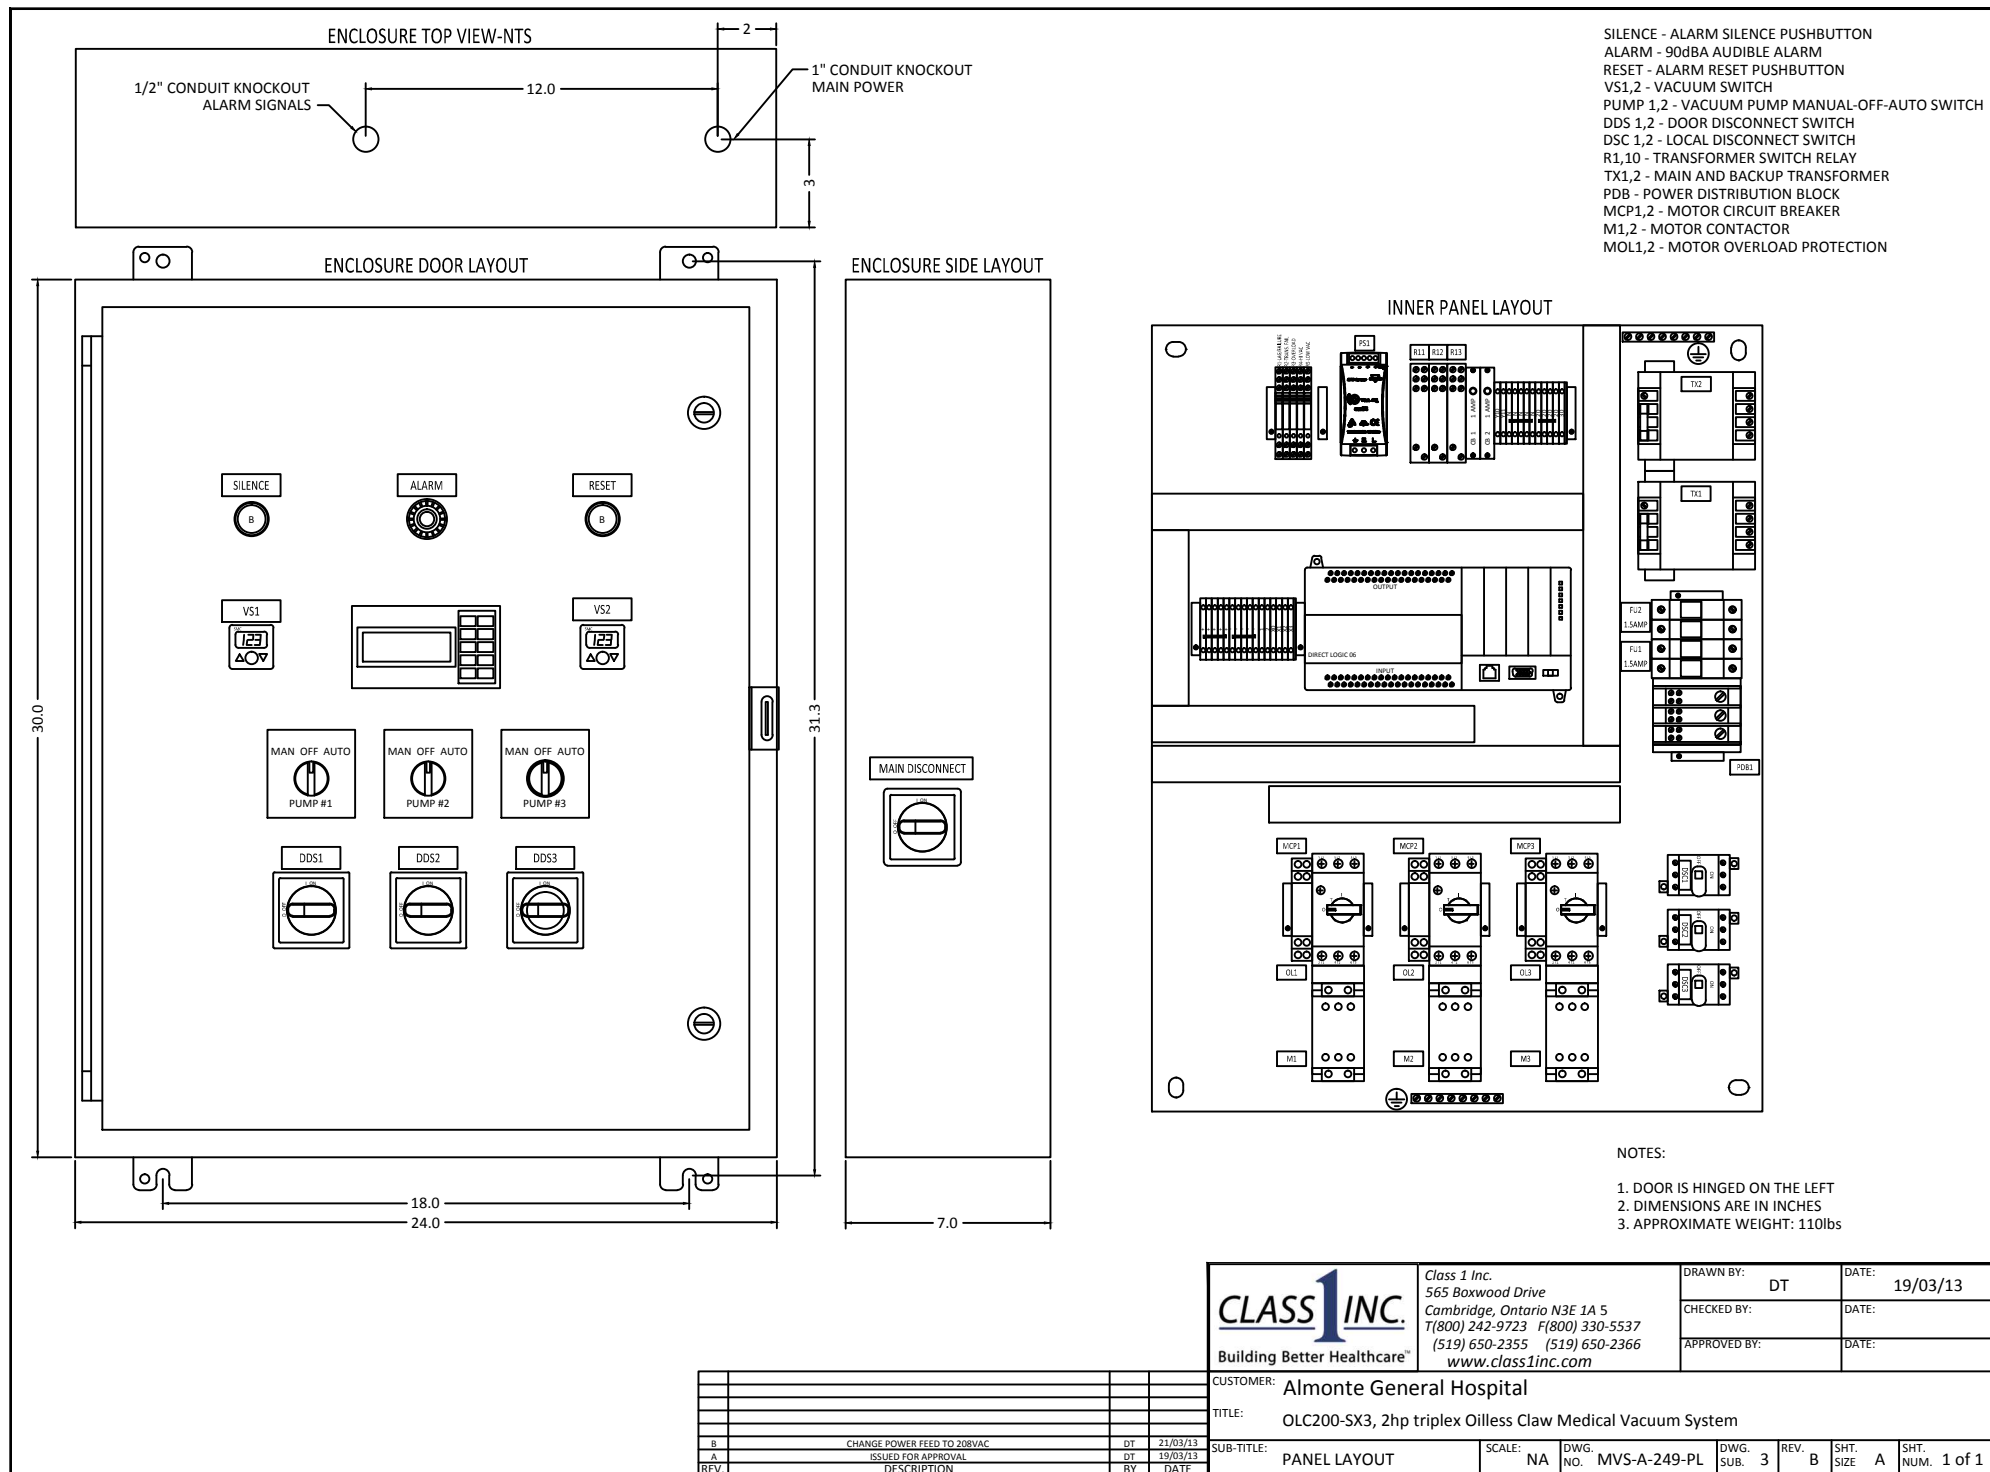

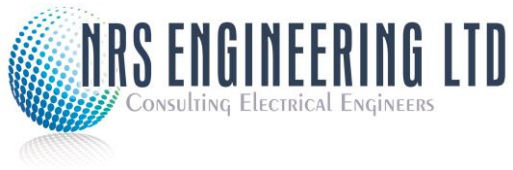

ELECTRICAL Addendum No. ONE

PROJECT: UHNBC Interventional Fluoroscopy – Phase 1


PROJECT No: 2474

PRIME CONSULTANT: DCYT Architecture

DATE: February 22, 2021

This addendum information is to be included as part of the tender documents, and the cost of this work shall be included in the tender amount. Indicate receipt of this addendum on the Tender Form.

1. Drawing #E2.01 (Refer to drawing, reissued with Addendum)
 - a. Several devices have notes added to clarify mounting heights and locations.
 - b. All device locations to be coordinated with Architectural drawings and Siemens equipment.

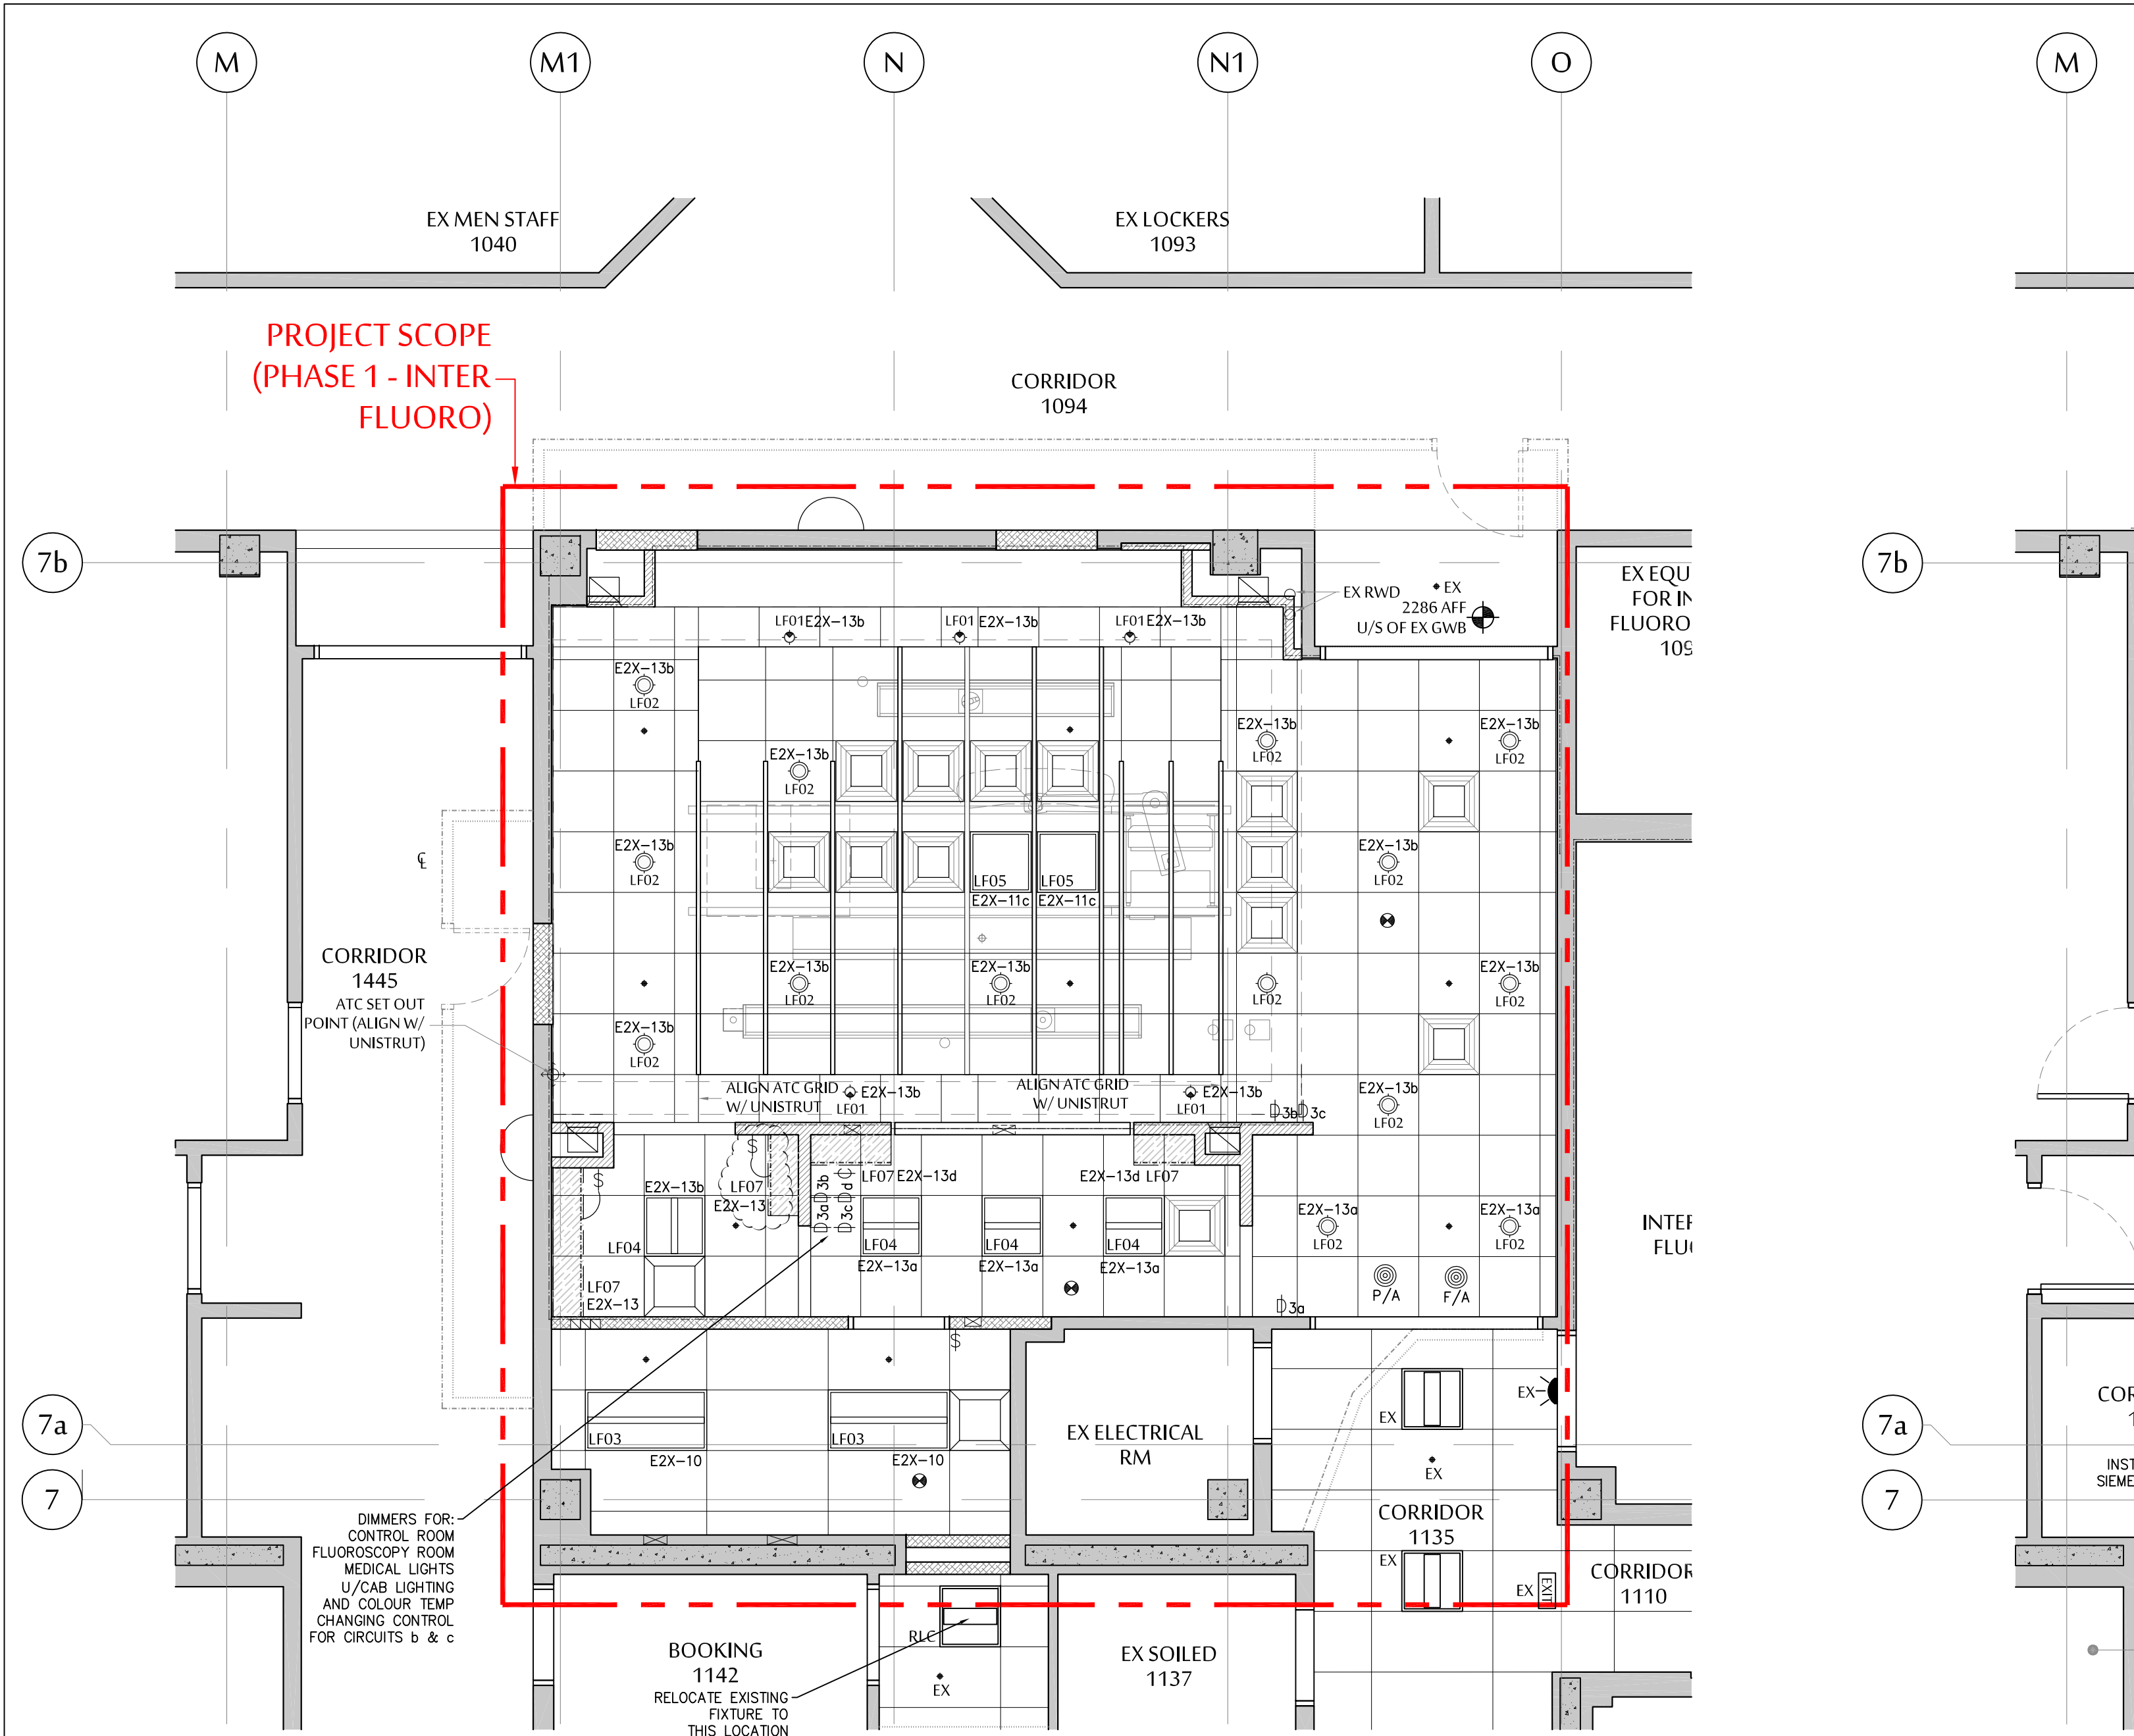

PHASE 1 - LEVEL 1 - LAYOUT RCP

SCALE : 1 = 50

LIGHTING LEGEND	
LF01	RECESSED 3.5" LED DIMMING LIGHT 12 WATTS, 850 LUMENS, 3500 DECK
LF02	RECESSED 5" 6" LED DIMMING LIGHT 20 WATTS, 1450 LUMENS, 3500 DECK
LF03	2x4" LED FLAT PANEL, 0-10V DIMMING 30W, 3600 LUMENS, 3500K
LF04	2x2" LED ARCHITECTURAL FIXTURE, 1% 0-10V DIMMING 20W, 2500 LUMENS, 3500K
LF05	2x2" LED CLEANROOM FIXTURE, 0-10V DIMMING, EMERGENCY LIGHTING PACK 112W, 12,225 LUMENS, 3500K
LF06	1x2" LED CLEANROOM FIXTURE, 0-10V DIMMING 45W, 3850 LUMENS, 3500K
LF07	LED UNDERCABINET LIGHTING, CUSTOM LENGTHS, 24VDC, DIMMING, WITH ALUMINUM PROFILE AND DIFFUSER, MOUNTING CLIPS 25W DIMMING POWER SUPPLY AND POWER FEEDS HWB-DIM-EDC-24V-25W
\$	15A LIGHT SWITCH ANTIMICROBIAL, WITH ANTIMICROBIAL STAINLESS COVERPLATE
⌚	MOTION ACTIVATED DIMMER SWITCH 1250mm ABOVE FLOOR
⌚	DIMMER SWITCH FOR LED, 3 WAY DIMMING WHERE NOTED FOR 3 WAY DIMMING USE ONE DIMMER AND ONE MA-R COMPANION DIMMER
⌚	SLIDE DIMMER SWITCH, 0-10V, FOR COLOUR TEMPERATURE CONTROL
XRAY	X-RAY WARNING LIGHT - LED, 24 VOLT WITH "RADIATION IN USE" WORKING
EXIT	LED EXIT LIGHT WITH INTEGRAL BATTERY BACKUP

NOTE: ALL LIGHT SWITCHES AND DIMMER SWITCHES TO HAVE ANTIMICROBIAL STAINLESS COVERPLATES


MECHANICAL EQUIPMENT SCHEDULE

ITEM	DESCRIPTION	UNIT LOCATION	SERVICE	LOAD	VOLTAGE	PHASE	BREAKER	FEEDER	CIRCUIT	STARTER	CONNECTED	TYPE	DISC SW	NOTES
FC-1	CHILLED WATER FAN COIL	ABOVE EQ. ROOM	EQUIP ROOM COOLING	0.5 HP	208	1	15A	2c#12	E2X-14/16	SUPPLIED MECH	INSTALLED MECH	ELEC	-	ELEC
HT-1,2	HEAT TRACE ON COLD WATER LINE	ABOVE EQ. ROOM	FLUORO ROOM	mech	208	1	15A	2c#12	NON-ESS	MECH	MECH	ELEC	-	GFI BREAKER - TRACE SUPPLIED BY MECHANICAL
ONTL JB	JUNCTION BOX FOR CONTROLS	SEE DRAWINGS	120 VOLT CONTROL POWER	frac	120	1	15A	2c#12	EDX-12	MECH	MECH	-	-	ELEC
MISC														
SK-1	HANDS FREE SINK	INTER FLUORO ROOM	HAND HYGIENE SINK	frac	120	1	15A	2c#12	EDX-2					PROVIDE ESSENTIAL POWER - JB FOR POWER
SK-2	SCRUB SINK JB	INTER FLUORO ROOM	SCRUB SINK JB	frac	120	1	15A	2c#12	EDX-2					PROVIDE ESSENTIAL POWER FOR CONTROL POWER
LCD	LCD PRESSURE MONITOR	INTER FLUORO ROOM	LCD DISPLAY POWER	frac	120	1	15A	2c#12	EDX-12					

ABOVE INFORMATION HAS BEEN PROVIDED FROM THE MECHANICAL DESIGNER AND MAY NOT BE COMPLETE. ELECTRICAL CONTRACTOR SHALL REVIEW THE MECHANICAL DRAWINGS, SPECIFICATIONS AND ADDENDA FOR A COMPLETE LIST OF MECHANICAL EQUIPMENT BEFORE SUBMITTING TENDER. PROVIDE ELECTRICAL CONNECTION AND CONTROL AS REQUIRED FOR A COMPLETE AND OPERATIONAL SYSTEM AND INCLUDE ALL COSTS IN THE TENDER PRICE. CONTRACTOR TO CONFIRM STARTER AND CONTROL REQUIREMENTS WITH MECHANICAL DIVISION BEFORE SUBMITTING TENDER.

NOTES:

- WIRING FOR 'HG' HOSPITAL GRADE RECEPTACLES TO BE IN #10 COPPER WITH #10 INSULATED BONDING CONDUCTOR, AND COMPLY WITH CEC SECTION 24 AND CSA Z32 STANDARDS.
- TERMINATE BONDING CONDUCTOR ON INSULATED BONDING BUS IN PANEL INDICATED.
- PROVIDE TESTING OF ALL 'HG' RECEPTACLES FROM THIRD PARTY TESTING AGENCY TO CSA Z32 STANDARDS BY INDEPENDENT THIRD PARTY TESTING AGENCY.
- REFER TO SPECIFICATIONS FOR TESTING REQUIREMENTS FOR FIRE ALARM AND NURSE CALL SYSTEMS.
- PROVIDE SERVICES OF HOSPITAL SECURITY CONTRACTOR TO REPROGRAM EXISTING KANTECH DOOR CONTROLLER IF REQUIRED TO PROVIDE CARD ACCESS CONTROL. SECURITY CONTRACTOR TO INCLUDE ALL WORK ASSOCIATED WITH ACCESS CONTROL AND CCTV WORK.
- ELECTRICAL CONTRACTOR TO SCAN/X-RAY SLAB FOR ALL REQUIRED FLOOR PENETRATIONS PRIOR TO CORING, AND CONFIRM LOCATIONS WITH HOSPITAL'S FACILITIES MANAGER AND PROJECT STRUCTURAL ENGINEER PRIOR TO CORING.
- FINAL LOCATIONS OF ALL RECEPTACLES TO BE APPROVED BY ARCHITECT ON SITE.
- FINAL LOCATIONS OF E-STOP BUTTONS TO BE CONFIRMED BY CLIENT ON SITE.
- PROVIDE RELAY AND CONNECTION FROM SIEMENS SYSTEM CABINET TO ALLOW CONTROL OF FLUOROSCOPY LIGHTING FROM FOOT PEDAL CONTROL.
- EXISTING NON-ESSENTIAL POWER CIRCUITS MAY BE REUSED FOR LOADS INDICATED AS NON-ESSENTIAL SHOW CIRCUITS ON AS BUILT DRAWINGS AND REVISE PANEL SCHEDULES.
- EXISTING ESSENTIAL POWER CIRCUITS ARE TO BE RENDERED SPARE - REMOVE WIRING, TURN OFF BREAKER AND REVISE PANEL SCHEDULES.
- USE #10 CU WIRING FOR ALL HOSPITAL GRADE RECEPTACLES WITH #12 INSULATED GROUND CONDUCTOR.
- E-STOP BUTTON TO BE WIRED TO SHUNT TRIP MAIN BREAKER IN PANEL IFL AND ALSO TO UPS CONTACTOR TO DISABLE ALL POWER TO THE FLUOROSCOPY MACHINE. REFER TO SIEMENS DRAWINGS.

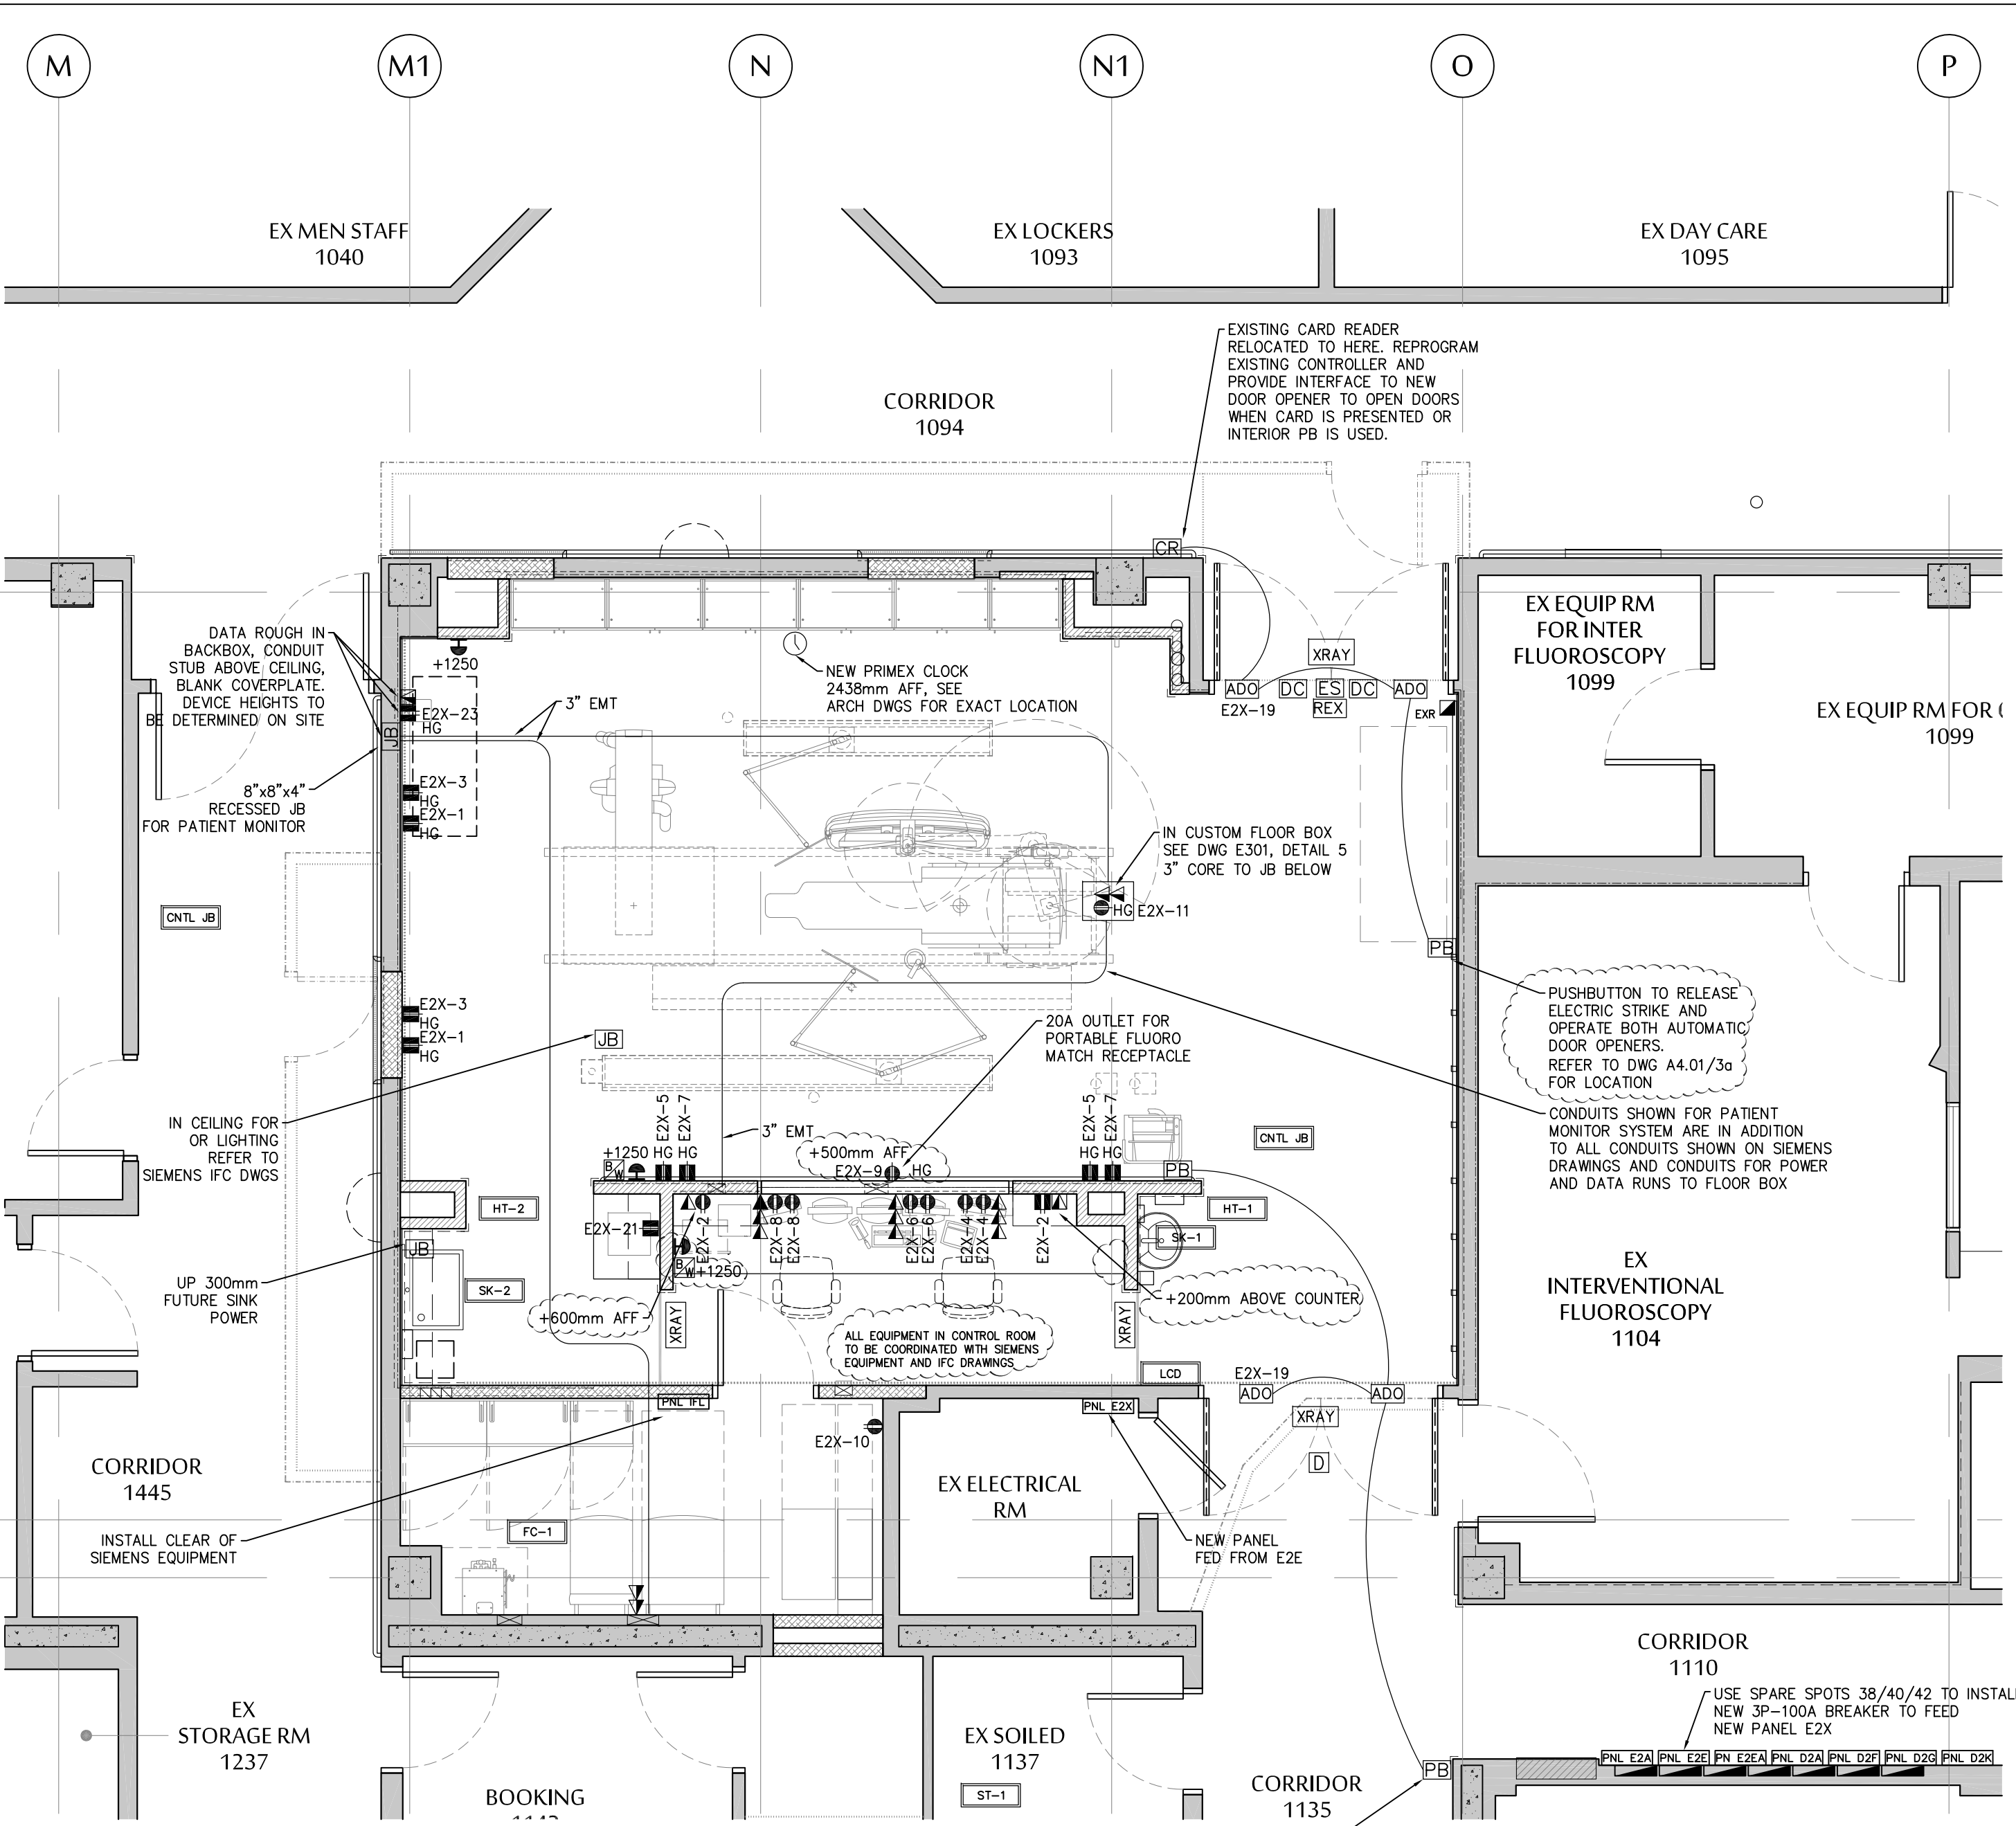


PHASE 1 - LEVEL 1 - LAYOUT PLAN

SCALE : 1 = 50

SECURITY SYSTEM LEGEND	
CR	EXISTING KANTECH CARD READER TO BE RELOCATED
PB	PUSH BUTTON FOR DOOR OPERATION - PROVIDED BY ELEC CONTRACTOR RELEASES STRIKE AND OPERATES BOTH DOOR OPENERS
ADO	AUTOMATIC (HANDICAPPED) DOOR OPERATOR PROVIDED BY OTHERS, WIRED BY ELECTRICAL
DC	DOOR CONTACT PROVIDED BY ELECTRICAL CONTRACTOR
ES	ELECTRIC STRIKE AND POWER TRANSFER HINGE SUPPLIED WITH DOOR
REX	REQUEST TO EXIT SENSOR PROVIDED BY ELECTRICAL CONTRACTOR

ELECTRICAL LEGEND	
COUNTER HEIGHT	ITEM DESCRIPTION
300mm A.F.F.	15A/20A DUPLEX RECEPTACLE - WHITE - ESSENTIAL POWER WITH STAINLESS STEEL COVERPLATE
	15A DUPLEX DEDICATED RECEPTACLE - ESSENTIAL POWER WITH STAINLESS STEEL COVERPLATE
	DUPLEX RECEPTACLE - HOSPITAL GRADE WITH STAINLESS STEEL COVERPLATE
	COMMUNICATION OUTLET - FT6 RATED CATEGORY 6 CABLE TO ROOM 1238 PROVIDE PLASTER RING AND 3/4" EMT TO ABOVE SUSPENDED CEILING SPACE
	PACS COMMUNICATION OUTLET - FT6 RATED CATEGORY 6 TO ROOM 1128 PROVIDE PLASTER RING AND 3/4" EMT TO ABOVE SUSPENDED CEILING SPACE
UP 2438mm	PRIMEX BATTERY POWERED WALL CLOCK REFER TO ARCHITECTURAL DRAWINGS FOR MOUNTING LOCATION
ON CEILING	FIRE ALARM HEAT DETECTOR
EX TO REMAIN	FIRE ALARM PULL STATION
UP 1250 AFF	EMERGENCY E-STOP BUTTON - 2NC/2NO CONTACTS, TURN/PULL TO RESET RED, WITH RECESSED BACKBOX AND PROTECTION SHROUD

NURSE CALL LEGEND	
B	NURSE CALL SYSTEM CODE BLUE / STATION WITH NEW HINGED PLASTIC COVER
BW	NURSE CALL SYSTEM CODE BLUE / CODE WHITE STATION WITH NEW HINGED PLASTIC COVER
D	NURSE CALL SYSTEM CORRIDOR ROOM INDICATOR LIGHT - WALL/CEILING MOUNTED

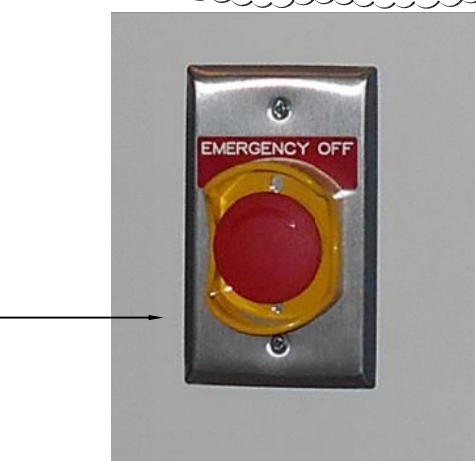

E-STOP BUTTON DETAIL
(DOOR CONTROL PUSHBUTTONS TO BE SIMILAR, WITHOUT 'EMERGENCY' LABEL)

PANEL IFL	
DESCRIPTION: INTERVENTIONAL FLUOROSCOPY SERVICE: 480/277V, 3ø, 4W	
FEEDER: - BUS: 200A	
MOUNTING: FLUSH	
MAIN BREAKER	200A SHUNT
Circuit Description	No. Brk.
-	1 2 -
-	70A 15A -
-	3 4 -
GENERATOR CABINET	70A 15A -
-	70A 15A -
-	7 8 -
-	15A 15A -
-	9 10 -
-	50A 15A -
UPS CABINET	50A 15A -
-	13 14 -
-	50A 15A -
-	15 16 -
-	17 18 -
-	15A 15A -
-	19 20 -
-	15A 15A -
-	21 22 -
-	15A 15A -
-	23 24 -
-	15A 15A -

SHUNT TRIP MAIN BREAKER CONFIRM ALL BREAKER SIZES WITH SIEMENS

NOT FOR CONSTRUCTION

NRS ENGINEERING LTD
Consulting Electrical Engineers
#212-556 North Necholas Road
Prince George BC V2K 1A1
www.nrsengineering.ca
Tel 250.562.0551
Fax 250.562.0558

ARCHITECT :



WWW.DCYTARCHITECTURE.CA

DRAWING LEGEND

- PROJECT AREA
- EXISTING WALL TO BE REMOVED (INCL ELEC, MECH, PLUMB & SPRINKLER WORK WITH-IN WALL)
- EXISTING WALL TO REMAIN
- NEW WALL
- NEW WALL WITH ACOUST INSULATION
- EXISTING DOOR & FRAME TO REMAIN (SEE DOOR SCHEDULE)
- EXISTING DOOR & FRAME TO BE REMOVED OR RELOCATED (SEE DOOR SCHEDULE)
- NEW DOOR & FRAME (SEE DOOR SCHEDULE)
- INTERIOR ELEVATION # / DWG #
- CROSS SECTION # / DWG #
- WALL TYPE (SEE WALL SCHEDULE)
- WINDOW TYPE (SEE WINDOW SCHEDULE)
- GLAZING PARTITION TYPE (SEE GLAZING PARTITION SCHEDULE)
- 90° CORNER GUARD
- 135° (OR CUSTOM ANGLE) CORNER GUARD
- FLOOR DRAIN
- GRAB BAR
- HANDICAPPED MIRROR
- MIRROR
- EXTENT OF ACCENT WALL (SEE ROOM FINISH SCHEDULE) - ALLOW FOR 1 COLOUR
- EXTENT OF LEAD LINING (SEE RAD. REPORT)
- EXTENT OF FIRE RETARDANT TREATED PLYWOOD BACKING
- FIRE EXTINGUISHER (36" A.F.F. TO BOTTOM OF CABINET) - SEE MECH DWGS

NO.	REVISION	DATE	BY
1	ISSUED FOR ADDENDUM 1	FEB 22, 2021	SY
2	ISSUED FOR TENDER	FEB 10, 2021	SY
3	ISSUED FOR 80% CD REVIEW	DEC 16, 2020	SY
4	ISSUED FOR BUILDING PERMIT	DEC 4, 2020	SY
5	ISSUED FOR DD	NOV 20, 2020	SY
6	2 NOT ISSUED	-	-
7	1 NOT ISSUED	-	-

THIS DRAWING IS THE PROPERTY OF DCYT ARCHITECTURE. REPRODUCTION OF THIS DRAWING IN WHOLE OR IN PART IS PROHIBITED UNLESS WITH WRITTEN PERMISSION.



UHNBC FLUOROSCOPY REPLACEMENT

1475 EDMONTON STREET, PRINCE GEORGE BC V2M 1S2

PHASE 1 - INTER FLUORO ELECTRICAL LAYOUT PLAN

SCALE:

1 : 50

DATE:

NOVEMBER 2020

DRAWN:

NRS

CHECKED:

NRS/SY

JOB NO.:

N2674

PHASE 1
E2.01