

PROJECT: Haida Gwaii Pharmacy Renovation Project

DATE: March 25th, 2025

KRA project no.: 2024-025

ADDENDUM NO.1

This addendum is to be read with and constitutes part of the tender document.

Instructions:

1. Amend your copy of the tender/quotation/proposal in accordance with the details below.

Details of the Addendum:

Part 1 GENERAL

1.1 General

- .1 This Addendum varies the Invitation to Tender Documents titled “ HAIDA GWAII - HGH Pharmacy NAPRA Upgrade” dated March 5th, 2025.
- .2 This Addendum shall form part of the Contract Documents and is to be read, interpreted and coordinated with all other parts. The cost of all work contained herein shall be included in the Contract sum. The following revisions supersede the information contained in the original specifications and drawings issued for the above-named project.
- .3 This Addendum is eighteen (18) pages in total.

1.2 Virtual Tender Walk-Through

- .1 Attendance List – See attached attendance list from virtual tender walk-through held on Tuesday, March 18th, 2025.
- .2 Virtual Meeting Recording – The virtual meeting recording can be accessed at the following link:
https://www.dropbox.com/scl/fi/k2zpoup7199wg0uszi6kc/Haida-Gwaii-Pharmacy-Virtual-Contractor-Walkthrough-20250318_100205-Meeting-Recording.mp4?rlkey=95t9pgg636248zqzjr2hvk75s&st=ta3zq825&dl=0

1.3 Modifications to the Tender Set – Architectural

Drawings

- .1 Sheet A3.100 Levels 00, 01, 02 and 03 - Partial Floor Plans and Details – Refer to attached revised drawing sheet.
 - a) **ADD** penetration through lead-lined wall assembly for new ductwork in X-Ray Room #2-202.

Specifications

- .1 Section 00 21 13 Instructions to Bidders Part 2. Pre-Bid Inquiries – Refer to attached revised specification section.
 - a) **REVISE** pre-bid inquiries receiver to Bids & Tenders
 - b) **REVISE** tenders inquiries period to 5 working days before the bid closing time.

- .2 Appendix A - Biological Safety Cabinet Cut Sheets
 - a) **REVISE** biological safety cabinet cut sheets

Attachments:

- Virtual Tender Walk-Through Attendance List (2025-03-18)
- Architectural drawing sheet A3.100 Levels 00, 01, 02 and 03 - Partial Floor Plans and Details (2025-03-21)
- Specifications Section 00 21 13 Instructions to Bidders (2025-03-18)
- Specifications Appendix A - Biological Safety Cabinet Cut Sheets



KIRSTEN REITE
ARCHITECTURE

ATTENDANCE LIST

DATE: March 18th, 2025 10:00am – 11:30am PST
PROJECT: Haida Gwaii Pharmacy Renovation Project
MEETING: Virtual tender walk-through

Name: Jay Dupas

Company: Northern Health Authority

Email: Jay.Dupras@northernhealth.ca

Name: Cameron Zaremba

Company: Northern Health Authority

Email: Cameron.Zaremba@northernhealth.ca

Name: Cairns Ives

Company: Northern Health Authority

Email: Cairns.Ives@northernhealth.ca

Name: Renaude Laberge-Boisjoli

Company: Kirsten Reite Architecture

Email: renaude@krarchitecture.ca

Name: Stuart Adamson

Company: Rocky Point Engineering

Email: stuart.adamson@rpeng.ca

Name: Martin Kwok

Company: Rocky Point Engineering

Email: martin.kwok@rpeng.ca

Name: Randa Khalil

Company: AtkinsRéalis

Email: Randa.Khalil@atkinsrealis.com

Name: Ian Coulman

Company: Technicon Industries

Email: ian@technicon-ind.com

Name: Tim Henschel

Company: Technicon Industries

Email: tim@technicon-ind.com

Name: Andrew Contumelias

Company: Technicon Industries

Email: andrew@technicon-ind.com

Name: Rob Coburn

Company: Technicon Industries

Email: rob@technicon-ind.com

Name: George Musterer

Company: Eby Construction Group

Email: George@ebycon.ca

Name: Rob Roy

Company: Northern Health Authority

Email: Jay.Dupras@northernhealth.ca

Name: Dan Webster

Company: Vector Projects Group

Email: dan@vpg.ca

Name: Tomm Adams

Company: Western Industrial Contractors Ltd.



Email: tommadams@wicltd.com

CONSULTANTS:

MECHANICAL: ROCKY POINT
ELECTRICAL: ATKIN REALIS
STRUCTURAL: BUSH BOLMAN PARTNERS

COPYRIGHT RESERVED. THIS DRAWING AND DESIGN SHALL NOT BE USED, REPRODUCED, OR REVISED WITHOUT WRITTEN PERMISSION FROM THE ARCHITECT. THE CONTRACTOR SHALL CHECK AND VERIFY ALL DIMENSIONS AND REPORT ALL ERRORS AND OMISSIONS TO THE ARCHITECT PRIOR TO COMMENCING THE WORK. THE DRAWINGS ARE NOT TO BE SCALED.

KEY PLAN

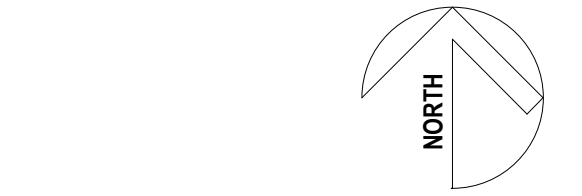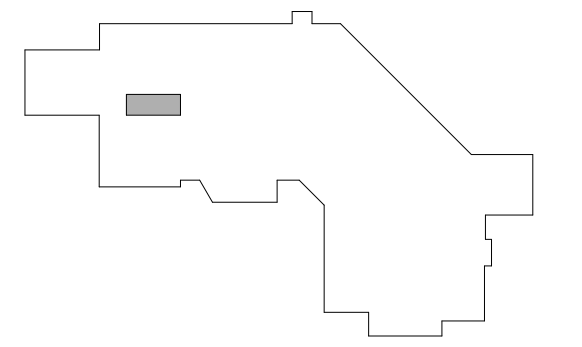

Issued For:

NO	ISSUANCE	DATE
1	ISSUED FOR INTERNAL REVIEW	2024-09-24
2	ISSUED FOR 90% CD REVIEW	2024-10-15
3	ISSUED FOR 100% CD	2024-11-08
4	ISSUED FOR TENDER	2025-03-03
5	ISSUED FOR ADDENDUM 01	2025-03-24

Project Title

Haida Gwaii Pharmacy Renovation Project

3209 OCEANVIEW DRIVE, DAAJING GIDS, BC, CANADA, V0T 1S0

Drawing Title

LEVELS 00, 01, 02 AND 03 - PARTIAL FLOOR PLANS AND DETAIL

Sheet Information

Date: 2025-03-03
Project Number: KRA PROJECT #2024-025
Drawn: LC
Checked: RLB
Approved: SG

Stamp

Drawing No.



A3.100

KEYNOTES	
1	PROVIDE HOARDING TO CORRIDORS TO SEPARATE CONSTRUCTION AREA FROM PUBLIC AREA AND FUNCTIONING AREAS TO NON-FUNCTIONING AREAS. GO TO ENSURE 1100MM MINIMUM WIDTH IS ACHIEVED TO PUBLIC SIDE OF CORRIDOR. GO TO CONFIRM HOARDING PLAN WITH OWNER PRIOR TO INSTALLATION.
2	CREATE OPENING THROUGH EXIST. FIRE-RATED WALL TO SUIT EXHAUST DUCTWORK. PROVIDE FIRE DAMPER AND MAKE GOOD EXISTING ASSEMBLIES. REFER TO CODE COMPLIANCE PLANS AND MECHANICAL SPECIFICATIONS.
3	CEILING ASSEMBLIES INCL. CEILING-MOUNTED FIXTURES AND ACCESSORIES TO BE REMOVED TO SUIT DUCTWORK SCOPE. REFER TO MECHANICAL AND ELECTRICAL. SET TILES AND FIXTURES ASIDE FOR REINSTALLATION. REPLACE ANY DAMAGED TILES & GRIDS.
4	EXISTING GWB CEILING TO BE DEMOLISHED TO SUIT DUCTWORK SCOPE. SET ASIDE ALL EXISTING FIXTURES FOR REINSTALLATION. REFER TO MECHANICAL AND ELECTRICAL.
5	EXISTING LIGHTING FIXTURE & SEISMIC RESTRAINT TO BE REMOVED TO SUIT DUCTWORK SCOPE. SET ASIDE FOR REINSTALLATION. REFER TO ELECTRICAL.
6	DUCTING CONNECTION TO EXISTING EXHAUST LOUVER. REFER TO MECHANICAL.
7	EXHAUST UNIT WITHIN OPEN WEB STEEL JOISTS. PROVIDE SEISMIC RESTRAINTS PAINTED TO MATCH EXISTING EXPOSED SLAB. REFER TO MECHANICAL.
8	EXISTING RADIANT PANEL TO BE REMOVED TO SUIT DUCTWORK SCOPE. SET ASIDE FOR REINSTALLATION AND REINSTALL. REFER TO MECHANICAL.
9	EXHAUST FAN ON EXISTING HOUSEKEEPING PAD. REFER TO MECHANICAL.
10	CREATE OPENING THROUGH LED-LINED WALL TO SUIT EXHAUST DUCTWORK. SEAL AND/OR WRAP SERVICES. MECHANICAL PENETRATION AND INSULATION WITH LEAD LINING AS REQUIRED TO MAINTAIN SAFETY STANDARDS.

PLAN LEGEND	
[Symbol]	DENOTES AREA OF WORK
[Symbol]	DENOTES UNDISTURBED AREAS
[Symbol]	EXISTING WALL / STRUCTURE / COLUMNS TO BE RETAINED
[Symbol]	SHADED LINE DENOTES EXISTING TO REMAIN
[Symbol]	DASHED LINE DENOTES EXISTING TO BE DEMOLISHED
[Symbol]	PROPOSED HOARDING EXTENT. CONFIRM HOARDING REQUIREMENTS WITH NHA AHEAD OF CONSTRUCTION START. ENSURE 1100mm CLEARANCE IS MAINTAINED IN CORRIDOR
[Symbol]	DENOTES EXTENT OF EXISTING CEILING TILES AND CEILING FIXTURES TO BE DEMOLISHED AND REINSTATED TO SUIT NEW DUCTWORK INSTALLATION
[Symbol]	EXISTING DOOR TO REMAIN
[Symbol]	PHOTO LOCATION REFERENCE




PHASING NOTES	
1	PHASING PLANS ARE PROVIDED FOR GUIDANCE AND REFERENCE ONLY. THE ARCHITECT OR OWNER MAY REVISE THE PHASING PLAN AT ANY TIME DURING CONSTRUCTION TO MEET SITE CONDITIONS OR DUE TO IMPACT TO ADJACENT AREAS.
2	REVIEW PHASING AND HOARDING PLAN WITH OWNER AND INFECTION CONTROL DEPARTMENT PRIOR TO COMMENCEMENT OF CONSTRUCTION.
3	THE PHASING NUMBERING IS SHOWN TO INDICATE THE NUMBER OF PHASES AND NOTIONAL SEQUENCING. HOWEVER THE CONTRACTOR IS REQUIRED TO ACCOMMODATE CHANGES IN SEQUENCING WHEN AND IF REQUIRED BY THE FACILITY.
4	THE CONTRACTOR IS REQUIRED TO WORK WITH THE FACILITY AND THEIR REPRESENTATIVES TO REVIEW THE SCHEDULING OF THE START AND FINISH OF EACH PHASE. AS THE FACILITY WILL BE COORDINATING THE SERVICES OF HOUSEKEEPING AND MOVING SERVICES AT EACH PHASE.
5	PROVIDE HOARDING AS REQUIRED TO MEET THE HEALTH AUTHORITY INFECTION CONTROL GUIDELINES AND REQUIREMENTS. MAINTAIN 1100MM MINIMUM CLEARANCE IN CORRIDORS AT ALL TIMES.
6	PROTECT ALL ADJACENT AREAS DURING CONSTRUCTION TO PREVENT DAMAGE.
7	REFER TO ELECTRICAL, MECHANICAL, AND STRUCTURAL FOR ADDITIONAL SCOPE OF WORK.
8	PROVIDE HOARDING TO COMPLETE THE SCOPE OF WORK, INCLUDING IN AREAS OUTSIDE THE RENOVATION AREA. REFER TO MECHANICAL AND ELECTRICAL DRAWINGS FOR ADDITIONAL FULL SCOPE OF WORK.
9	PAINT ALL HOARDING WHITE ON CORRIDOR SIDE.
10	HOARDING ACCESS DOOR LOCKSET TO BE KEVED AND COORDINATED WITH FACILITY MASTER KEY.
11	PROVIDE HOARDING IN ALL CORRIDORS.
12	PROVIDE SOLID HOARDING TO UNDERSIDE OF EXISTING CEILING AND POLY FROM CEILING TO UNDERSIDE OF STRUCTURE ABOVE THE CEILING SPACE. PROVIDE ANTE ROOMS, STICKY MATS AND USE AIR SCRUBBERS, UNLESS OTHERWISE REQUIRED BY INFECTION CONTROL PRACTITIONER AND APPROVED BY NHA.

GENERAL ACCESS NOTES	
1	HOSPITAL WASHROOMS ARE NOT AVAILABLE FOR TRADES USE DURING CONSTRUCTION UNLESS AUTHORIZED BY NHA.
2	TRADES MUST ADHERE TO INFECTION CONTROL PRACTICES SET BY HEALTH AUTHORITY. MUST BE CLEAN (NOT DIRTY/DUSTY) WHEN MOVING THROUGH SPACES OUTSIDE OF PROJECT SCOPE. REFER TO SPECIFICATIONS.
3	HOURS OF WORK: • MOST WORKS CAN BE CARRIED OUT DURING NORMAL HOURS (07:00 - 16:00, M-F). • ALL AFTER-HOURS WORK IS TO BE COORDINATED AND APPROVED BY SITE FACILITIES MANAGEMENT STAFF AND THE NHA PROJECT MANAGER. • ALL NOISY WORK AND/OR WORKS CREATING VIBRATION TO BE COORDINATED IN ADVANCE WITH THE OWNER.
4	CONTRACTOR SHALL PROVIDE MINIMUM 4 WEEKS NOTIFICATION PRIOR TO MECHANICAL/ELECTRICAL SHUTDOWNS. SHUTDOWN REQUEST FORMS ARE TO BE SUBMITTED TO THE NHA PROJECT MANAGER AT THIS TIME TO ALLOW FOR ADEQUATE COORDINATION. FINAL DATES FOR SHUTDOWNS ARE AT THE DISCRETION OF FM STAFF AND MAY BE ADJUSTED DEPENDING ON STAFFING AVAILABILITY/WORKLOAD.

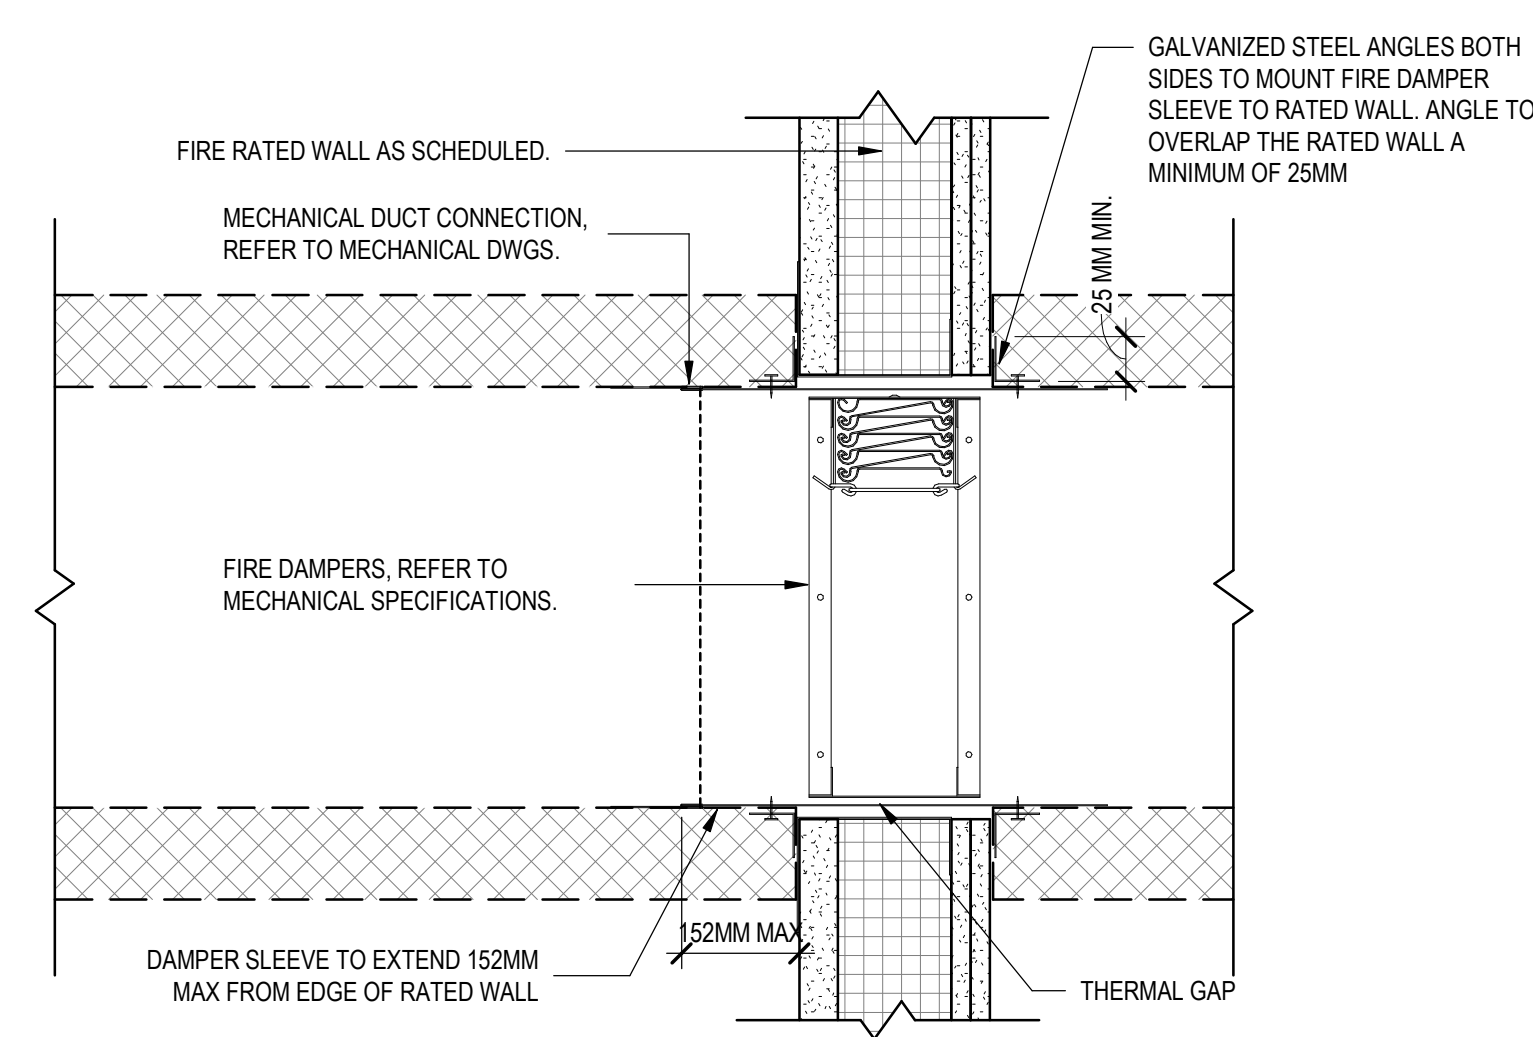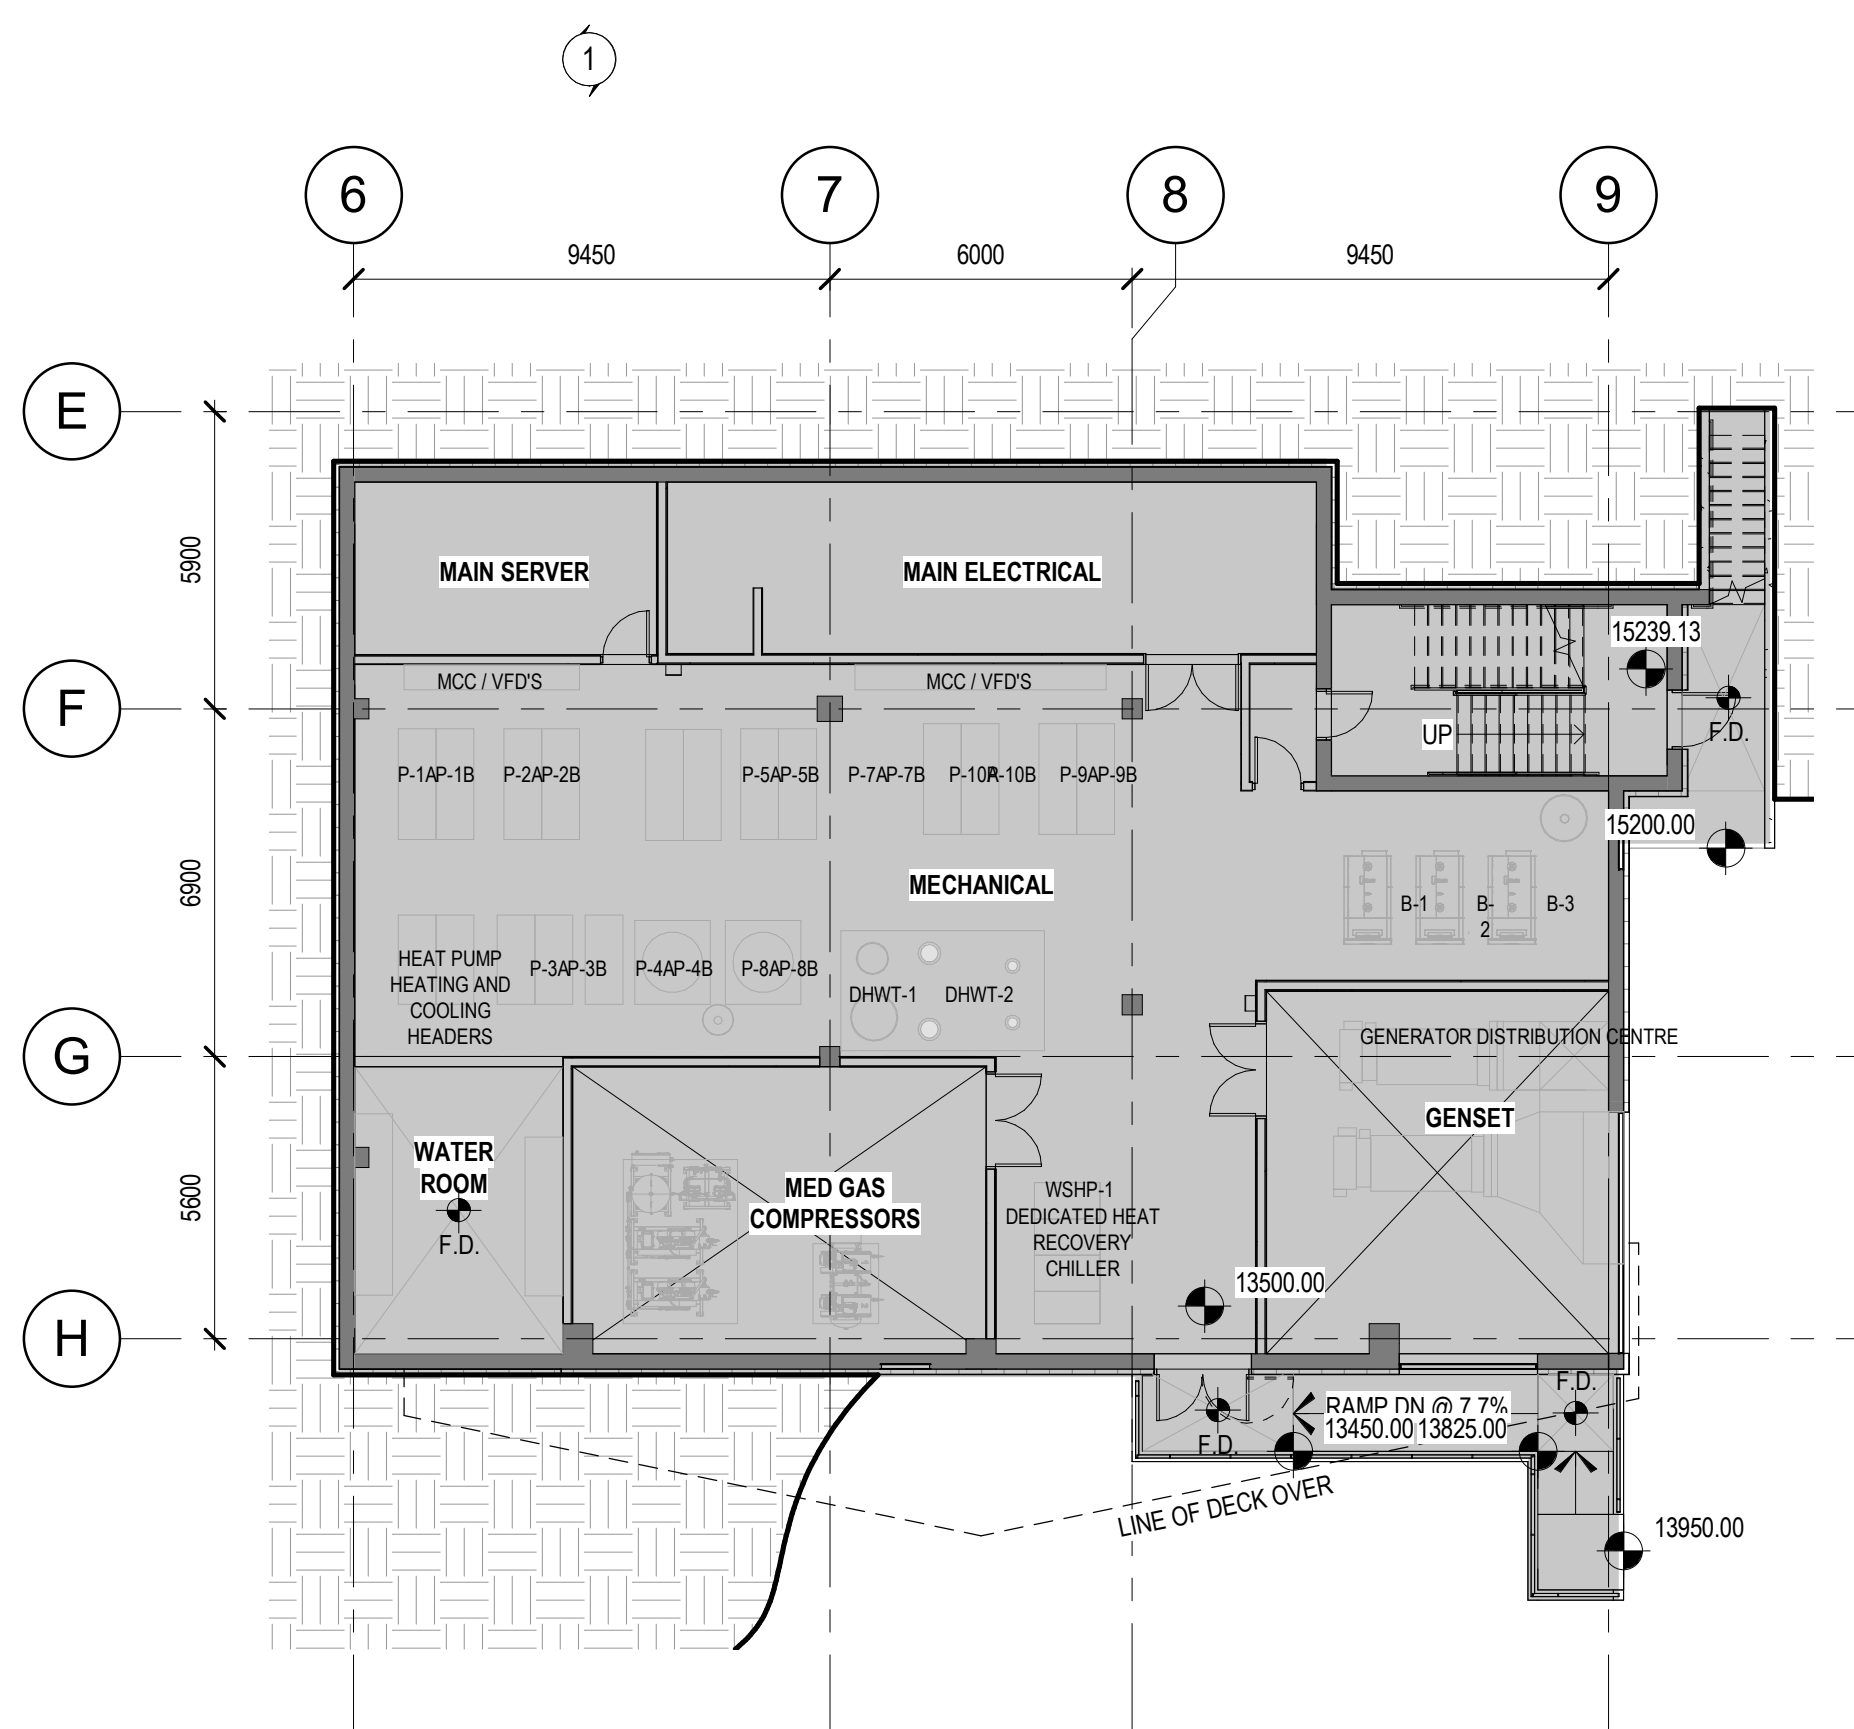

1 LEVEL 00 - PARTIAL FLOOR PLAN
A3.100 SCALE: 1:100

2 FIRE DAMPER THROUGH RATED WALL
A3.100 SCALE: 1:5

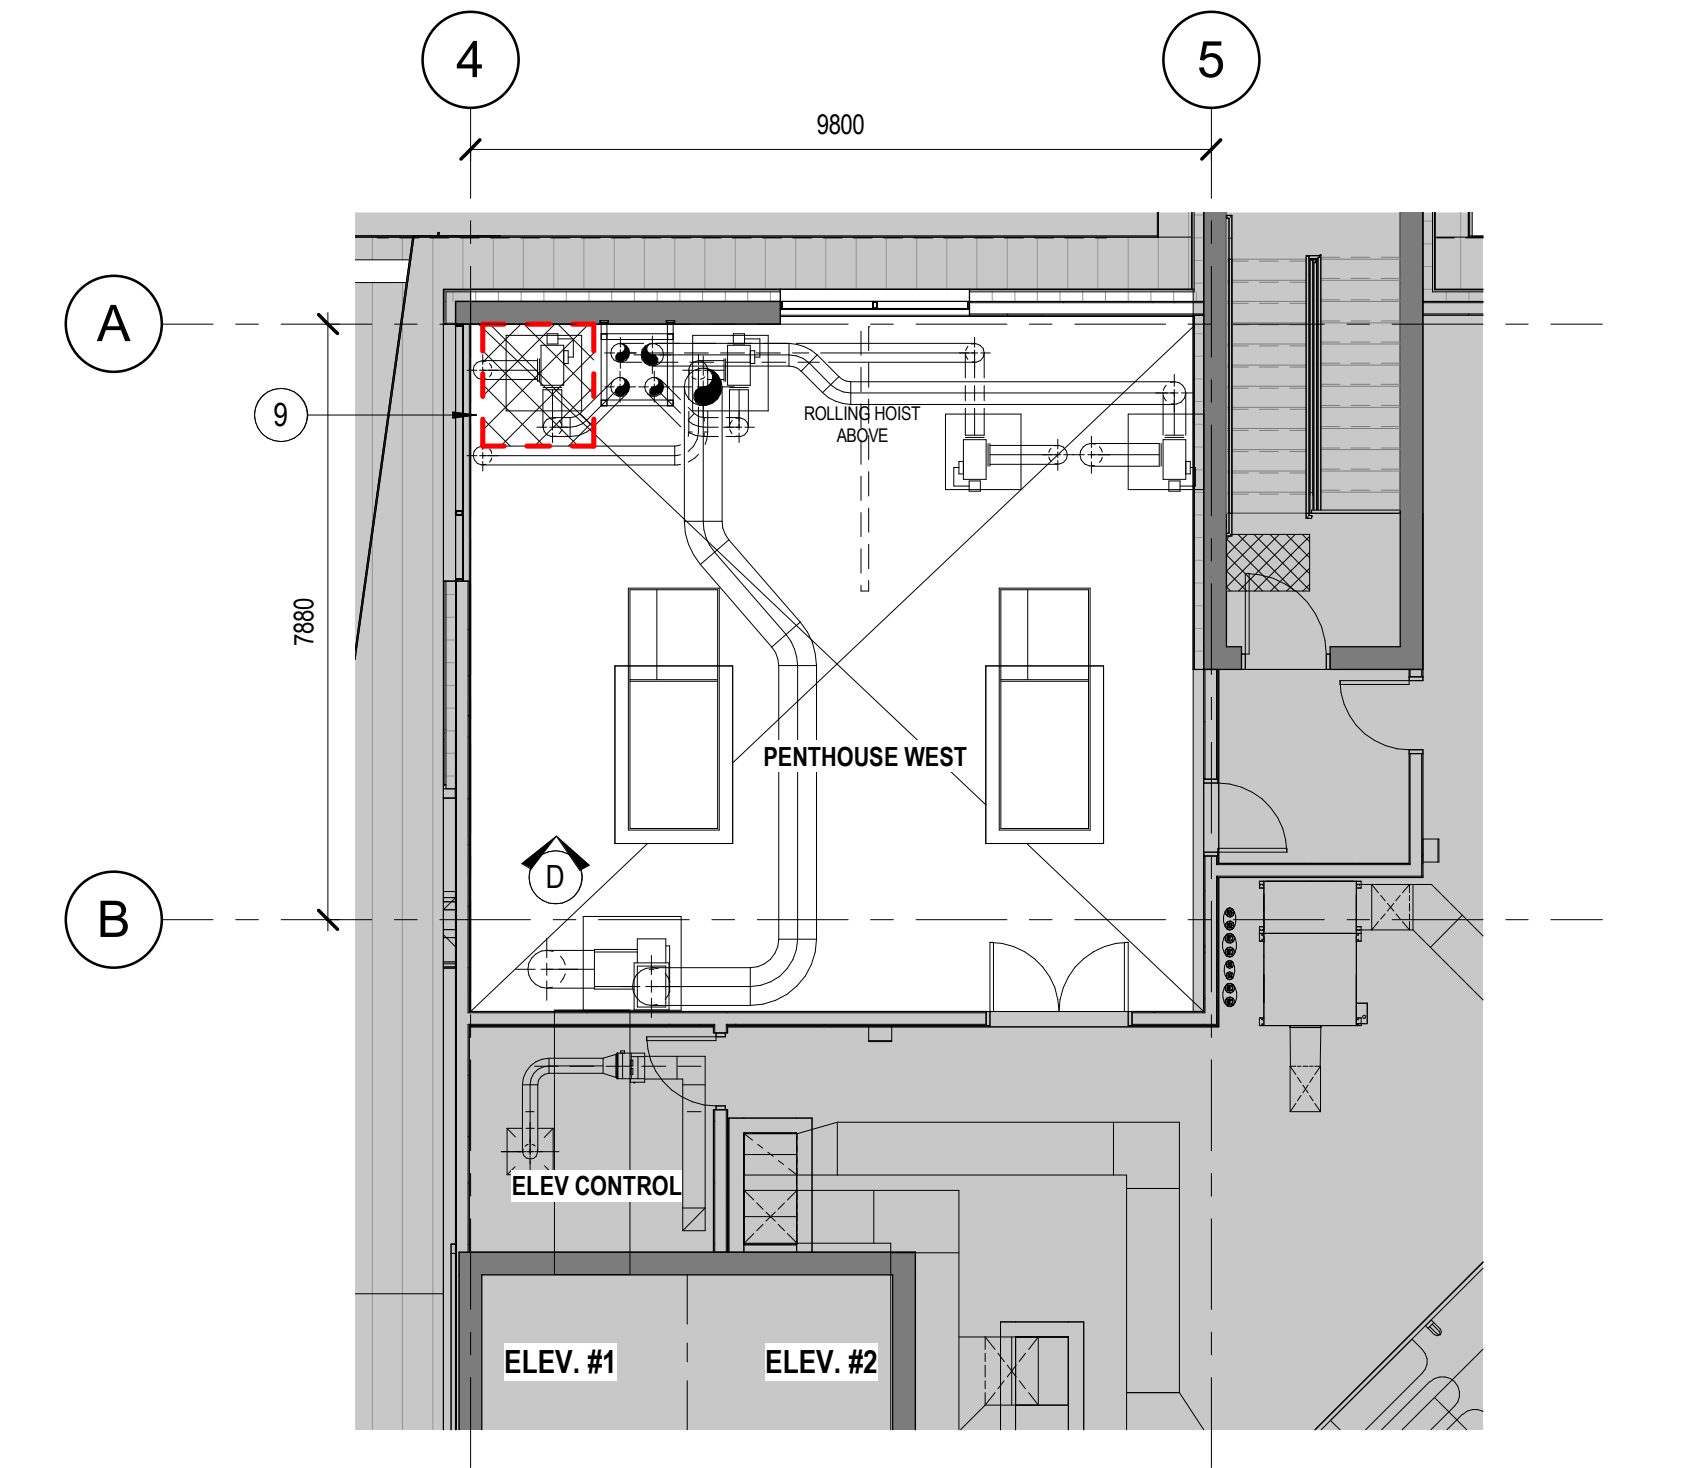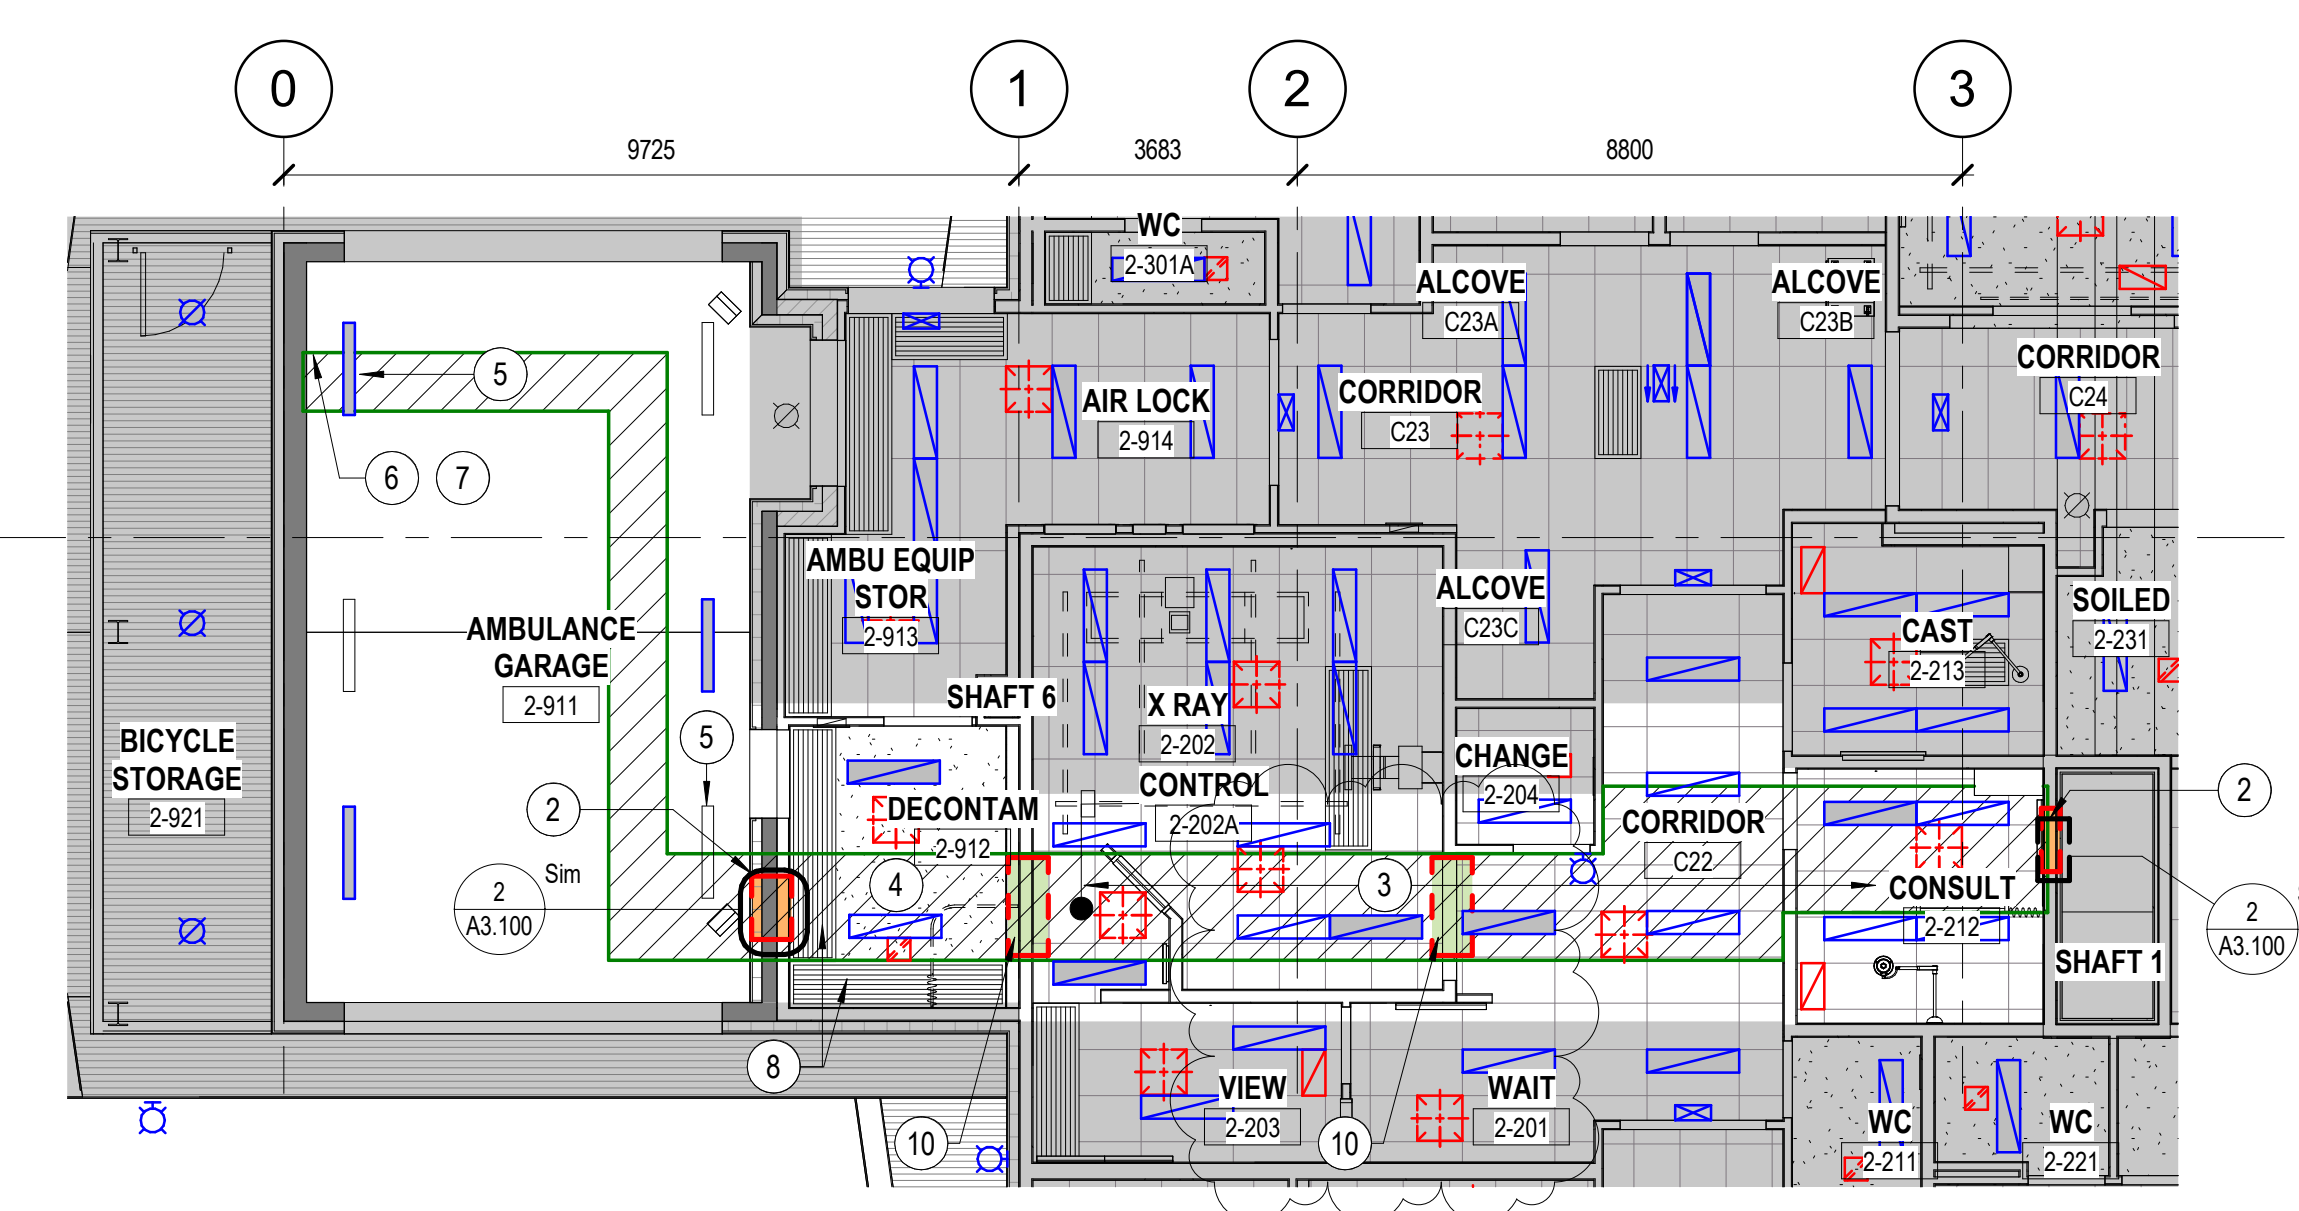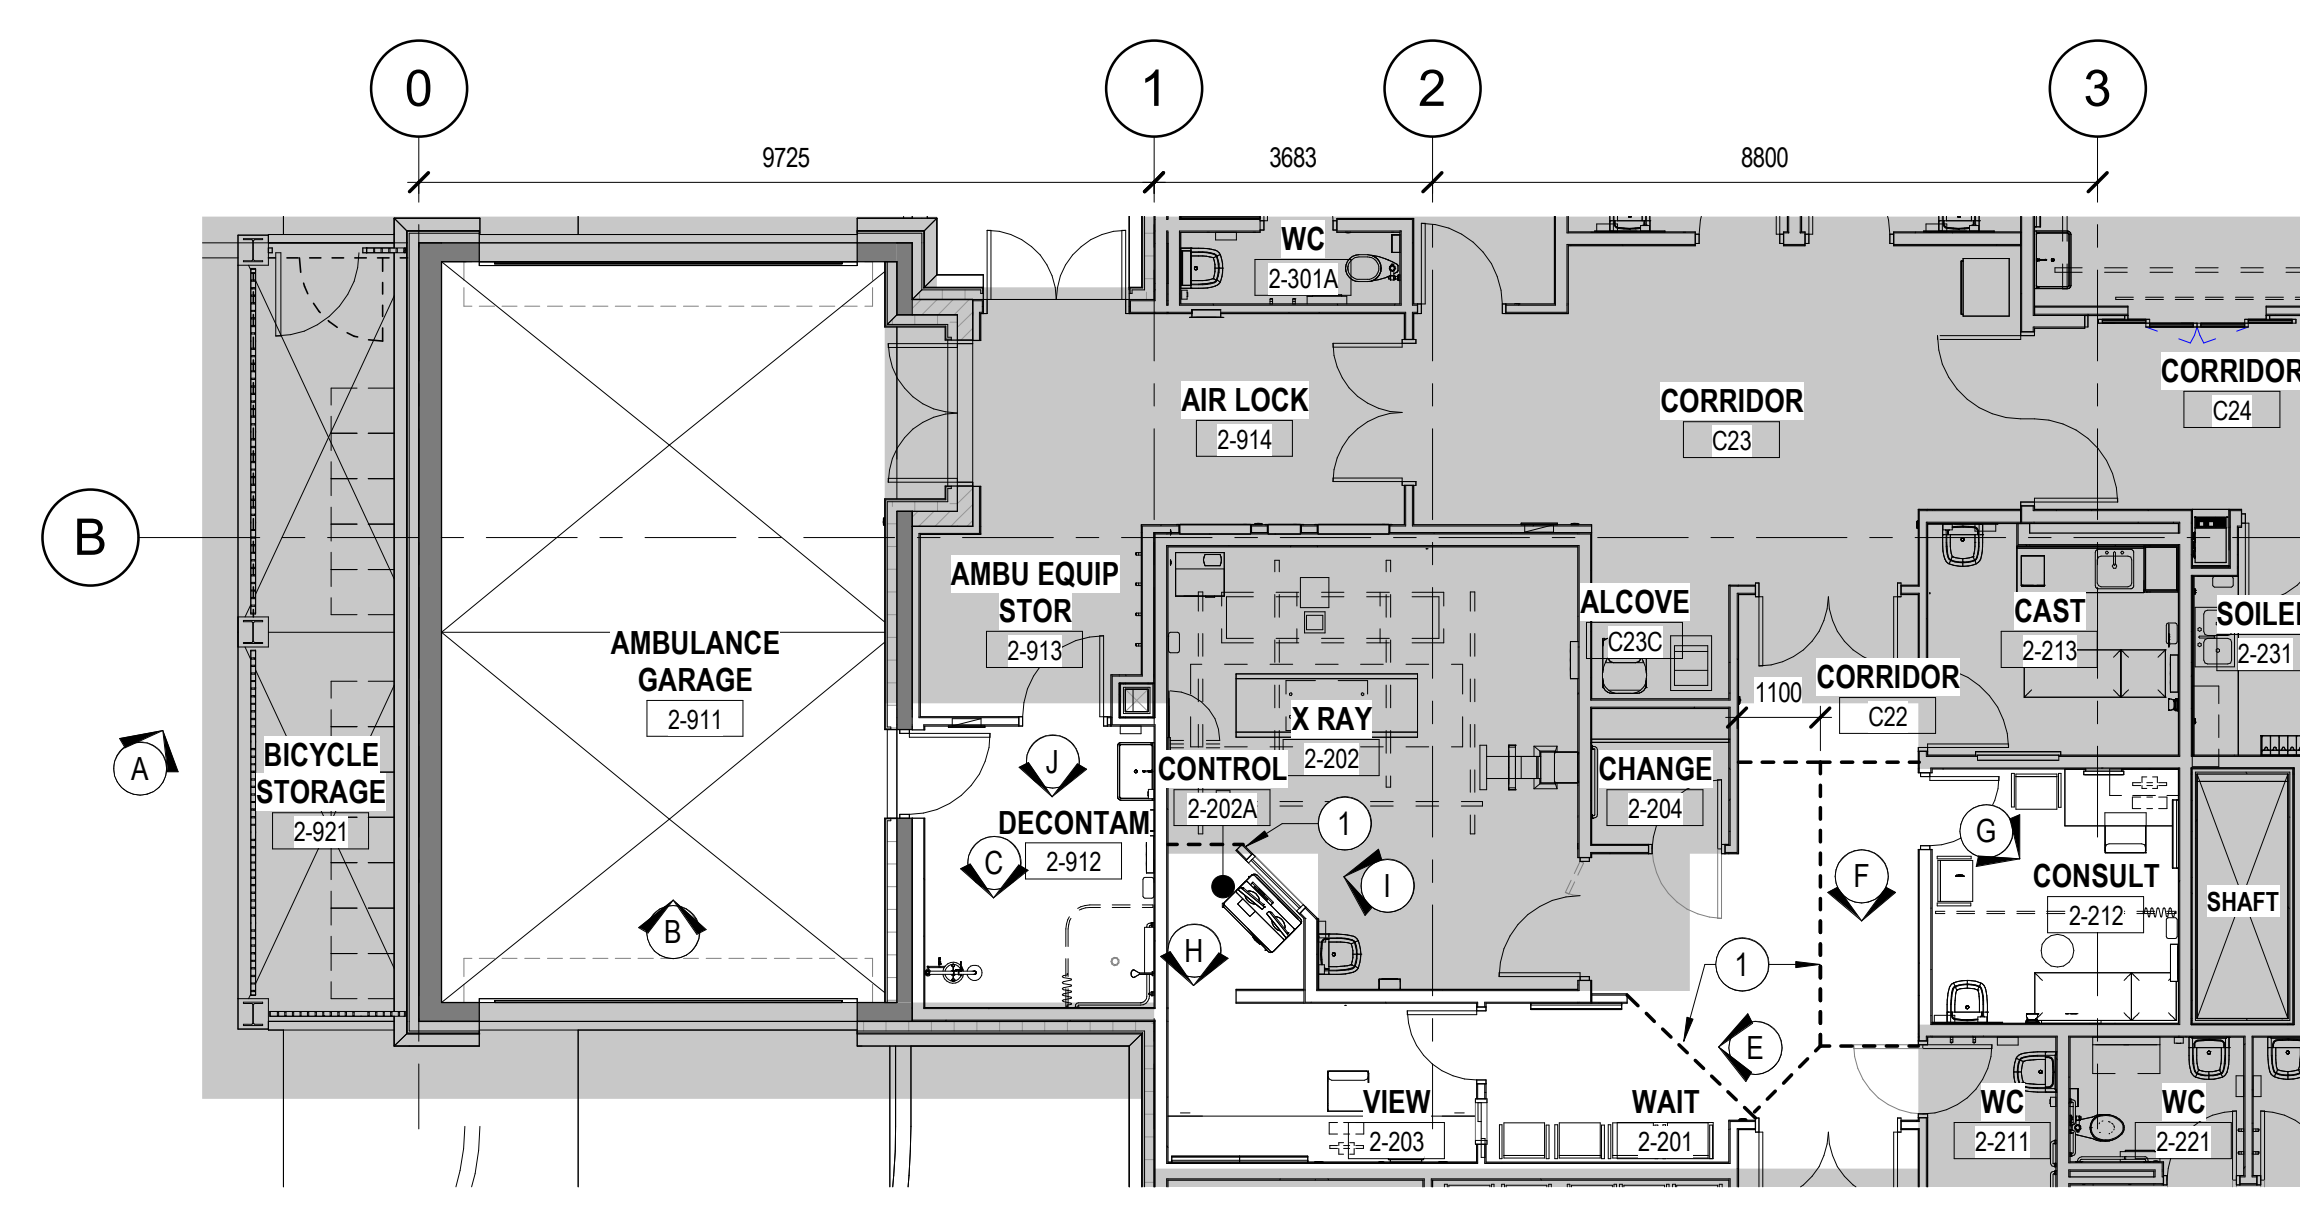

73 LEVEL 02 - PARTIAL FLOOR PLAN
A3.100 SCALE: 1:100

4 LEVEL 02 - PARTIAL DEMOLITION REFLECTED CEILING PLAN
A3.100 SCALE: 1:100

5 LEVEL 03 - MECHANICAL PENTHOUSE PARTIAL FLOOR PLAN
A3.100 SCALE: 1:100



IMAGE A: BICYCLE STORAGE

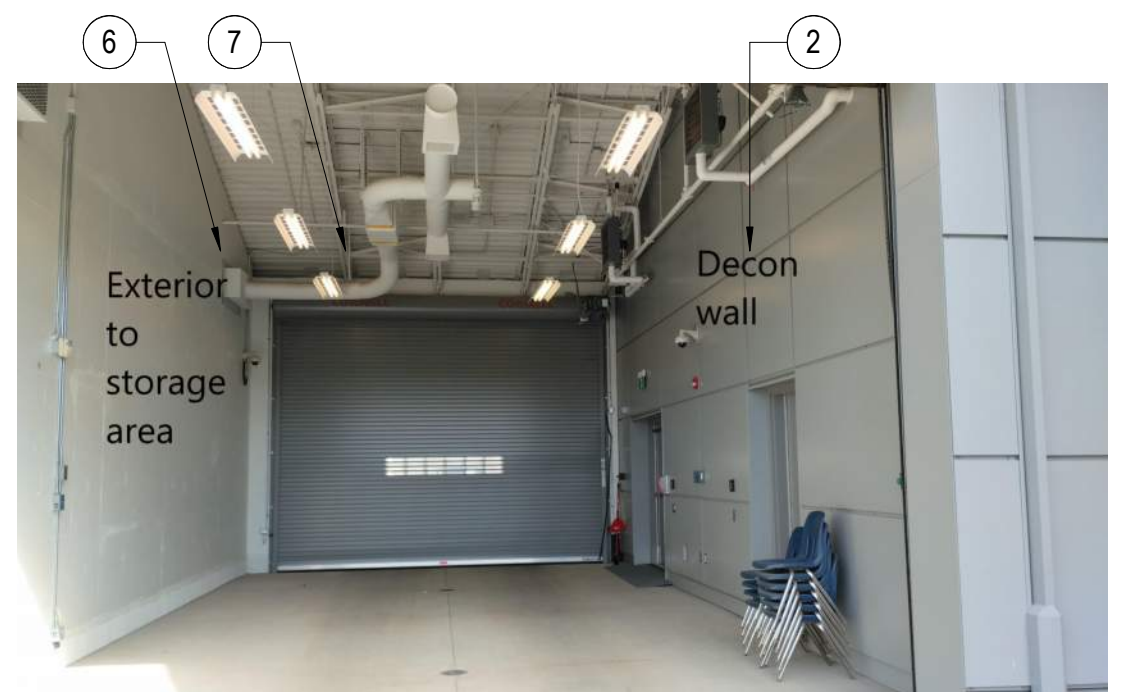


IMAGE B: AMBULANCE GARAGE



IMAGE C: DECONTAMINATION ROOM



IMAGE D: PENTHOUSE WEST



IMAGE E: C22 CORRIDOR



IMAGE F: C22 CORRIDOR



IMAGE G: CONSULT ROOM



IMAGE H: CONTROL ROOM



IMAGE I: CONTROL ROOM



IMAGE J: DECONTAMINATION ROOM



00 21 13 INSTRUCTIONS TO BIDDERS

1. DOCUMENTS

1.1 DOCUMENTS

- .1 Carefully examine the following information. Failure to follow these instructions may result in bid disqualification.
- .2 Project information:
 - .1 Project / Contract Name: _____
 - .2 Project / Contract No.: _____
 - .3 *Owner*: _____
 - .4 Project Address: _____

- .3 Examine the Bid Documents and promptly notify the person designated to receive inquiries of any perceived errors, omissions, conflicts or discrepancies in the Bid Documents.

1.2 BID DOCUMENTS

- (a) BCDC 2 - 2022, Part 1.1 Division 00 11 13 Advertisement for Bids;
- (b) BCDC 2 - 2022, Part 1.1 Division 00 21 13 Instructions to Bidders; 00 73 16 Insurance Requirements; 00 73 63 Contract Security Requirements;
- (c) BCDC 2 - 2022, Part 1.1 Division 00 41 13 Bid Form and Appendices;
- (d) CCDC 2 - 2020, Articles of Agreement;
- (e) CCDC 2 - 2020, General Conditions;
- (f) BCDC 2 – 2022, Part 1.2 Supplementary Conditions;
- (g) BCDC 2 – 2022, Part 1.3 Project Specific Amendments, if any;
- (h) General Requirements;
- (i) Drawings and Specifications;
- (j) Appendices, if any;
- (k) Addenda.

1.3 CONTRACT DOCUMENTS

- .1 Upon award of contract the Contract Documents consist only of (b) to (k) above. The *Owner* will prepare two copies of the Contract.



2. PRE-BID INQUIRIES

.1 Direct inquiries relating to Bid Documents, only to the *Consultant/Owner* at:

.2 Submit inquiries as early as possible in the bid period and not less than Working Days before the bid closing time. Inquiries received after this time may not receive a response.

3. PRE-BID SITE VISIT

~~.1 There will not be a pre-bid site visit for the Project.~~

.2 There will be pre-bid site visit for the Project.

~~2.1 Mandatory Site Visit~~

~~Failure of a Bidder's representative to attend and sign the attendance sheet will cause the Bid to be rejected as non-compliant.~~

2.2 Optional Site Visit

A pre-bid site visit has been scheduled for _____ local time on _____, 20____. Attendees will meet at _____

Bidders will be required to sign an attendance sheet during the meeting. Names of Bidders attending will be issued by addendum.

Issues arising from the pre-bid site visit will be addressed as required in an addendum to the Bid Documents. No meeting minutes will be issued. Bidders may not rely upon any information given verbally or otherwise at the pre-bid site visit and that is not confirmed by addendum.

Bidders visiting the Place of the Work must be accompanied at all times by a representative of the *Owner*.

Bidders visiting the Place of the Work must provide their own personal protective equipment.

2.3 *Owner* Requirements of Site Visit



4. PARTICULARS AFFECTING BID PRICE

4.1 MATERIALS

- .1 Establish the Bid Price based on the use of materials specified in Drawings and Specifications.
- .2 Proposed substitutions to materials specified will be considered during the bidding period only if full descriptive data are submitted in writing to the *Consultant/Owner* at least Working Days before the bid closing date.
- .3 Approved substitutions will be incorporated in the Drawings and Specifications by issuance of an Addendum.

4.2 CONDITIONS RELATED TO THE WORK

- .1 Become familiar with the site and existing conditions prior to submitting a bid and make allowances for conditions related to the Work.
- .2 Claims for an increase in Contract Price or Contract Time arising from observable conditions will be rejected by the *Owner*.

4.3 TAXES

 
- .1 Include in bid price all taxes and customs duties in effect at the time of the bid closing, except for Value Added Taxes as defined in the CCDC standard form of contract.

5. ADDENDA

- .1 Addenda may be issued to modify the Bid Documents in response to Bidder inquiries or as may be considered necessary.
- .2 All addenda issued during the bid period will become part of the Bid Documents.
- .3 No addenda will be issued later than 3 Working Days before the bid closing time, unless absolutely necessary.
- .4 Each Bidder must ascertain before bid submission that it has received all addenda issued during the bid period and must indicate the addendum number(s) of all addenda received with their bid submission.

6. INTERPRETATION AND MODIFICATION OF BID DOCUMENTS

1. If an inquiry requires an interpretation or modification of the Bid Documents, the response to that inquiry will be issued in the form of a written Addendum only, to ensure that all Bidders base their bids on the same information.
2. Replies to inquiries or interpretations or modifications of the Bid Documents made by e-mail, verbally, or in any manner other than a written Addendum, will not form part of the Bid Documents and will not be binding.



7. BID DEPOSITORY

.1 This Project will not use BidCentral Online Bidding for Subcontractors (“BOBS”), a bid depository system.

~~.2 This Project will use BidCentral Online Bidding for Subcontractors (“BOBS”), a bid depository system.~~

~~2a. The following subcontractors must submit their bid through BOBS and provide bonding per the Rules of Procedure (“Rules”):~~

~~2b. The following subcontractors must submit their bid through BOBS and do not require bonding:~~

~~.1 The date and time for the BOBS closing will be not less than two (2) working days prior to General Contractor bid closing and up to 3:00 PM on the date specified, subject to the Rules.~~

~~.2 The Rules of Procedure for BOBS, in force at the bid closing time, will apply.~~

~~.3 Subcontractors listed must submit their bids through BOBS via the specified method as defined in BidCentral (<https://www.bidcentral.ca/online-bidding-for-subcontractors/>).~~

~~.4 Where stipulated in section 2a, BOBS requirements in the Project Documents, and as required under the Rules, the subcontractor must provide a bond. Such bond must conform to the requirements of the Rules.~~

~~.5 General Contractors must confirm their Intention to Bid no later than two (2) Working Days (to the hour) prior to the BOBS closing date and time as per the requirements in the Rules for BOBS.~~

~~.6 Notwithstanding the requirements for exclusion of work contained in the Rules, ensure all Work described in the Bid Documents is included in the Bid Price.~~

~~.7 Where required by 2a and when requested to do so the Bidder agrees to provide the Owner with proof of Subcontractor bonds within ten (10) Working Days of Contract award.~~

~~.8 Only General Contractor Bids which list Trade Contractor Bids submitted in accordance with the Rules of Procedure for BOBS for those sections or divisions specified, will be subject to a recommendation of acceptance from the Bid Calling Authority to the Owner and any others will be rejected.~~



□ Bid Submission: ONLINE BIDDING SYSTEM SUBMISSIONS

8E. COMPLETION OF BID FORM

- .1 All Bidders should familiarize themselves regarding online bidding requirements relating to system failure, functionality of the online system, Exclusion of Liability, Terms and Conditions for Online Bidding and Privacy Policy.
- .2 Bidders must complete the bid on the Bid Form included in the Online Bidding System and execute in accordance with provisions of Clause 9E of the Instructions to Bidders - EXECUTION OF THE BID.
- .3 If required, state the number of weeks within which the Bidder will achieve *Ready-for-Takeover*.
- .4 If required, indicate receipt of Addenda.

9E. EXECUTION OF THE BID

- .1 Execute the Bid Form by the method of the Bidder's identification and authentication as designated in the On-line Bidding System.

10E. DELIVERY OF THE BID

- .1 All Bids must be submitted through the On-line Bidding System not later than the date and time specified for the On-line Bidding System closing. Bids submitted after On-line Bidding System closing time will not be allowed by the On-line Bidding System.
- .2 The time as indicated on the On-line Bidding System will be the official time for the On-line Bidding System closing.
- .3 The *Owner* is neither liable nor responsible for costs incurred by Bidders in the preparation, submission or presentation of the bid. Bidders will be required to accept on-line the Terms and Conditions of the On-line Bidding System in Clause 13.2 Terms and Conditions.
- .4 Bid documents become the property of the *Owner*.

11E. BID MODIFICATION AND WITHDRAWAL

- .1 Bidders must comply with procedures for electronic bid modification and withdrawal established by the online bidding system.

12E. BID SECURITY REQUIREMENTS

- .1 Digitally Verified Bid Bonds must be submitted through the online bidding system. Digitally verified Bid Bonds must be provided by the Bidder's Surety representative through one of the ebond providers assessed by the Surety Association of Canada. Bid Bonds must include a clearly legible signature and seal. The attachment by the Bidder of the Bid Bond with the on-line creates the lawful act of validating the bond by the Bidder.
- .2 Ensure the Bid Form is accompanied by a bid bond in the amount of ten percent (10%) of the Bid Price, Certified cheques and guaranteed letters of credit will **not** be accepted.
- .3 Ensure the bid bond is issued on a CCDC 220 Bid Bond form or other form approved by the Surety Association of Canada and issued by a Surety acceptable to the *Owner*.



- .4 If a successful Bidder declines to enter a Contract within the period set out in the Bid Form, or a further agreed period of time, the principal and surety will be required to pay to the *Owner* a sum equivalent to the difference between the principal's bid and the accepted bid or ten percent (10%) of the principal's bid, whichever is the lesser.
- .5 The bid bond must name the *Owner* as specified in the bid document as the obligee and must be signed, sealed, and dated by both Bidder and surety.

00 21 13 (con't) INSTRUCTION TO BIDDERS

13. BID ACCEPTANCE

- .1 The lowest or any bid will not necessarily be accepted.
- .2 The *Owner*, at its sole discretion, may accept or reject any or all of the Alternative Prices submitted in the Bid Documents. Alternative Prices will not be considered in determining the successful Bidder.
- .3 Alternative Prices listed in the Bid Documents will remain open for acceptance by the *Owner* for the period stated in the Bid Documents, from the time and date specified for closing of bids.
- .4 Bids which contain qualifying conditions or otherwise fail to conform to these Instructions to Bidders may, at the sole discretion of the *Owner*, be disqualified or rejected.
- .5 The *Owner* retains the separate right to waive minor irregularities in the Bid Form if such irregularities have not provided the Bidder with a competitive advantage.
- .6 In the event a single bid is received, the *Owner* may open the bid privately without reference to the Bidder. If the bid is opened and it is in excess of the *Owner's* budget, the *Owner* reserves the right to re-issue the Bid Documents for new public re-bid without revisions being made to the Bid Documents and without disclosing the single Bid Price. The *Owner* reserves the right to accept or reject a single bid.
- .7 The *Owner* has the right to enter into over-budget negotiations with the lowest compliant Bidder or a single Bidder, without cancellation of all bids or consideration to other Bidders, and to require that Bidder to negotiate with Subcontractors named on their Bid Form.

14. BID ACCEPTANCE PERIOD

- .1 Bids will remain open to acceptance by the *Owner* and will be irrevocable until another Bidder enters into a contract with the *Owner* for performance of the Work or until expiry of the bid acceptance period stated in the Bid Form, whichever occurs first.
- .2 After bid closing and before expiry of the bid acceptance period stated in the Bid Form, the *Owner* may request all Bidders to agree to an extension of the originally specified bid acceptance period. In such case the bid acceptance period will be extended subject to the Bidder, whose bid the *Owner* wishes to accept, having agreed in writing to the extension.
- .3 Where the bidding for procurement of construction services for this project has a method where unofficial bid results are made available publicly after the bid closing time, and before expiry of the bid acceptance period stated in the Bid Form, the *Owner* may request all Bidders to agree to an extension of the originally specified bid acceptance period. In such case, the bid acceptance period will be extended, subject to the lowest compliant Bidder having agreed in writing to the extension.



15. WORKSAFE BC LETTER

- .1 After bid closing, upon request, the lowest compliant Bidder agrees to provide a WORKSAFE BC Letter of Good Standing within forty-eight (48) hours.

END OF SECTION



Environments For Science™

PRODUCT SPECIFICATIONS

BioChemGARD® e³

MODELS

BCG401, BCG601

BCG401-INT, BCG601-INT



SPECIFICATIONS	BCG 401		BCG 601	
Exterior Dimensions				
Nominal Size	4' [1.20 m]		6' [1.80 m]	
Foot Print (w x f-b)	53 7/8" x 33 5/8" [1,369 mm x 854 mm]		77 7/8" x 33 5/8" [1,978 mm x 854 mm]	
Height Range	86" to 94 1/2" [2,184 mm x 2,400 mm]		86" to 94 1/2" [2,184 mm x 2,400 mm]	
Weights				
Cabinet Weight	720 lbs [327 Kg]		850 lbs [386 Kg]	
Shipping Weight	850 lbs [386 Kg]		1,020 lbs [463 Kg]	
Low Static Pressure Kit (Option)	Add 20 lbs [9.1 Kg] to cabinet weight		Add 50 lbs [22.7 Kg] to cabinet weight	
Interior Dimensions				
Interior Dimensions (w x f-b x h)	46" x 22 7/8" x 27 5/8" [1,168 mm x 581 mm x 701 mm]		70" x 22 7/8" x 27 5/8" [1,778 mm x 581 mm x 701 mm]	
Useable Workspace (w x f-b x h)	44 5/8" x 18" x 27 5/8" [1,132 mm x 457 mm x 701 mm]		68 5/8" x 17 5/8" x 27 5/8" [1,742 mm x 448 mm x 701 mm]	
Exhaust and Static Pressure Requirements^{1 & 2}				
8" [203 mm] working access opening				
Concurrent Balance Value @ 40 fpm [0.2 m/s] downflow	664 CFM [313 l/s]		993 CFM [469 l/s]	
Exhaust Duct Static Pressure	Standard	Low Static Option	Standard	Low Static Option
8" Exhaust Duct Diameter	-1.9 "W.G. [-473 Pa]	-1.7 "W.G. [-423 Pa]	-2.3 "W.G. [-573 Pa]	-2.0 "W.G. [-498 Pa]
10" Exhaust Duct Diameter	-1.7 "W.G. [-423 Pa]	-1.5 "W.G. [-374 Pa]	-1.8 "W.G. [-448 Pa]	-1.6 "W.G. [-399 Pa]
12" Exhaust Duct Diameter	-1.6 "W.G. [-399 Pa]	-1.4 "W.G. [-349Pa]	-1.7 "W.G. [-423 Pa]	-1.5 "W.G. [-374 Pa]
10" [254 mm] working access opening (no NSF listing)				
Concurrent Balance Value @ 40 fpm [0.2 m/s] downflow	768 CFM [362 l/s]		1,158 CFM [547 l/s]	
Exhaust Duct Static Pressure	Standard	Low Static Option	Standard	Low Static Option
8" Exhaust Duct Diameter	-2.0 "W.G. [-498 Pa]	TBD	-2.3 "W.G. [-573 Pa]	TBD
10" Exhaust Duct Diameter	-1.8 "W.G. [-448 Pa]	TBD	-2.0 "W.G. [-498 Pa]	TBD
12" Exhaust Duct Diameter	-1.7 "W.G. [-423 Pa]	TBD	-2.5 "W.G. [-623 Pa]	TBD
12" [305 mm] working access opening (no NSF listing)				
Concurrent Balance Value @ 50 fpm[0.25 m/s] downflow	850 CFM [401 l/s]		1,430 CFM [675 l/s]	
Exhaust Duct Static Pressure	Standard	Low Static Option	Standard	Low Static Option
8" Exhaust Duct Diameter	-2.8 "W.G. [-697 Pa]	TBD	TBD	TBD
10" Exhaust Duct Diameter	-2.5 "W.G. [-623 Pa]	TBD	-2.7 "W.G. [-673 Pa]	TBD
12" Exhaust Duct Diameter	-2.4 "W.G. [-598 Pa]	TBD	-2.5 "W.G. [-623 Pa]	TBD

ReadySafe Mode Exhaust and Static Pressure Requirements¹				
Concurrent Balance Value	300 CFM [142 L/Sec]		300 CFM [142 L/Sec]	
Exhaust Duct Static Pressure ³	Standard	Low Static Option	Standard	Low Static Option
8" Exhaust Duct Diameter	-0.35 "W.G. [-87 Pa]	-0.16 "W.G. [-40 Pa]	-0.18 "W.G. [-45 Pa]	-0.16 "W.G. [-40 Pa]
10" Exhaust Duct Diameter	-0.30 "W.G. [-75 Pa]	-0.15 "W.G. [-37 Pa]	-0.16 "W.G. [-40 Pa]	-0.15 "W.G. [-37 Pa]
12" Exhaust Duct Diameter	-0.29 "W.G. [-72 Pa]	-0.14 "W.G. [-35 Pa]	-0.16 "W.G. [-40 Pa]	-0.14 "W.G. [-35 Pa]
Performance				
Working Access Opening				
Area	2.56 ft ²		3.89 ft ²	
Height	8" [203 mm]		8" [203 mm]	
Maximum Access Opening Height				
Area	6.39 ft ²		9.72 ft ²	
Height	20" [508 mm]		20" [508 mm]	
Cabinet Air Recirculation/Exhaust	Class II Type B2 Compliant			
Noise per NSF ANSI with exhaust running	59 dBA		60 dBA	
Average Intake Airflow Velocity	105 FPM [0.5 m/s]			
Average Down Flow Velocity	40 FPM [0.2 m/s]			
Lighting	Minimum 100 foot candles [1,076 lux] average at work surface			
Typical Motor/Blower Reserve				
100 V	100%		100%	
115 V	420%		420%	
220 V	100%		100%	
Plumbing Service				
	3/8" OD Tube fitting connectors. Plumbing service is rated for 30 psig [207 kPa]			
Electrical				
Service Requirements				
100 V	100 V AC, 20 A, 50/60 Hz, 1Ø, 16 A maximum useable current			
115 V	115 V AC, 20 A, 60 Hz, 1Ø, 16 A maximum useable current			
220 V	220 V AC, 16 A, 50/60 Hz, 1Ø, 13 A maximum useable current			
Circuit Protection				
100/115 V	Internally protected with a 250 V, 20 A circuit breaker			
220 V	Internally protected with a 250 V, 16 A circuit breaker			
Power Cord				
100/115 V	One 14' [4.27 m] power cord with 20-amp plug, type NEMA 5-20P			
220 V	One 4 m power cord with listed plug for the destination country			
Outlets				
100 V	Two NEMA 5-15 duplex outlets. The outlets on this circuit are protected by a self-resetting circuit breaker. This breaker allows a total of 7 A on all outlets.			
115 V	Two NEMA 5/15 GFCI duplex outlets. The outlets on this circuit are protected by a self-resetting circuit breaker. This breaker allows a total of 7 A on all outlets.			
220 V	Two 220 V AC, outlets listed for use in the destination country. The outlets on this circuit are protected by self-resetting circuit breakers. The			

	breakers allow a total of 7 A on all outlets.	
Typical Electrical Operation		
Motor Current		
100 V	0.7 A	0.9 A
115 V	0.6 A	0.8 A
220 V	0.3 A	0.4 A
Operating Current		
100 V	1.1 A	1.5 A
115 V	1.0 A	1.4 A
220 V	0.5 A	0.7 A
Power Consumption		
100 V	110 W	150 W
115 V	115 W	161 W
220 V	110 W	154 W
Heat Generation (calculated)		
100 V	375 Btu/Hr	512 Btu/Hr
115 V	392 Btu/Hr	549 Btu/Hr
220 V	375 Btu/Hr	526 Btu/Hr
ReadySAFE™ Current		
100 V	0.2 A	0.2 A
115 V	0.3 A	0.3 A
220 V	0.1 A	0.1 A
ReadySAFE™ Power Consumption		
100 V	20.0 W	20.0 W
115 V	34.5 W	34.5 W
220 V	22.0 W	22.0 W
ReadySAFE™ Heat Generation		
100 V	68 Btu/Hr	68 Btu/Hr
115 V	118 Btu/Hr	118 Btu/Hr
220 V	75 Btu/Hr	75 Btu/Hr
Environmental Conditions		
Use	Indoors	
Altitude	Up to 6,561' [2,000 meters]	
Temperature Range	From 41°F [5°C] to 104°F [40°C]	
Relative Humidity	Maximum 80% for temperatures up to 88°F [31°C] decreasing linearly to 50% at 104°F [40°C]	
Voltage	Main supply voltage ± 10% V AC	
Transient	Over voltage according to Installation Category (OVERVOLTAGE CATEGORIES) II per UL 61010-1, 2 nd Edition	
Pollution Degree	2	
Ergonomics		
View Screen	Sloped 10° for worker comfort	
Height	Adjustable stand for work surface elevations: minimum of 29 5/8" [752 mm] to 32 1/8" [816 mm] and maximum of 35 5/8" [905 mm] to 38 1/8" [968 mm]	
Armrest	Padded with EPDM sponge pad	
Knee Room	13 5/8" [346 mm] in sitting position	
Cabinet Controls	Within easy reach sitting or standing	
Materials of Construction		
Down Flow Diffuser	18 gauge, 304 Stainless Steel	
Work Chamber Weldment	16 gauge, 304 Stainless Steel	

Work Surface (Including Supports)	16 gauge, 304 Stainless Steel
All Exterior Panels	18 and 16 gauge, Carbon Steel
Positive Pressure Supply Plenum	18 and 16 gauge, Carbon Steel
Exhaust Plenum/Transition	18 and 16 gauge, Carbon Steel
Stand Frame and Supports	12 gauge, Carbon Steel
Armrest	16 gauge, 304 Stainless Steel with EPDM sponge that is resistant to UV light and most chemicals
View Screen	$\frac{1}{4}$ " [6.35 mm] thick safety plate glass with Stainless Steel edge trims
Filters	HEPA filter media with aluminum frame
Standard Features	
Armrest	Padded with EPDM sponge pad
Auxiliary Outlets	Located on the left and right sidewalls, 7A total all outlets
Cabinet Side-Walls	Under negative pressure
Cable Port	Located on the right side of unit, provides easy cable access
Down Flow Diffuser	Located below supply filter providing unidirectional air flow and a higher down flow air velocity behind the view screen
Drain Pan	With drain valve featuring secure-able handle.
Exhaust Alarm	Airflow monitor (AFM) provides audible and visual alarm of unsafe exhaust airflow conditions. The supply blower is interlocked to turn off during this alarm condition in both normal and ReadySafe™ modes.
Exhaust Collar	12" [305 mm] diameter
Filters	
Exhaust	Front loading HEPA 99.99% filtration at 0.3 microns
Supply	Front loading HEPA 99.99% filtration at 0.3 microns
High Velocity Return Air Slots	Located at the top of view screen and each end of access opening providing additional product and personnel protection
Lighting	T5 fluorescent The UV light and fluorescent light are interlocked to prevent simultaneous operation
Maintenance Access	Electrical components, lamp, blower, and supply filter easily accessible from the front of the cabinet
Membrane Switch Control Pad	Low voltage push button control of lights, blower, UV and outlets
Motor Speed Control	StediFLOW™
Plumbing	One petcock and one plug located on the right side
ReadySafe™ Mode	Reduces the total airflow and energy consumption when the cabinet is not in use. The view screen is closed and the lights are off during this mode. External output connection provided for customer interface
Sash Position Alarm	Audible and visual alarm warning of unsafe view screen opening above and below marked working access height
Supply Plenum	Provides uniform airflow to supply filter
Telescoping Air Plenum	Applies clamping force to full perimeter of supply and exhaust filter
Timers	15 minute and 1 hour increment programming for fluorescent lights, UV lights, and outlets
View Screen	Counter balanced vertically sliding, opens to 20" for moving large items in and out prior to working in the cabinet
Work Surface	One-piece stainless steel work surface
Optional Features⁴	
Auxiliary Wiring	Cabinet Monitor Wiring Package to monitor additional conditions in the unit

Cable Ports	Available on either side of unit, provides easy cable access
Enhanced Electrical System	Digital display touch pad control panel
Floor and Wall Anchors	Non-PE approved
Fume Hood Package	UL 1805 compliant. No UV light and outlets external to work area. Externally operated petcocks. Application needs to be approved by customers facility safety personnel
IV Bar	Fixed location inside work area
Low Exhaust Static Pressure Duct	Reduces the facility exhaust static pressure
Plastic Storage Bins	Add up to maximum quantity of 5
Plumbing	
Alternate Configuration	Plumbing connections can be made out of the back or to the top of either side panel
Additional Fixtures	Specify label and location(s)
Alternate Fixtures	Needle valves and greaseless needle valves Stainless steel ball valves and needle valves
Material	
Black Iron	Not NSF or UL Listed
Stainless Steel	CE mark
Pressure Monitoring	Digital Pressure Monitor with integrated alarm function
Stand with Casters	5" Diameter Casters With Locks
ULPA filters	Filtration effectivity of 99.999% for removal of most penetrating particle size (mpps) 0.1 to 0.2 microns in size.
UV Light	Operational only when viewscreen is closed. The UV light and fluorescent light are interlocked to prevent simultaneous operation.
100V, 50/60Hz	Not NSF and UL Listed
220V, 50/60 Hz	CE mark
10" [254 mm] and 12" [305 mm] working access opening	Not NSF listed
Standards and Codes	
NSF/ANSI 49 for Class II, Type B2 cabinet	
UL 61010-1, 2 nd Edition	
CAN/CSA-C22.2 No. 61010-1, 2 nd Edition	
UL 1805 (U.S. Only)	Listing for Fume Hood package
ANSI/ASHRAE 110	Listing for Fume Hood package
CE Compliance	To be done
ISO Class 5 Work Area Cleanliness	
Cleanability	
Interior Surfaces	Coved corners adjoin the work area to the rear and side walls for smooth interior surfaces
Exterior Surfaces	PermaWhite™ powder coated finish


¹ Exhaust flow rate is concurrence balance volume as defined in NSF/ANSI 49.

² Listed pressures include 0.7" W.C. [174 Pa] for filter loading over time per NSF/ANSI 49.


³ Based on clean filters.

⁴ NSF and UL Listed unless otherwise noted.



REV	DESCRIPTION	DATE	DRN	APP-BY	APP-DATE
A	ORIGINAL RELEASE	-	-	-	-

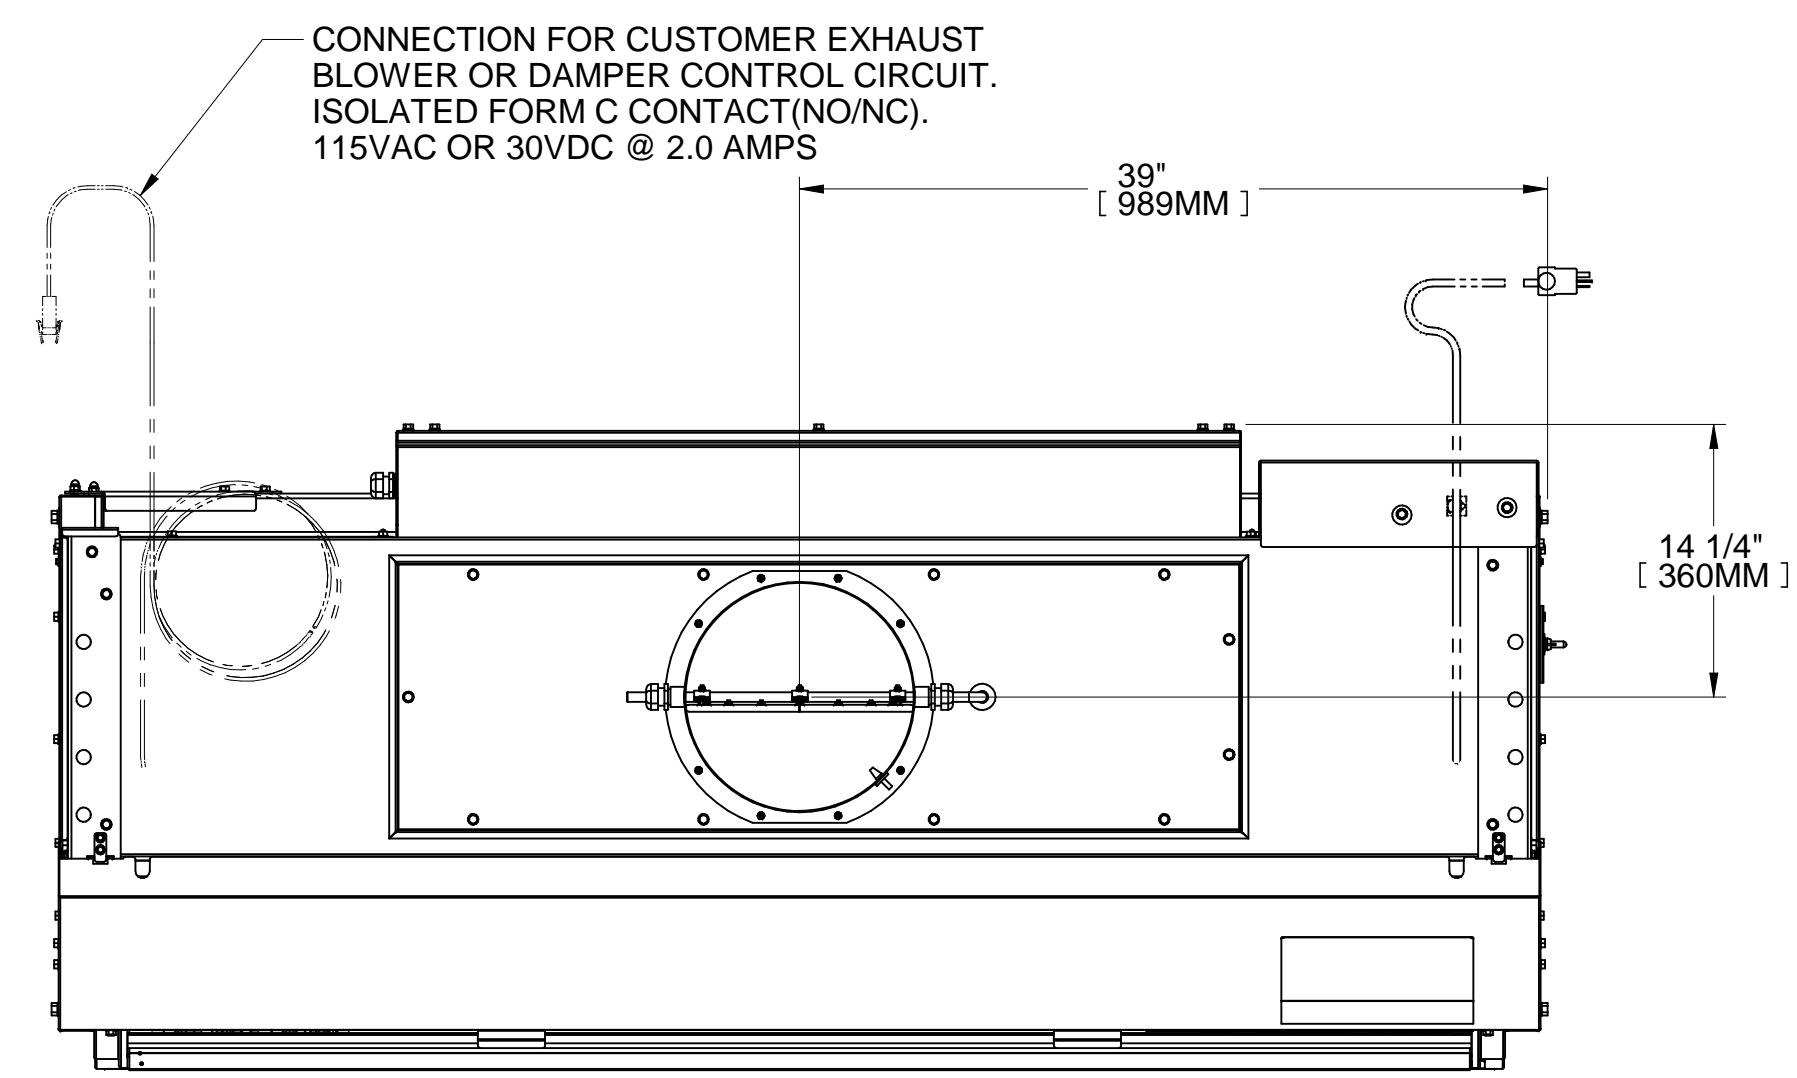

- NOTES:**
- ELECTRICAL REQUIREMENTS: 115 VAC, 20 AMP, 60 HZ, SINGLE PHASE
 - CONSTRUCTION:
WORKSURFACE/WORK AREA - 16 GA.[1.5 MM] 304 SS, #4 FINISH
ACCESS PANELS - 16 GA.[1.5 MM] & 18 GA.[1.2 MM] C.R.S. WITH A BAKER PERMA WHITE POLYESTER HYBRID POWDER COAT FINISH
 - SUPPLY FILTER, MOTOR, BLOWER AND ALL ELECTRICAL COMPONENTS ARE FRONT ACCESSIBLE.
 - PETCOCKS RECOMMENDED FOR USE WITH NONFLAMMABLE GAS, AIR OR VACUUM
 - PLUMBING CONFIGURATION IS FACTORY ASSEMBLED AND TESTED AT 100 P.S.I.. MAXIMUM WORKING PRESSURE IS 30 P.S.I..
- PLEASE ADVISE OF ANY SPECIAL PLUMBING REQUIRED BY LOCAL PLUMBING CODES
- CABINET PLUMBING CONNECTORS ARE 3/8[9.5 MM] SWAGELock FITTINGS. A 3/8 [9.5 MM]NPT ADAPTER IS SHIPPED WITH THE CABINET
 - EXHAUST FILTERS ARE ACCESSIBLE THROUGH THE CABINET WORK AREA OPENING LOCATED DIRECTLY UNDER THE WORK SURFACE

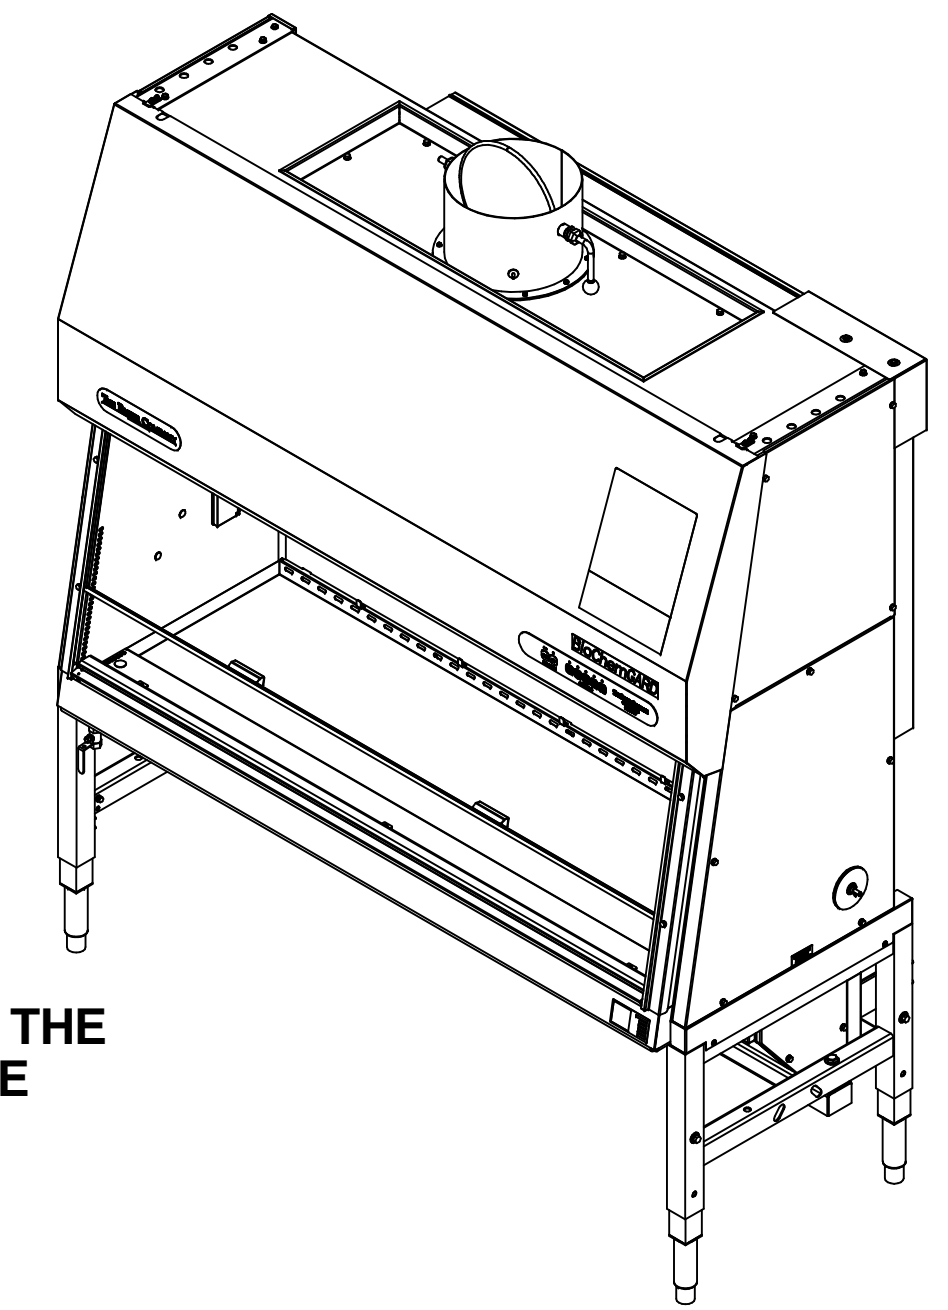

NOTE: REFER TO THE LATEST VERSION OF 372D066 FOR THE EXHAUST REQUIREMENTS FOR THE BCG601 WITH THE 12" [305MM] DIA EXHAUST CONNECTION

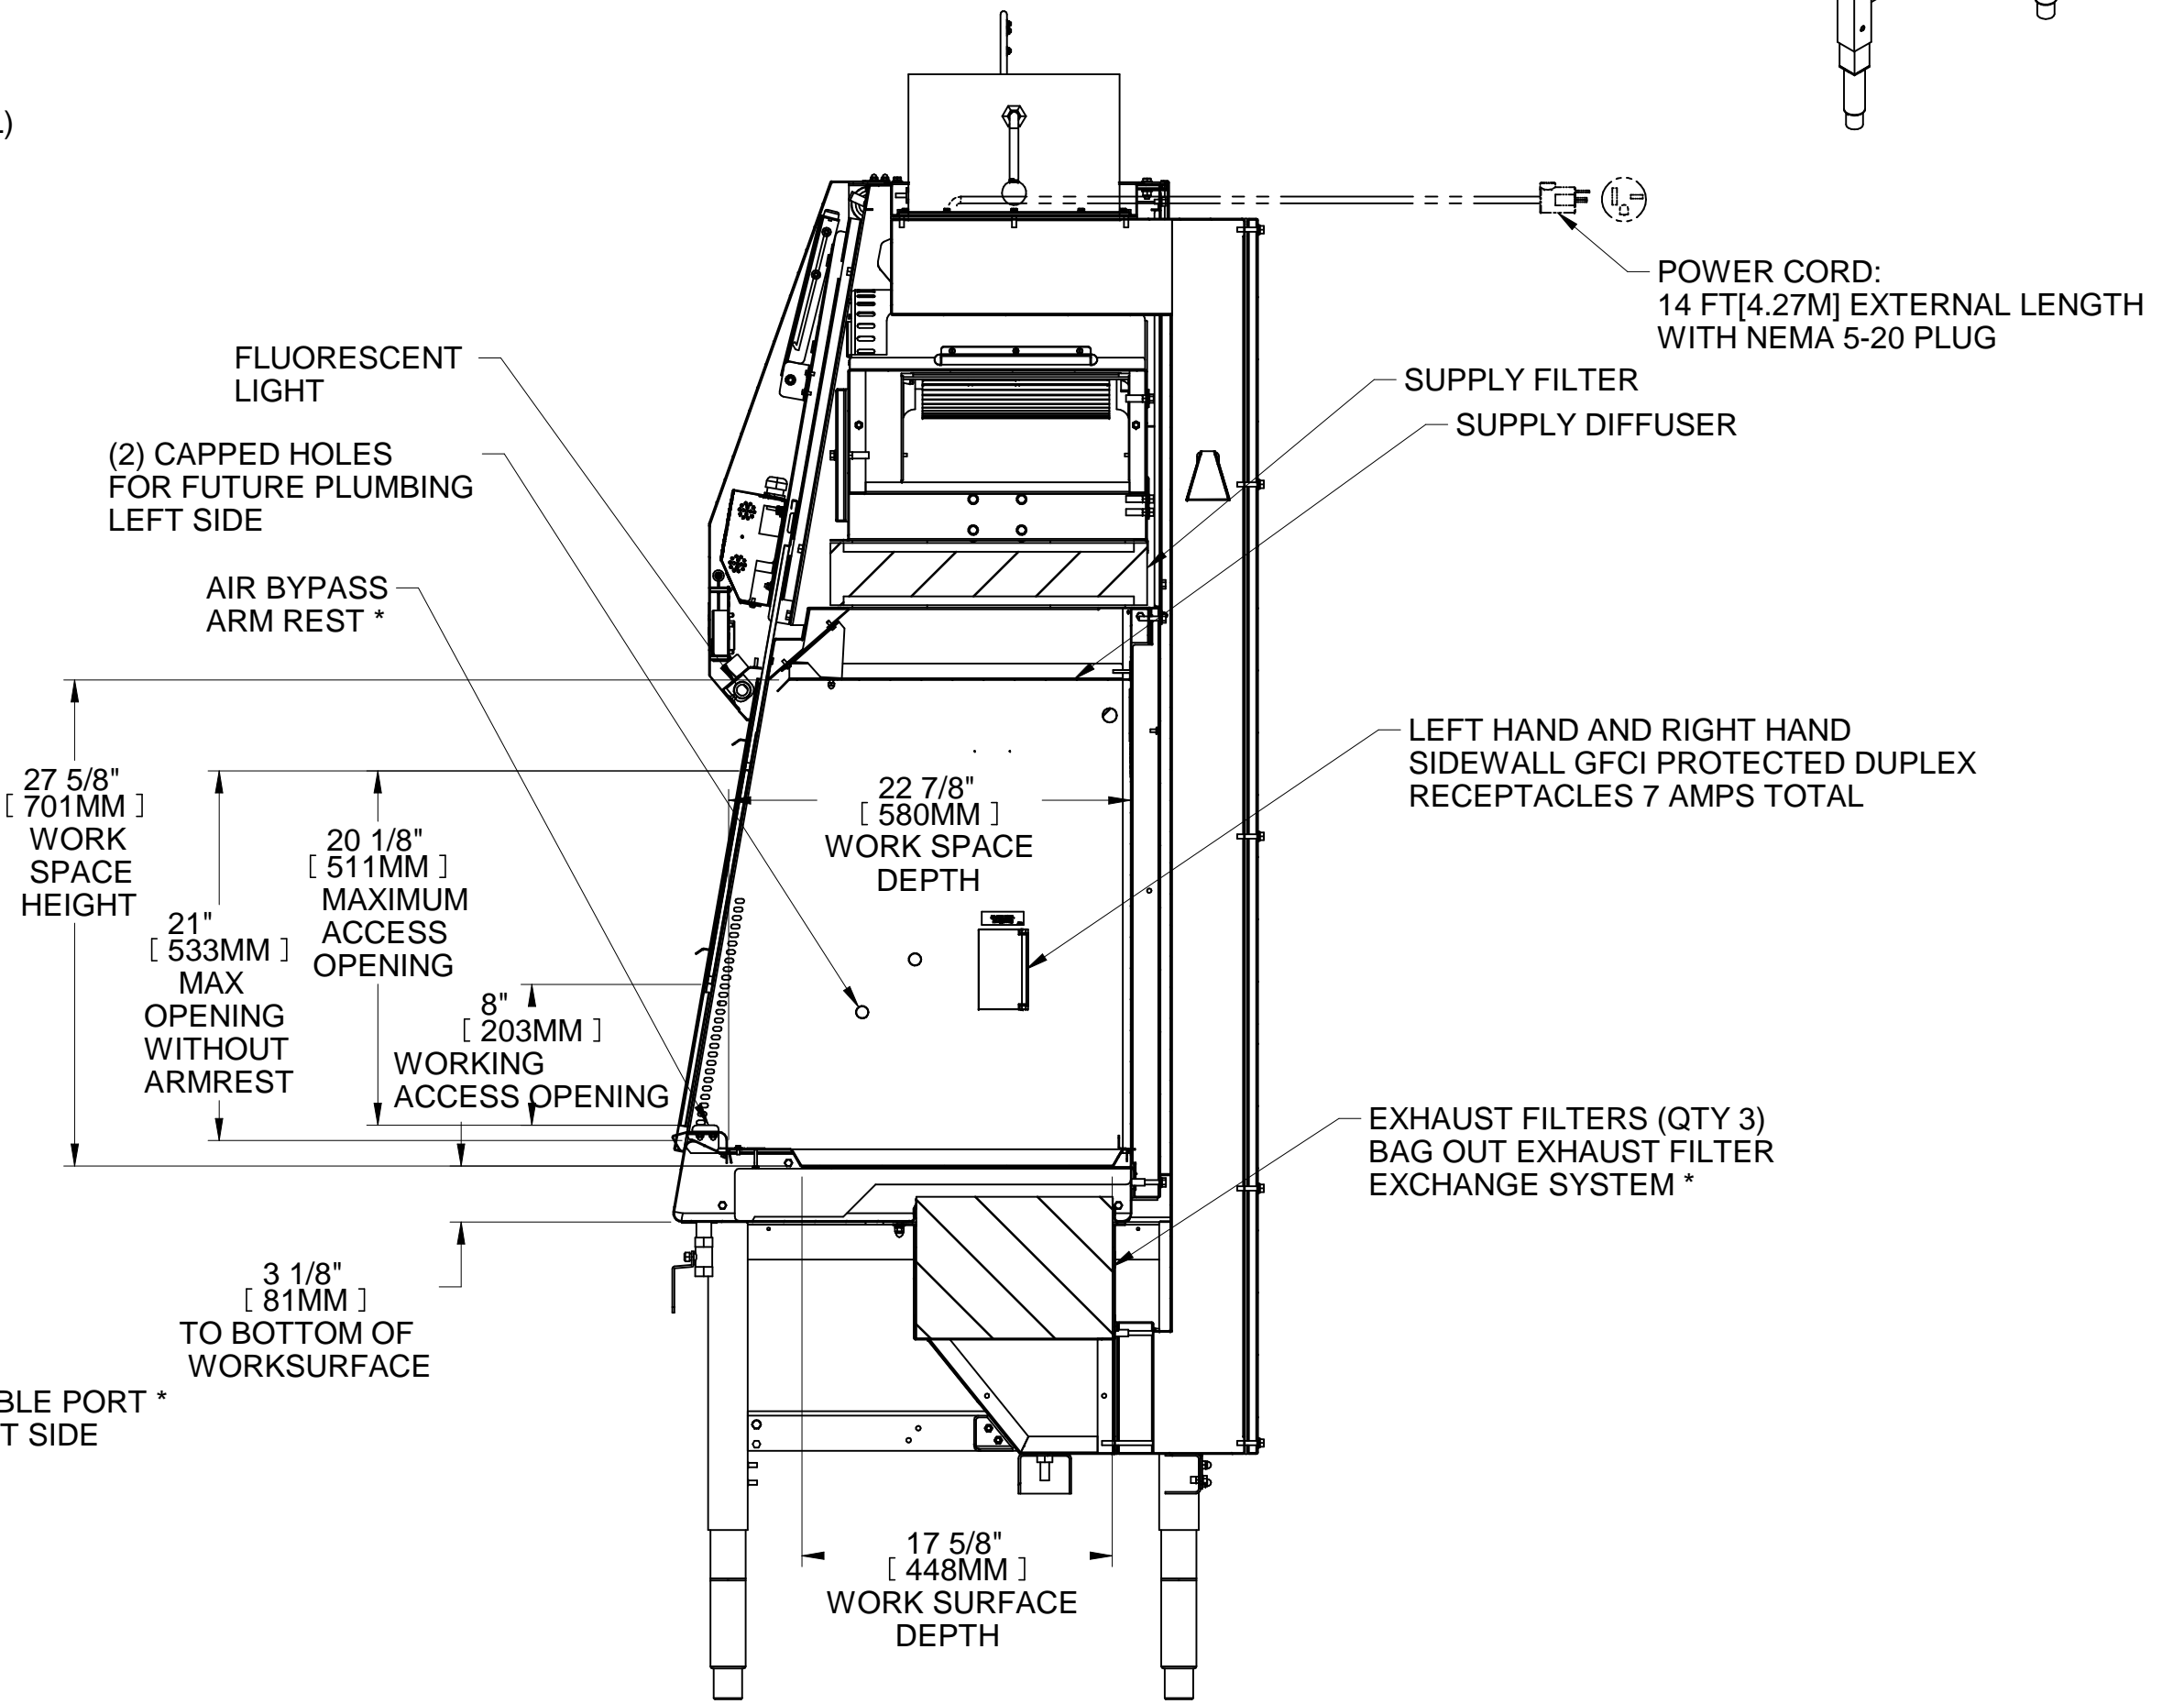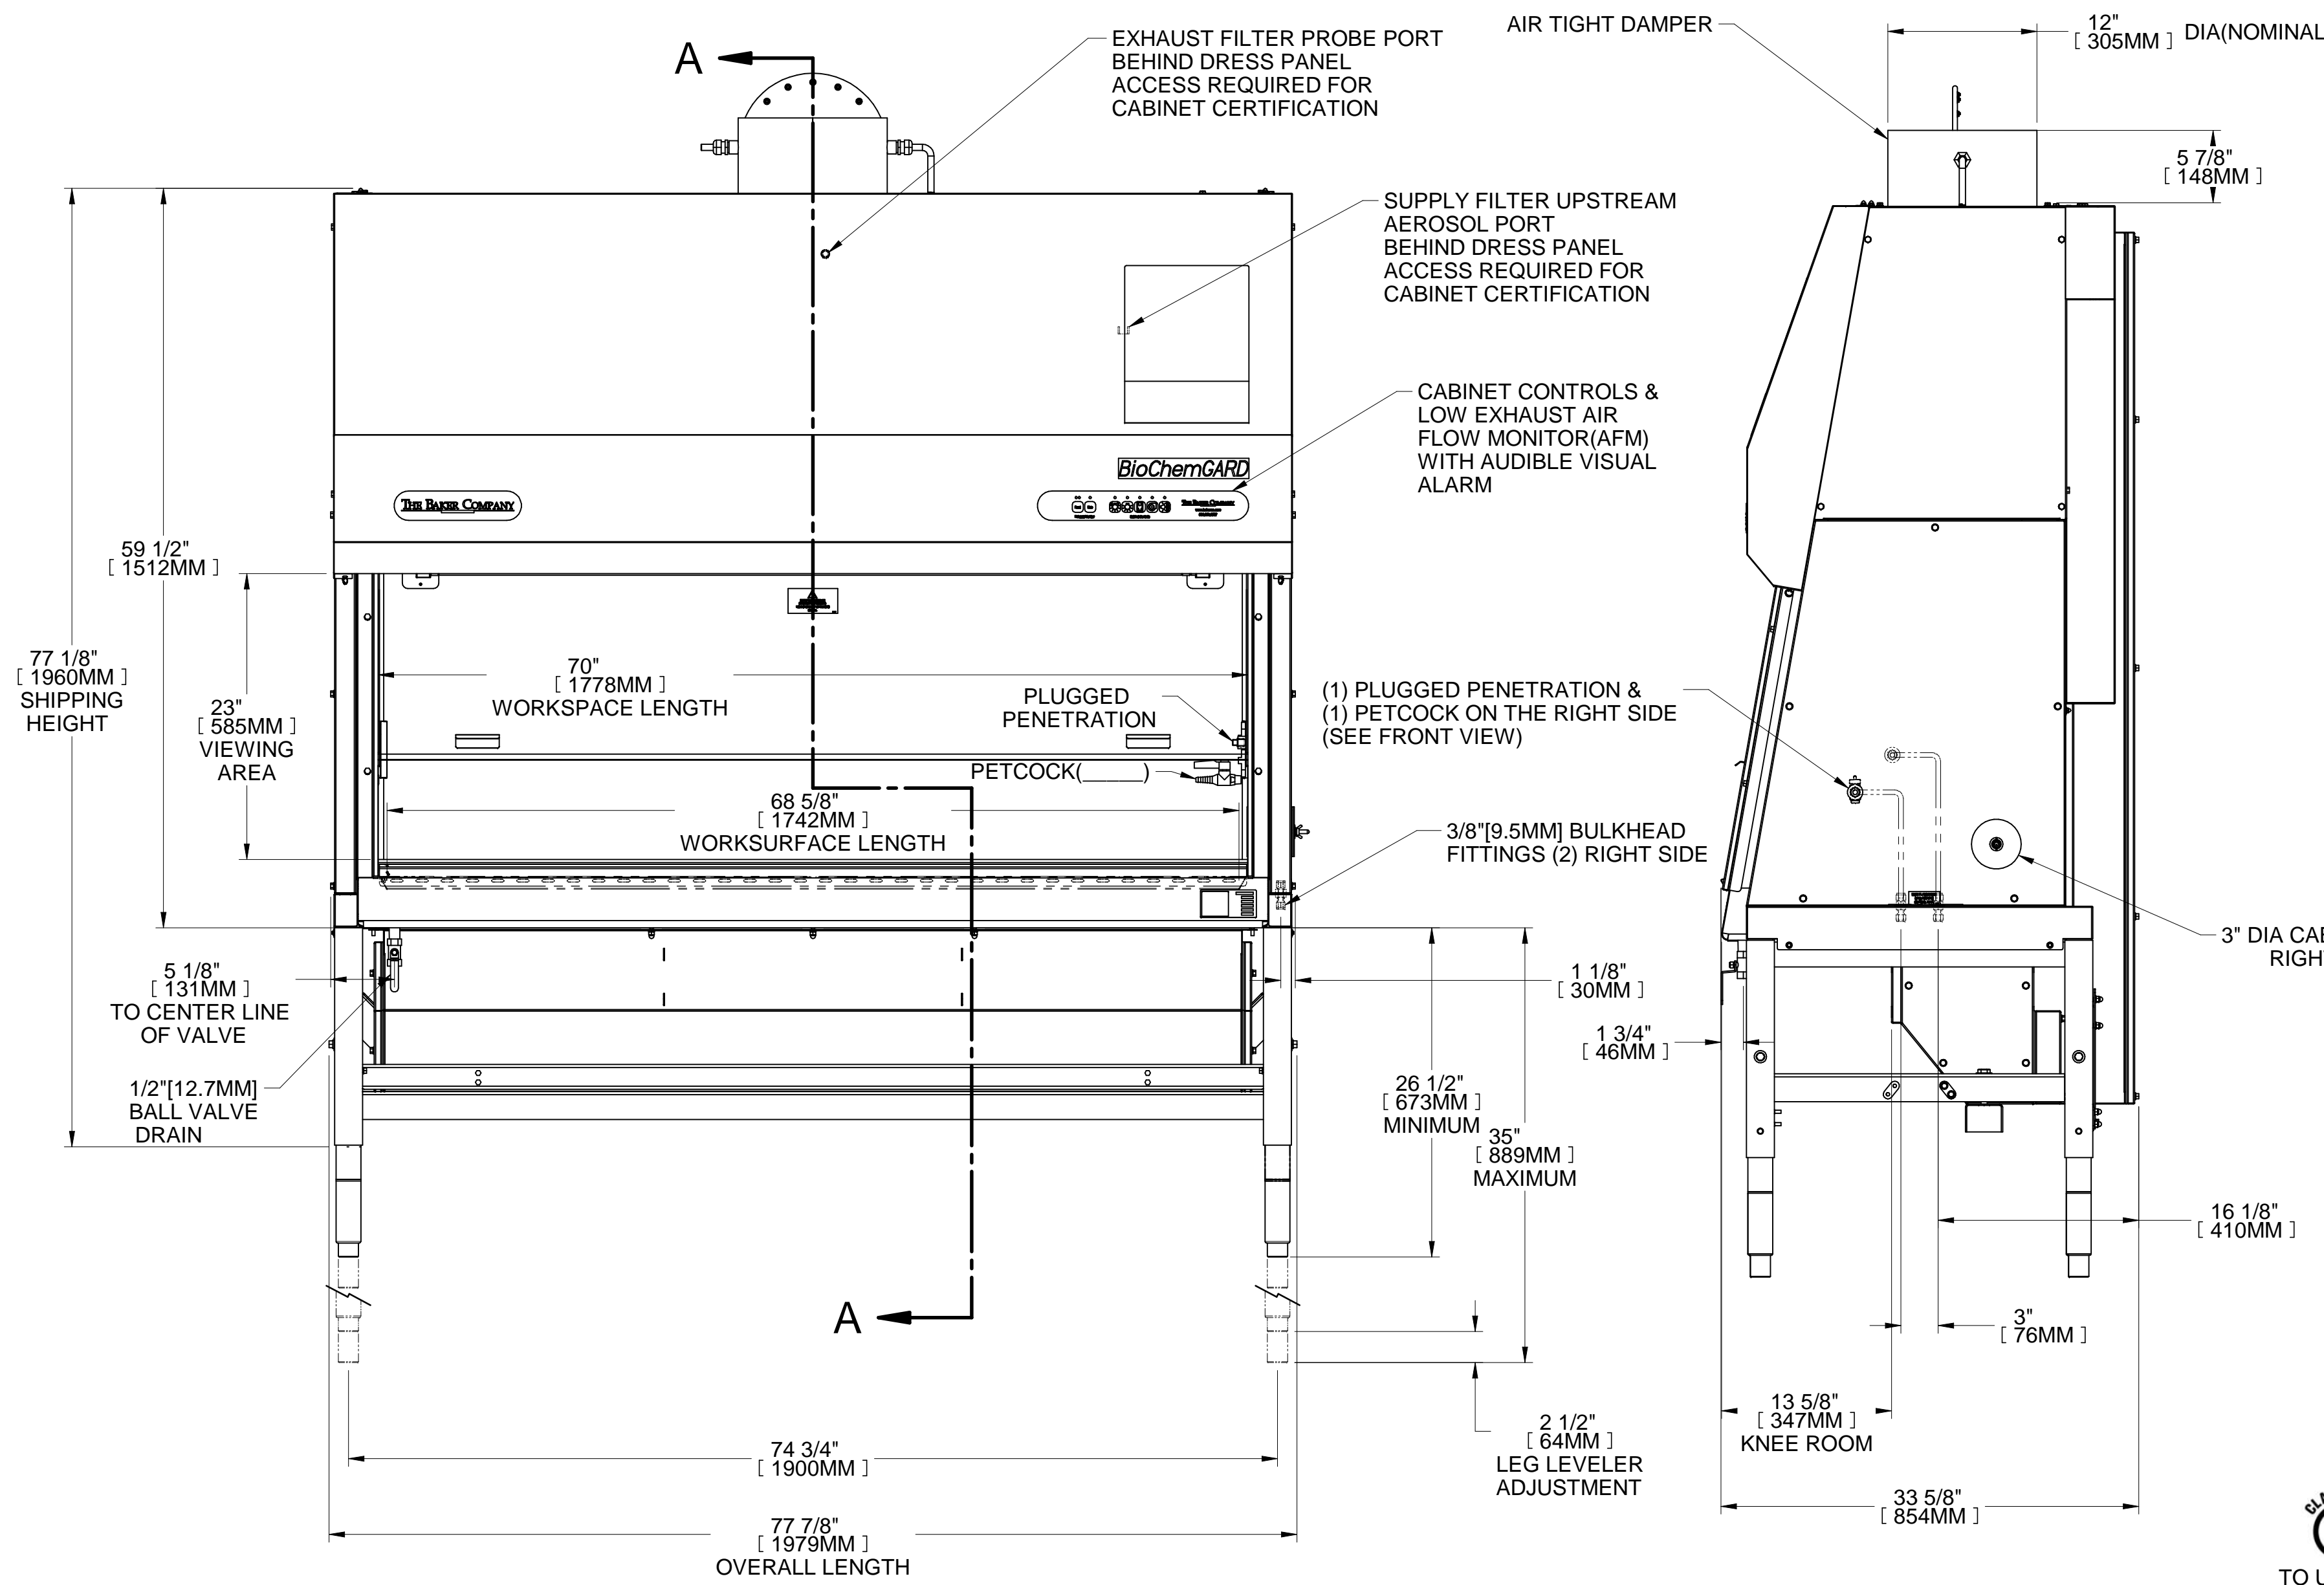

SECTION A-A

STANDARD UNIT WEIGHT = 850 LBS[386 KG]



*** = PATENT PENDING**

OPTION #	OPTION DESCRIPTION	QTY
25A	AIR TIGHT DAMPER - 12 INCH DIAMETER	1

UNLESS OTHERWISE SPECIFIED		PROPERTY OF THE BAKER COMPANY. THE INFORMATION CONTAINED HEREON MAY NOT BE USED OR COPIED IN ANY MANNER WITHOUT THE WRITTEN PERMISSION OF THE BAKER COMPANY.		THE BAKER COMPANY 161 Goshen Rd., Sanford, Maine 04073 USA *Controlled Atmosphere Environment*	
<p>BioChemGARD e3 BCG601 CLASS II TYPE B2</p>					
<p>DECIMALS MACHINED SHEET METAL ANGULAR X ±.02 ±.06 ±90°(15) XX ±.01 ±.03 ±THD ANGLE FRACTIONS ±1/32 ±.010 FINISH: 125 NO. 4 PROJECTION</p>	<p>DATE: 8/11/2011</p>	<p>DATE: 8/11/2011</p>	<p>SCALE: -</p>	<p>SHEET: -</p>	<p>REV: A</p>
<p>DESIGN: C.W.Q., JR.</p>	<p>DATE: 8/11/2011</p>	<p>DATE: 8/11/2011</p>	<p>SCALE: -</p>	<p>SHEET: -</p>	<p>REV: A</p>
<p>BGA-BCG601-B2-25A</p>					